


Notes:

All dimensions are in millimetres unless stated otherwise. No dimensions to be scaled from drawings. All dimensions to be checked on site prior to manufacture.

Any discrepancies between drawings and site conditions are to be reported to the contract manager.

This drawing is to be read in conjunction with all relevant Structural Engineers and Mechanical & Electrical Engineers drawings and specification.

Copyright of this drawing and all the information it contains is the sole property of OEA and may not be reproduced or used for any purpose without the express approval of the authors

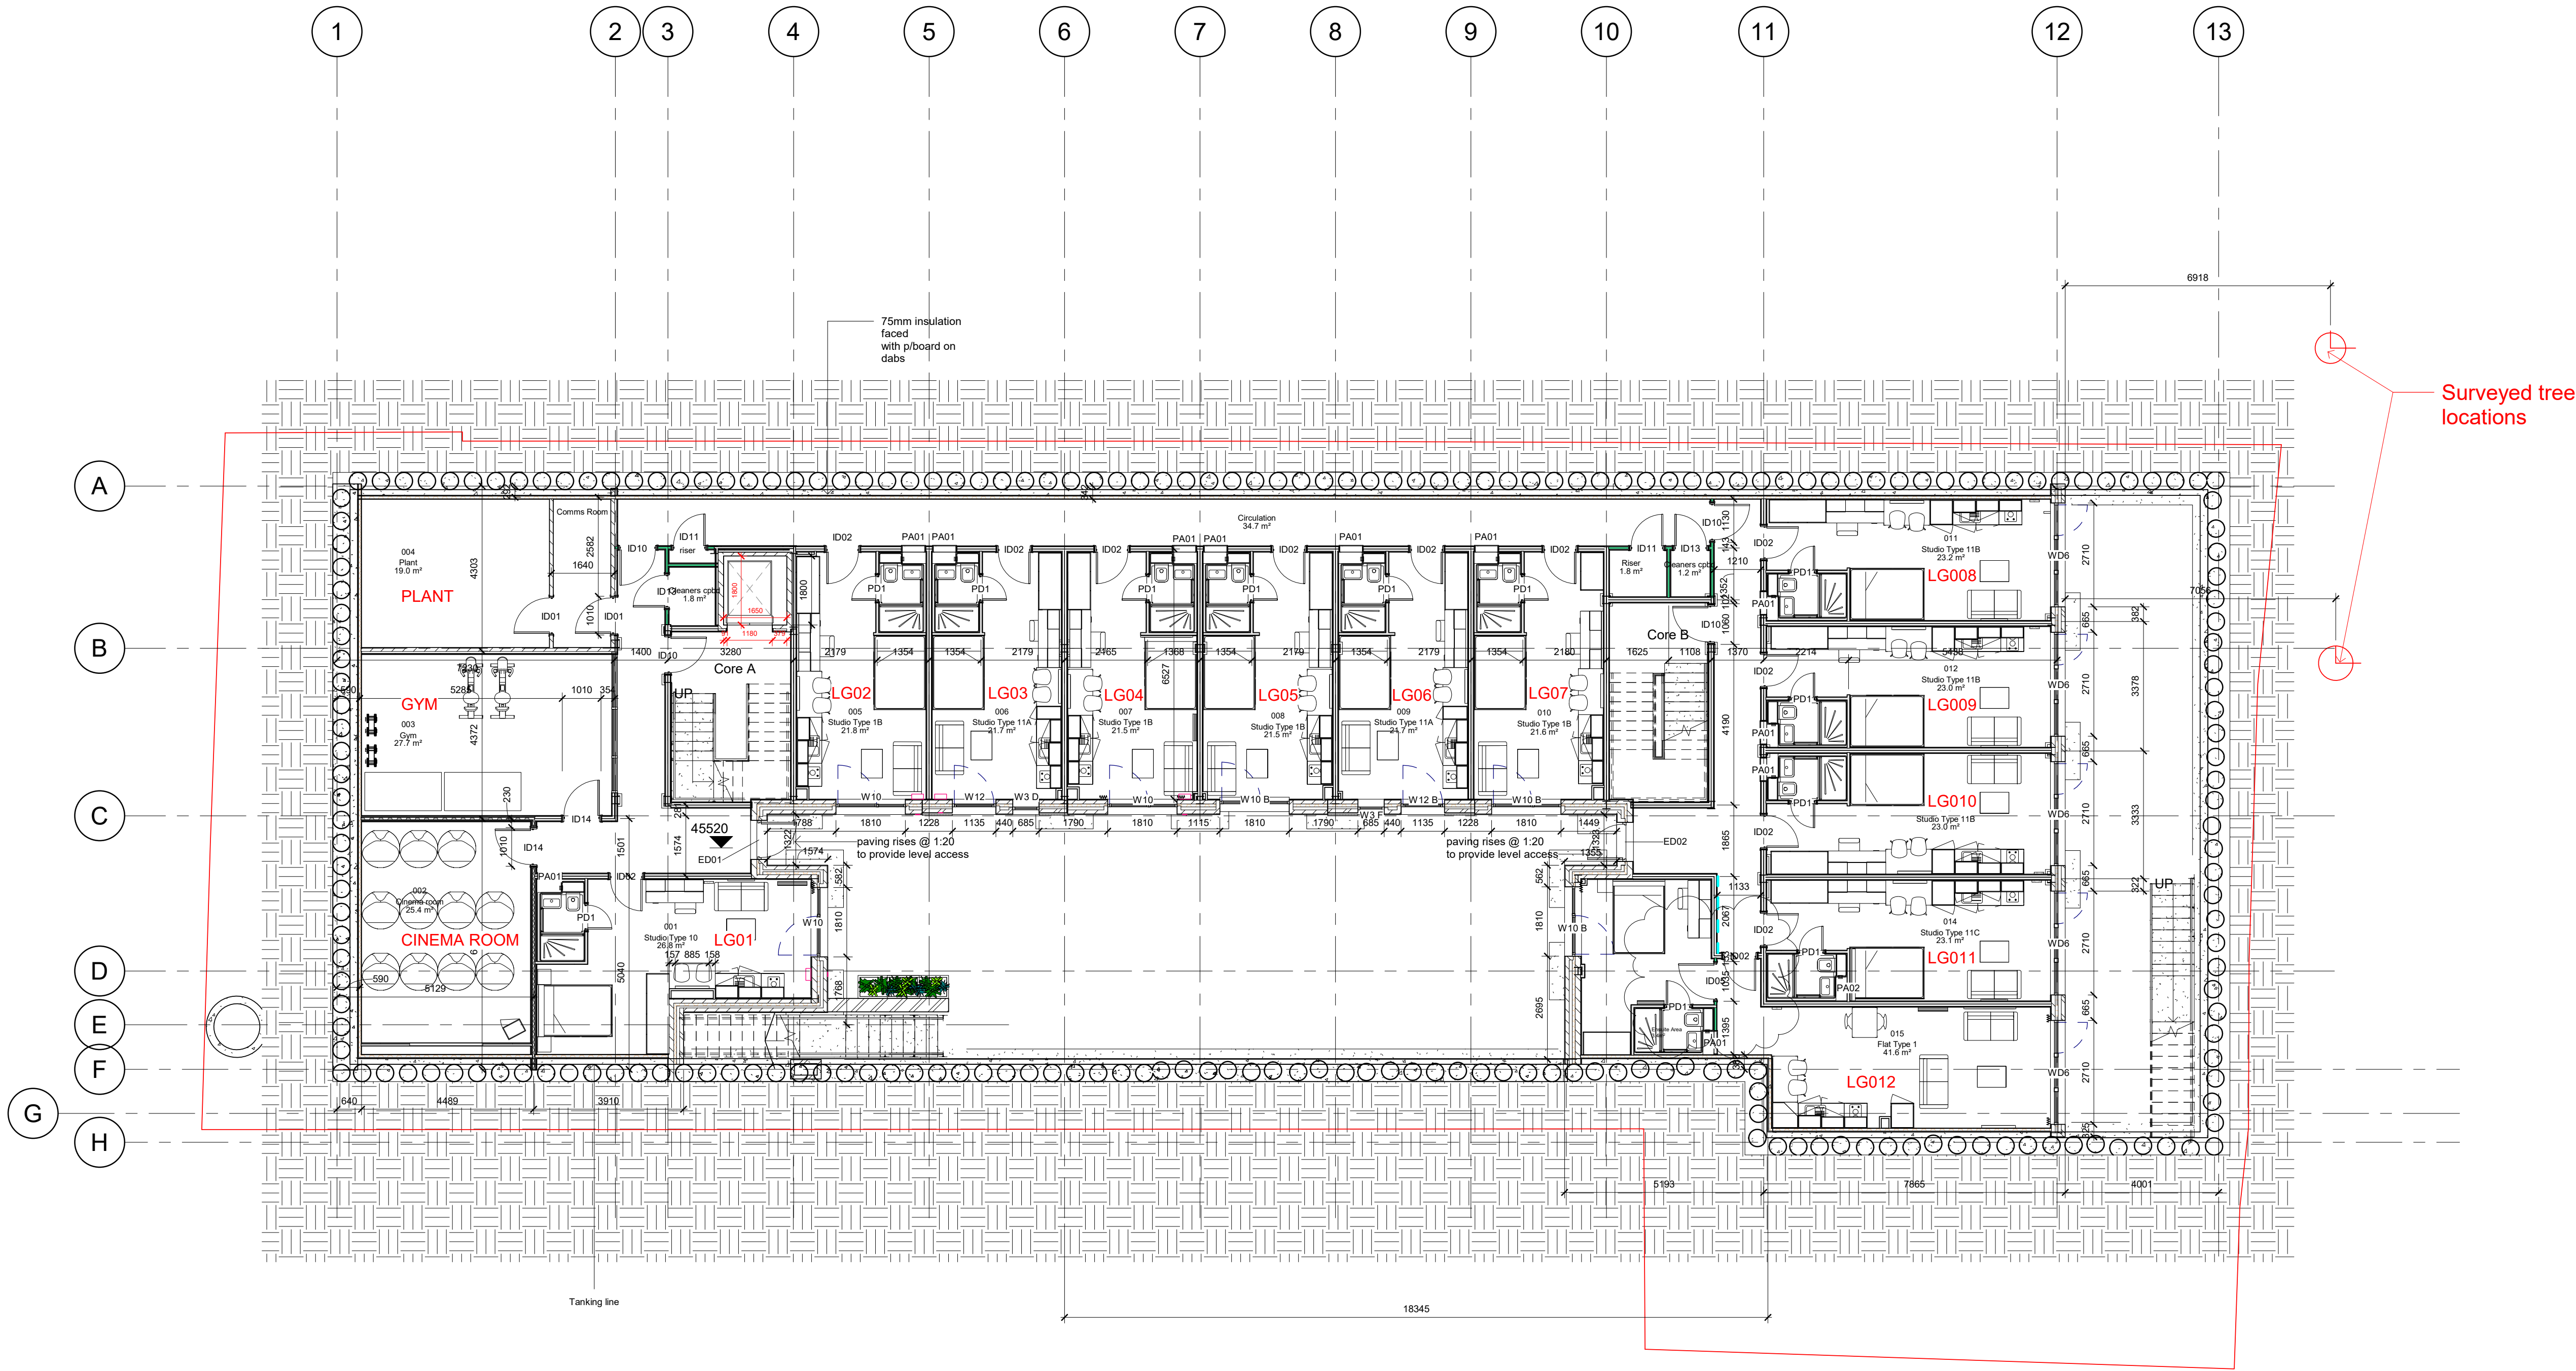

LG01 - PRESTIGE ROOM NUMBERS

Surveyed tree locations

dwg status:

FINAL CONSTRUCTION

QQ	Prestige room numbering added	23/12/20	GE	
PP	Final Construction Issue	25/09/20	IW	
NN	Rooms layout updated inline with drainage as built on site	10/07/20	IW	
MM	Sonar locations updated in line with Basc drawings where possible. NOTE - some Basc setting out unachievable reflect to vent setting out elevations for details	26/06/20	IW	
LL	Door to flat type 1 updated to accords comments	07/05/20	IW	
KK	Comms room location added	07/04/20	IW	
JJ	Minor updates inc circulation doors updated	31/03/20	IW	
HH	Grid line 1 moved to match WL GL setting out	03/09/19	IW	
GG	Updated and issued for construction	20/09/19	IW	
FF	Wall buildup altered to 100mm blockwork	14/08/19	IW	
EE	Capping beam along GL 11 relocated inline with as built position as informed by TWC	30/07/19	IW	
DD	Lift dimensions updated to those supplied by TWC 03/07/19 Schindler 330	04/07/19	IW	
CC	Grid lines updated in line with WL	26/06/19	IW	
BB	Room Types Updated	11/06/19	IW	
AA	FR glazing introduced to gym/corridor partition	20/05/19	IW	
Z	Pods updated to Walker Modular K1 at client request, drainage relocated where necessary. Internal blockwork walls altered to drylining, updated steel support by SE imported, 72 room layouts updated where required to accommodate new pod type	22/05/19	IW	
Y	Piling location updated and coordinated with WL model	05/04/19	IW	
X	General Update	03/04/19	IW	
W	FR glazing omitted	20/11/18	IW	ES
V	General update, change in construction method - tender Issue	29/10/18	IW	ES
U	Updated	03/09/18	IW	
T	Updated to midas comments	16/08/18	AH	
S	Stat Core B shifted	13/08/18	IW	
R	General updates	18/07/18	AH	
Q	RWP locations updated	05/07/18	IW	
P	Gridlines Updated	08/06/18	PO	
N	Status updated to Preliminary	29/05/18	IW	
M	Reconfigured gym and cinema room	15/05/18	AH	
L	Updated to client comments, issued for NMA	11/05/18	IW	
K	Updated to comments	21/03/18	AH	
J	Studio windows widened	19/03/18	IW	
H	Substation omitted	13/03/18	IW	
G	Update to Clients Comments	02/03/18	IW	
F	Scale bar added to sheet	27/02/18	IW	
E	Tender Issue	23/02/18	IW	
D	5 No. studios and external space added to L-1	02-08-17	SJ	
C	Schedule Amended	07-08-17	JH	
B	Frontage updated to Highways Engineer	18-07-17	JH	
A	Revised Parking Issue	10-07-17	JG	
Rev	Description	Date	By	Chk

Silver Street 79 LLP

oea

oconnell east architects
63 Newton Street, Manchester, M1 1ET
t: 0161 559 5360 f: 0161 833 1638

dwg title:	GA Plans_Lower Ground Floor		
job title:	79 Silver Street, Reading		
scale:	1 : 100	@ A1	drawn: IW
date:	29/10/18	job no:	1609
dwg no:	1609_20_100	rev:	QQ

GA Plan_Level-1

1 : 100

SONAIR PLACEMENT IN PINK