

Notes:

All dimensions are in millimetres unless stated otherwise. No dimensions to be scaled from drawings. All dimensions to be checked on site prior to manufacture.

Any discrepancies between drawings and site conditions are to be reported to the contract manager.

This drawing is to be read in conjunction with all relevant Structural Engineers and Mechanical & Electrical Engineers drawings and specification.

Copyright of this drawing and all the information it contains is the sole property of OEA and may not be reproduced or used for any purpose without the express approval of the authors

Studio Schedule Level 2	
Name	Count

Studio Type 1	2
Studio Type 2	1
Studio Type 2B	2
Studio Type 3	2
Studio Type 4	1
Studio Type 5	1
Studio Type 7	1
Studio Type 11A	1
Studio Type 11D	2
Studio Type 13	1
Grand total	14

201 - PRESTIGE ROOM NUMBERS

dwg status:

FINAL CONSTRUCTION


EE	Prestige room numbering added	23/12/20	GE	
DD	Final Construction Issue	25/09/20	IW	
CC	Rooms layout updated inline with drainage as built on site	10/07/20	IW	
BB	Sonair locations updated in line with Bec drawings where possible. NOTE - some Bec setting out unachievable reflect to vent setting out elevations for details	26/06/20	IW	
AA	Minor updates inc circulation doors updated ID10, all Sonair shown where possible	31/03/20	IW	
Z	Updated in line with NMA to rear roof pitch CW10 omitted replaced with 1no. W2 window	19/12/19	IW	
Y	Construction Issue	Date 199	IW	
X	Grid line 1 moved to match WL GL setting out	03/09/19	IW	
W	Wall buildup altered to 100mm blockwork	14/08/19	IW	
V	Pod rotated to ST13 - drainage updated.	14/08/19	IW	
U	Lift dimensions updated to those supplied by TWC 03/07/19 Schindler 330	04/07/19	IW	
T	Grid lines updated in line with WL	26/06/19	IW	
S	Room types updated	11/06/19	IW	
R	Pods updated to Walker Modular K1 at client request, drainage relocated where necessary, internal blockwork walls altered to drying, updated steel support by SE imported, 72_room layouts updated where required to accommodate new pod type	22/05/19	IW	
Q	Level 2, studio type 11 altered to studio type 11C, pods rotated drainage updated, room doors moved to match.	03/05/19	IW	
P	Updated following approved planning amendment to reduce no. of windows to elevation and alter to render	20/11/18	ES	
N	General update, change in construction method - tender issue	29/10/18	ES	
M	Updated	03/09/18	IW	
L	Updated to midas comments	16/08/18	AH	
K	Stair Core B shifted	13/08/18	IW	
J	FR window, RWP, AVOs updated	11/07/18	IW	
H	Gridlines Updated	08/06/18	PO	
G	Status Updated to Preliminary	29/05/18	IW	
F	Updated to client comments, issued for NMA	11/05/18	IW	
E	Updated to comments	21/03/18	AH	
D	Update to Clients Comments	02/03/18	IW	
C	Tender Issue	23/02/18	IW	
B	5 No. studios and external space added to L-1	02-08-17	SJ	
A	Revised Parking Issue	10-07-17	JG	
Rev	Description	Date	By	Chk

Silver Street 79 LLP

oea

oconnell east architects
63 Newton Street, Manchester, M1 1ET
t. 0161 559 5360 f. 0161 833 1638

dwg title:	GA Plans_2nd Floor		
job title:	79 Silver Street, Reading		
scale:	1 : 100	@ A1	drawn: IW
date:	29/10/18	job no:	1609
dwg no:	1609_20_103	rev:	EE

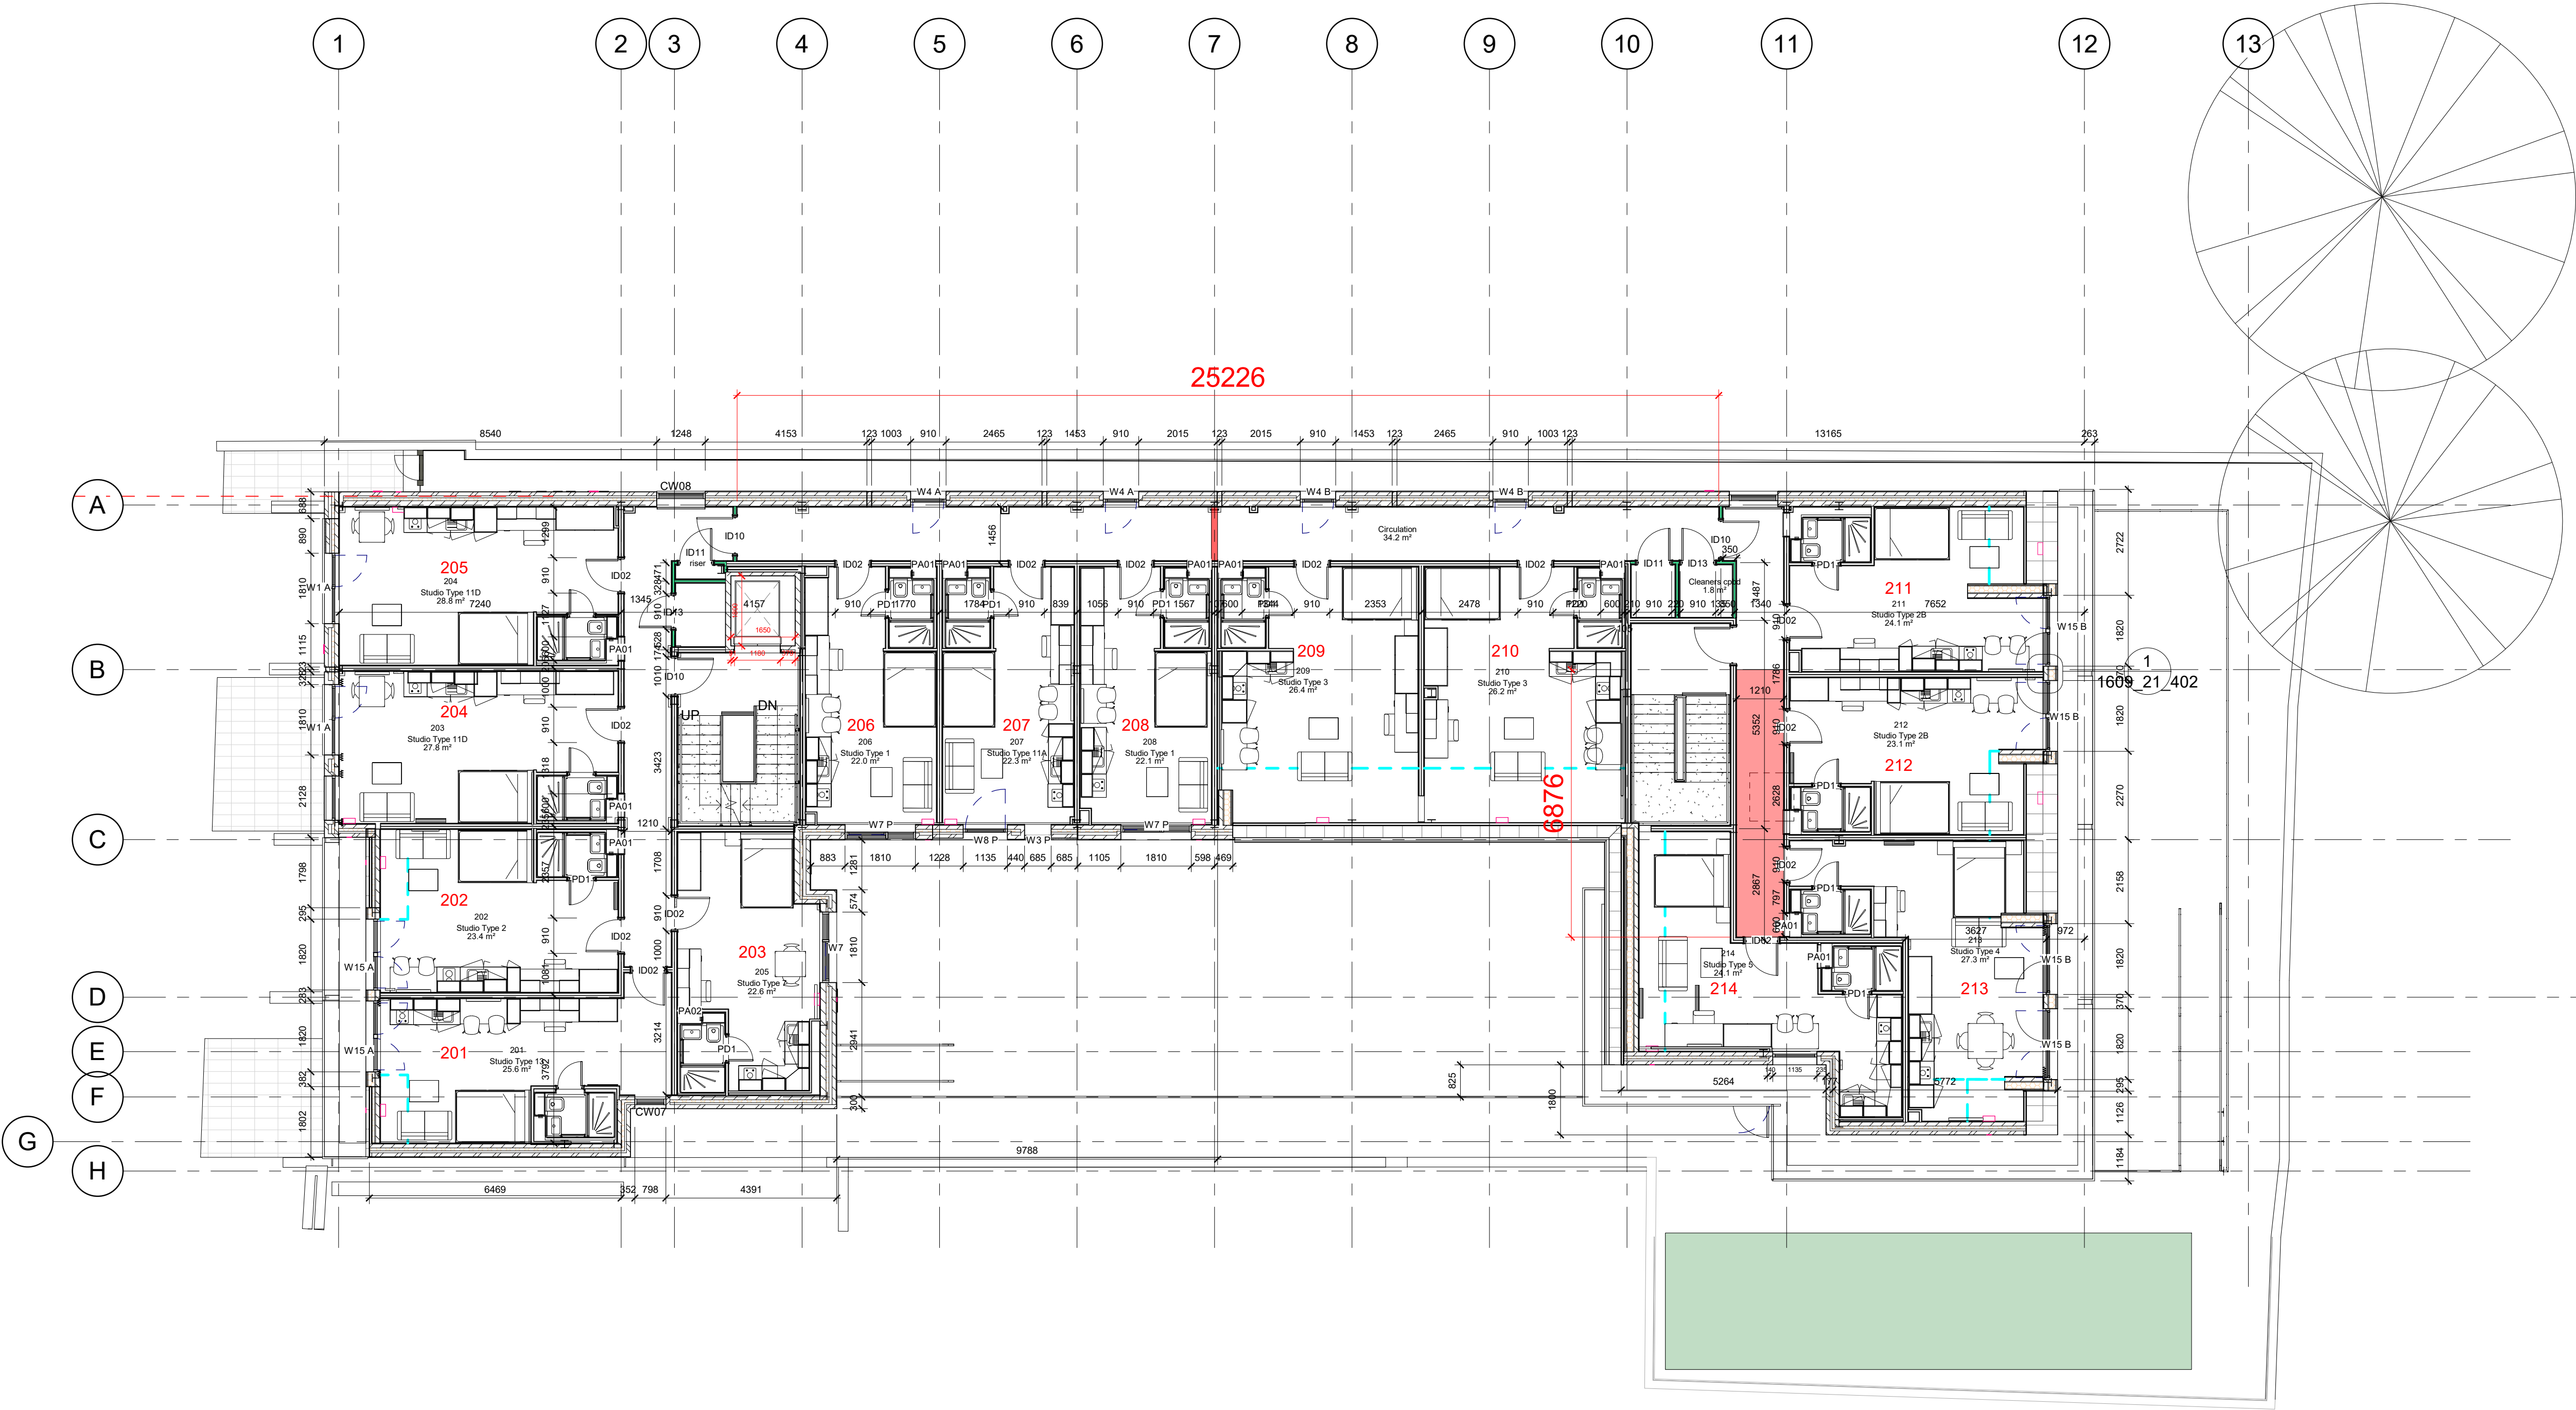

GA Plan_Level 2
1 : 100

SONAIR PLACEMENT IN PINK