
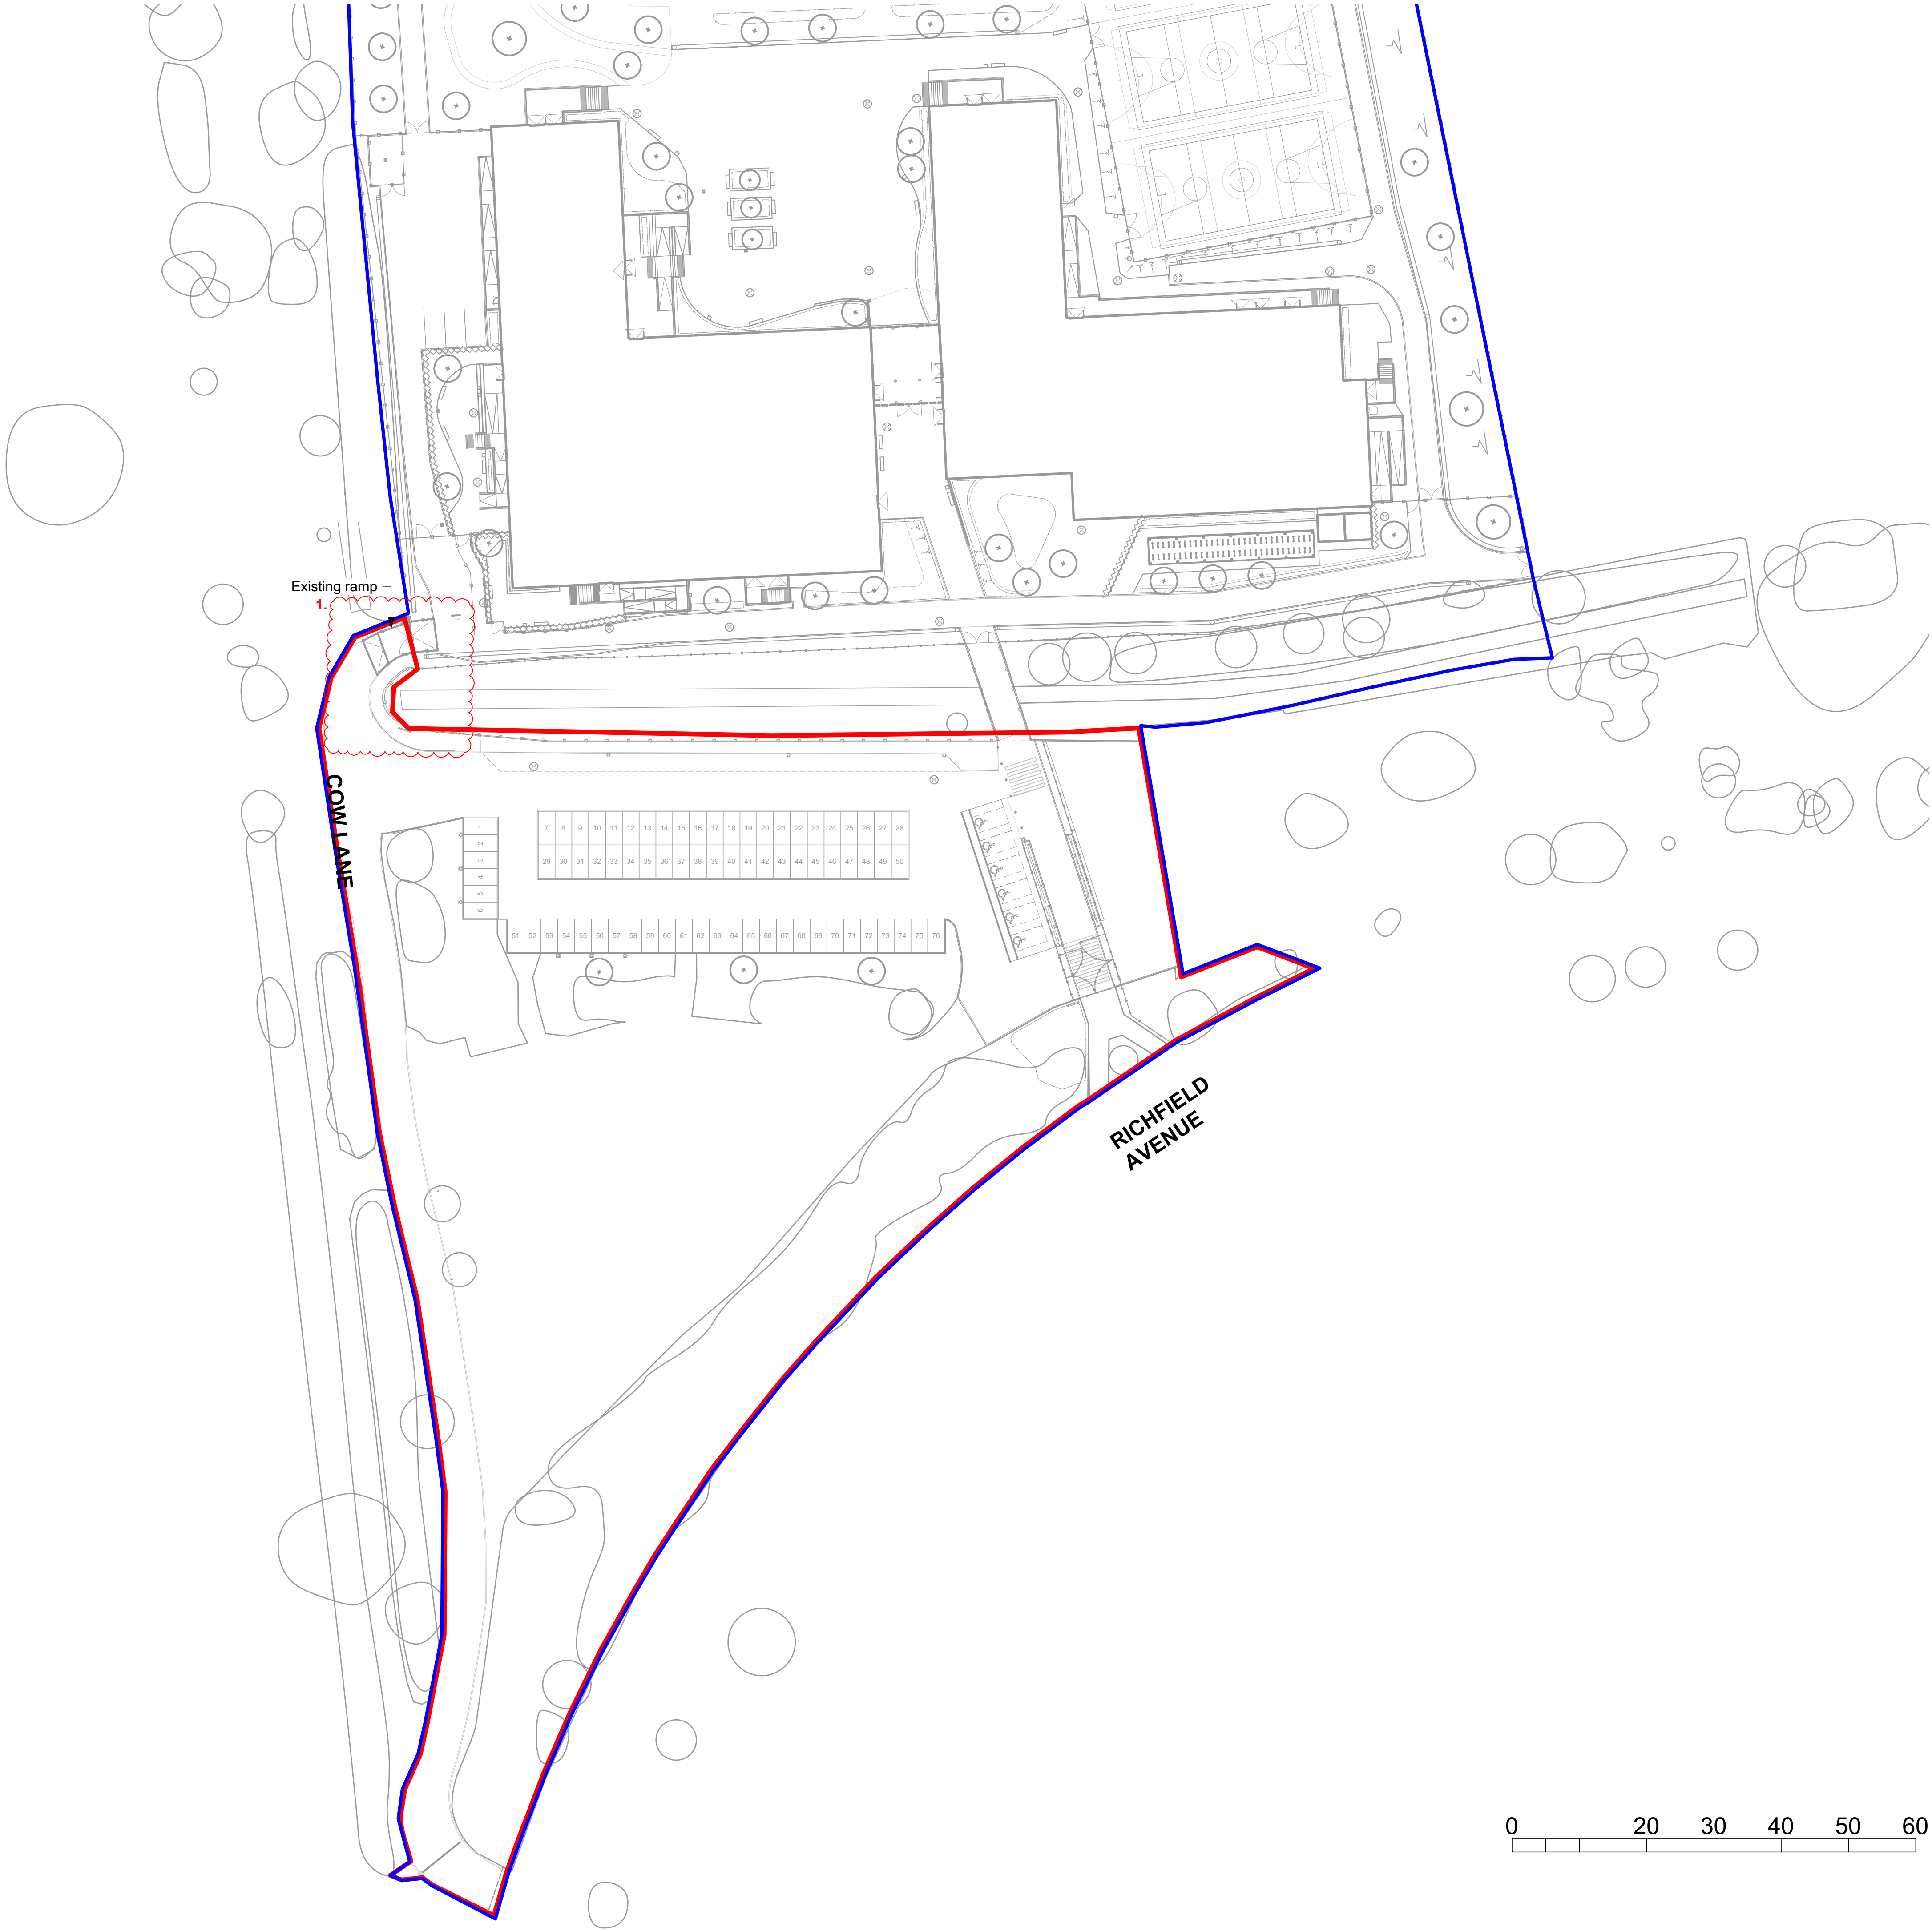


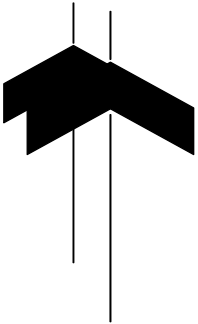

- KEY
- Application Boundary
 - Whole Site Boundary

P03	24/07/2026	1. Red line application boundary adjusted to include proposed Weldmesh Fence
P02	17/04/2026	Scale updated to 1:500 to show red line boundary extents. Boundaries updated
REV	DATE	DESCRIPTION

RESIDUAL PROJECT RISK

Refer to the Hazard Identification drawings, Project Risk Register, and Risk Assessment Documents.

CLIENT



CONTRACTOR



CONSULTANT

ALA



PROJECT

River Academy

DRAWING TITLE

Existing Site Plan

STATUS - DRAWING PURPOSE

S3 - PLANNING

DRAWN BY	DATE	CHK'D BY	SCALE	MEDIA
AT	27/01/2026	BH	1:500	A1
DEIR REFERENCE		OS LICENCE REFERENCE		

PROJECT - ORIGINATOR - ZONE - LEVEL - TYPE - ROLE - NUMBER	REVISION
FS0949-ALA-XX-ZZ-DR-L-0061	P03