


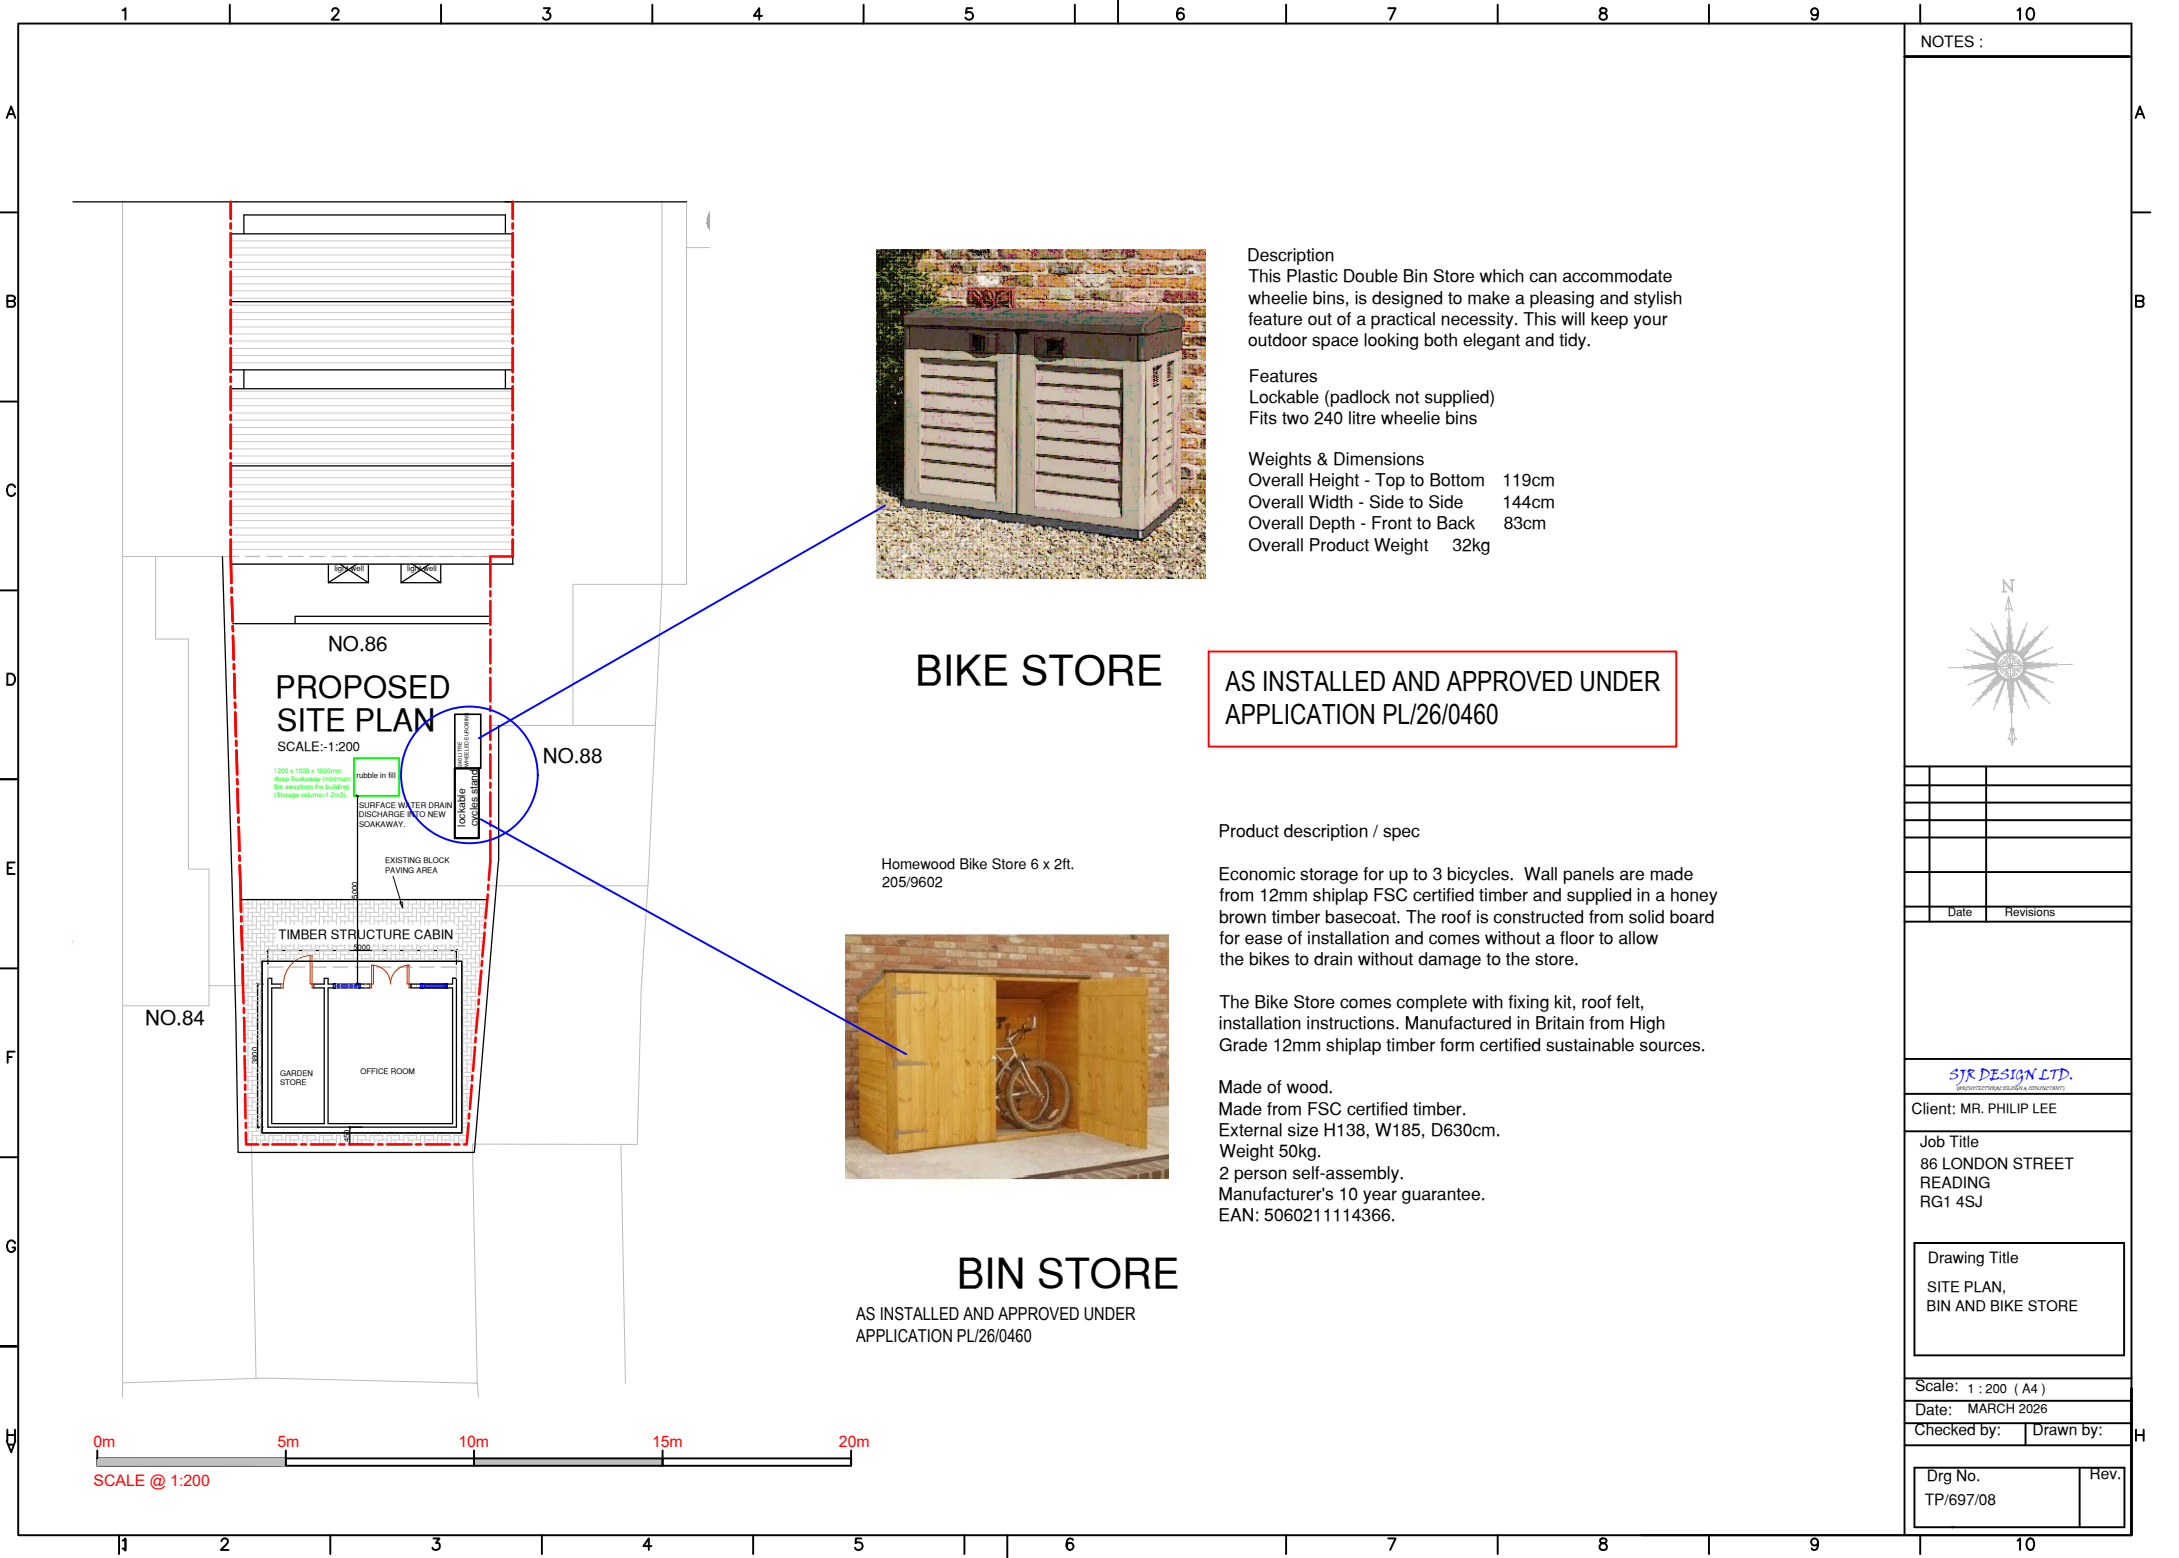

Description
This Plastic Double Bin Store which can accommodate wheelie bins, is designed to make a pleasing and stylish feature out of a practical necessity. This will keep your outdoor space looking both elegant and tidy.

Features
Lockable (padlock not supplied)
Fits two 240 litre wheelie bins

Weights & Dimensions
Overall Height - Top to Bottom 119cm
Overall Width - Side to Side 144cm
Overall Depth - Front to Back 83cm
Overall Product Weight 32kg

BIKE STORE

AS INSTALLED AND APPROVED UNDER
APPLICATION PL/26/0460

Homewood Bike Store 6 x 2ft.
205/9602



Product description / spec

Economic storage for up to 3 bicycles. Wall panels are made from 12mm shiplap FSC certified timber and supplied in a honey brown timber basecoat. The roof is constructed from solid board for ease of installation and comes without a floor to allow the bikes to drain without damage to the store.


The Bike Store comes complete with fixing kit, roof felt, installation instructions. Manufactured in Britain from High Grade 12mm shiplap timber from certified sustainable sources.

Made of wood.
Made from FSC certified timber.
External size H138, W185, D630cm.
Weight 50kg.
2 person self-assembly.
Manufacturer's 10 year guarantee.
EAN: 5060211114366.

BIN STORE

AS INSTALLED AND APPROVED UNDER
APPLICATION PL/26/0460

NOTES :

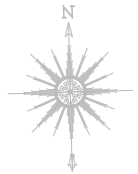

Date	Revisions

SJK DESIGN LTD.
(landscape architects & architects)
Client: MR. PHILIP LEE
Job Title
86 LONDON STREET
READING
RG1 4SJ

Drawing Title
SITE PLAN,
BIN AND BIKE STORE

Scale: 1 : 200 (A4)
Date: MARCH 2026
Checked by: Drawn by:

Drg No.
TP/697/08
Rev.