


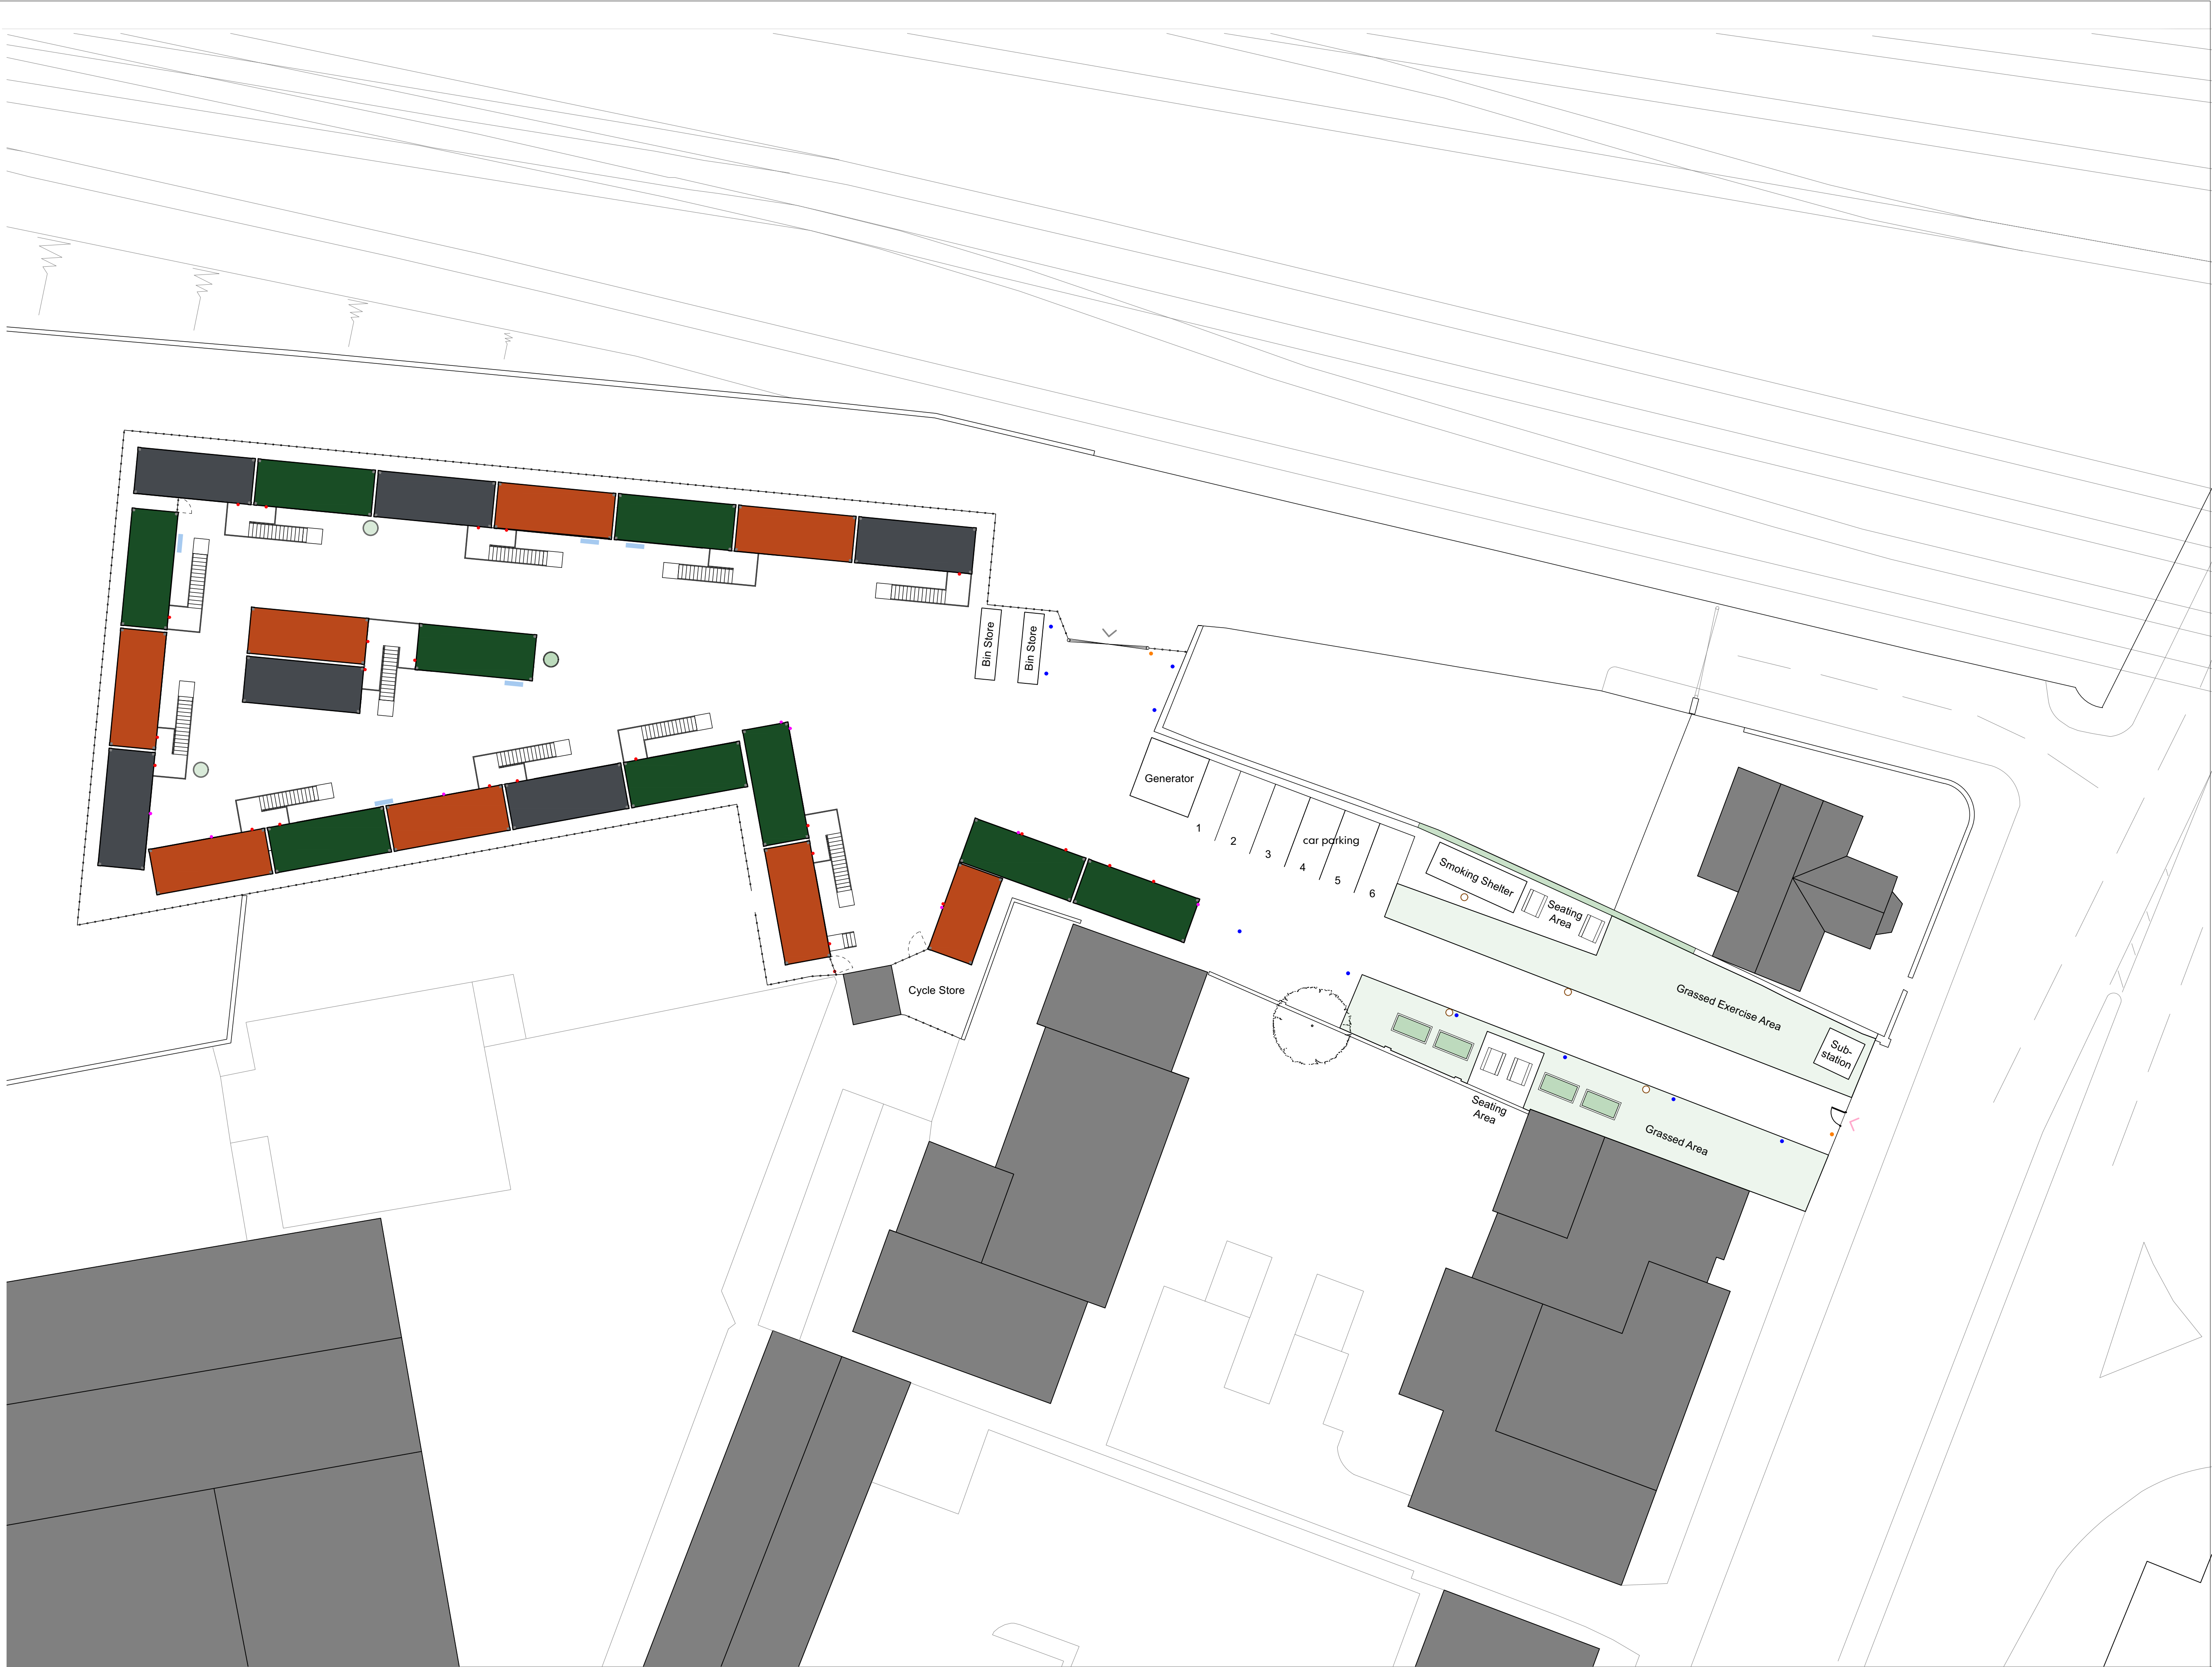

NOTE:
Do not scale from this drawing. Use figured dimensions only.
The contractor is responsible for the checking of all site dimensions and levels.
These should be checked prior to ordering of any components and before commencement of the works on site. All discrepancies should be brought to the immediate attention of the Contract Administrator.

- Key**
- Pedestrian access
 - Vehicular access
 - Grass area
 - Planters
 - Picnic benches
 - Electrical boxes
 - Bins
 - Access control
 - Bollard lights
 - Wall mounted lights
 - CCTV

-	27.08.26	Planning Issue.	KE
rev	date	notes	drawn

Keith Evans Architects
19 Martine Fields Winchester SO21 2AZ
e: keevans@keithsevansarchitects.com | m: 07793051395

project title	date of origin	scale
Abattoirs Road	August 2026	1:200 @ A1
client	drawing title	
Reading Borough Council	As-Built Site Block Plan	
status	drawing reference	revision
PLANNING	2606-001	-