





0 1 2 3 4 5 6 7 8 9 10 11 12 13 14 15 16

Plan scale

1:200

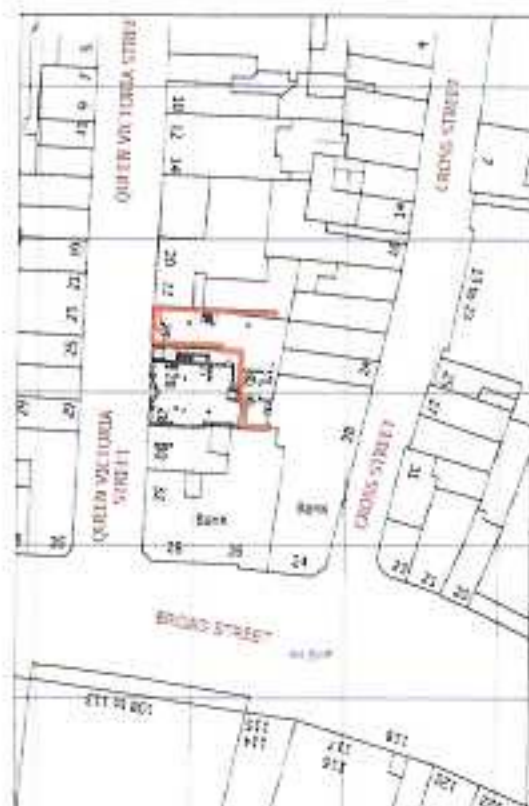

OS location map 1:1250

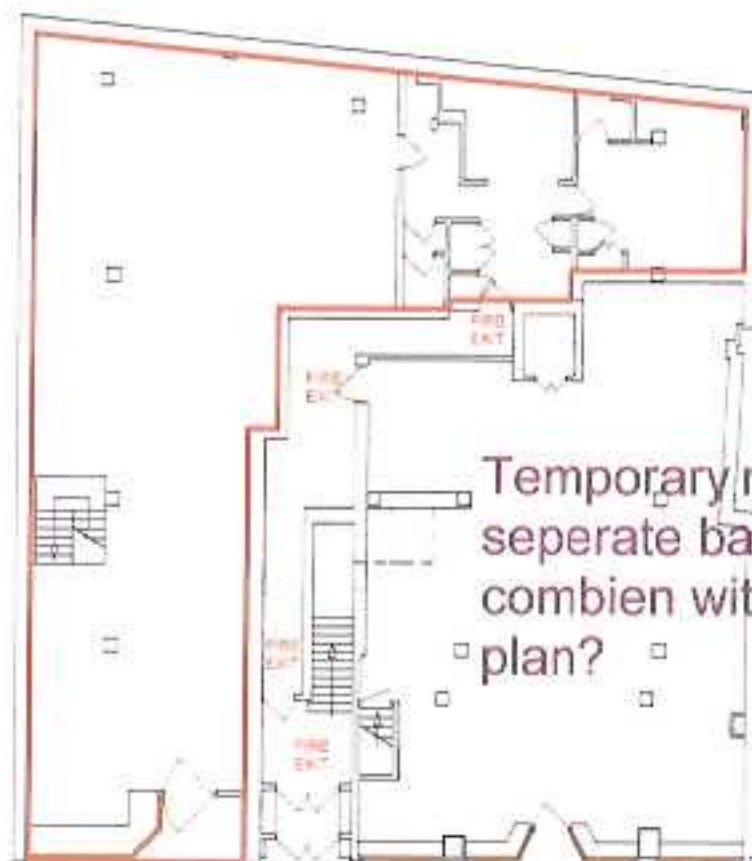

Ground floor

1:200

Temporary note for comment:
seperate basement plans or
combien with ground floor
plan?



Basement

1:200

When printing from a PDF file
print with MC print loading

NOT for construction

The red line indicates the
extent of the demise

Revision

Job title

Queen Victoria Street

Site address: 24-26 Queen Victoria St
Reading

RG1 1HG

Drawing title

Lease plan
Ground floor - North

Drawing status

Survey

1st Survey 2nd Survey
16/10/08

Scale

1:200 A4 21/10/2008

Orig. No. 108/201/02

File No. 108/201/02