

ABBREVIATIONS & SYMBOLS

DRAWING NOTES

Any areas on the drawing where services or features have not been shown are not necessarily clear of services or features but are an indication that no items have been identified during our investigations. All reasonable care and normal good practice should still be employed during design and construction processes.

Survey Solutions has used all reasonable care to research available service records, but the completeness or use of the service records supplied to or by Survey Solutions cannot be guaranteed. Therefore Survey Solutions cannot be held responsible for any features annotated as 'taken from records' (TFR).

Drainage pipe sizes will be obtained without entering the camber and therefore should be treated as approximate. Pipe dimensions which have not been obtained visually will be taken from records when available.

Services, utilities and features may not have been surveyed if obstructed or not reasonably visible or accessible at the time of survey.

Survey Solutions accept no responsibility for the completeness or accuracy of either the topographical survey or base mapping on this project.

The contractor must check and verify all site and building dimensions, levels, utilities and drainage details and connections prior to commencing work.

Do not scale from this drawing

UTILITY	AVAILABILITY	UTILITY	AVAILABILITY	UTILITY	AVAILABILITY
---------	--------------	---------	--------------	---------	--------------

[illegible]



UTILITIES & UNDERGROUND INVESTIGATIONS

ABBREVIATIONS & SYMBOLS

10-12 1-2 3-4 5-6 2659-2660 2661

[illegible]

All below ground details shown have been identified from above ground without excavation. Survey Solution use electro-magnetic and/or ground penetrating radar (GPR) methods to investigate for underground utilities, services and features. Results using these methods are not infallible and we recommend trial excavations are carried out to confirm any identifications, positions and depths.

Any areas on the drawing where services or features have not been shown are not necessarily clear of services or features but are an indication that no items have been identified during our investigations. All reasonable care and normal good practice should still be employed during design and construction processes.

Certain types of services such as plastic or concrete pipes, some conduit and ducting where direct access can not be achieved for tracing may not be shown and alternative locating methods should be used.

Survey Solutions has used all reasonable care to research available service records, but the completeness or use of the service records supplied to or by Survey Solutions cannot be guaranteed. Therefore Survey Solutions cannot be held responsible for any features annotated as 'taken from records' (TFR).

Depths obtained using electro-magnetic or GPR are effected by ground conditions and should be treated as indicative only. Electro-magnetic depths to utilities and services are generally taken to the centre of a feature, GPR depths to the top of a feature and drainage depth shown to inverts, unless otherwise indicated.

Drainage pipe sizes will be obtained without entering the camber and therefore should be treated as approximate. Pipe dimensions which have not been obtained visually will be taken from records when available.

All services, drainage and utilities routes are assumed straight between access points, unless otherwise stated. The numbers of cables in runs will not be shown unless specifically requested. All services are below ground unless indicated.

Services, utilities and features may not have been surveyed if obstructed or not reasonably visible or accessible at the time of survey.

Survey Solutions accept no responsibility for the completeness or accuracy of either the topographical survey or base mapping on this project.

All critical dimensions and measurements should be checked and verified with any errors or discrepancies notified to Survey Solutions immediately. The accuracy of the digital data is the same as the plotting scale implies. All dimensions are in metres unless otherwise stated.


The contractor must check and verify all site and building dimensions, levels, utilities and drainage details and connections prior to commencing work.

© Land Survey Solutions Limited hold the copyright to all the information contained within this document and their written consent must be obtained before copying or using the data other than for the purpose it was originally supplied.

Do not scale from this drawing

AVAILABILITY OF UTILITY RECORD DRAWINGS					
UTILITY	AVAILABILITY	UTILITY	AVAILABILITY	UTILITY	AVAILABILITY
SEWER	PUBLIC	BT	PUBLIC	CEIL PIPES	NO
WATER MAIN	PUBLIC	CABLE TV	NO	OTHERS	NO
GAS MAIN	PUBLIC	ELECTRICITY	PUBLIC		

REV	DESCRIPTION	DRAWN	CHECKED	APPR	SURVEY D
-----	-------------	-------	---------	------	----------

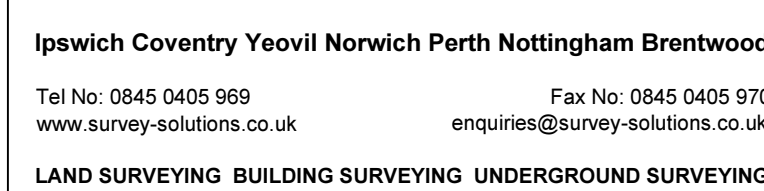

PROJECT TITLE RIVER ACADEMY. RITCHFIELD AVENUE, READING, RG1 8EQ.
DRAWING DETAIL UTILITIES AND DRAINAGE SURVEY. SHEET 3 OF 3

CLIENT READING BOROUGH COUNCIL.				SCALE 1:250
SURVEYOR JAB	SURVEY DATE 23/01/2020	CHECKED BY GSB	APPROVED BY GSB	DWG STATUS FINAL
DRAWING NUMBER 25671UG-03			REVISION	ISSUE DATE 27/01/2020