


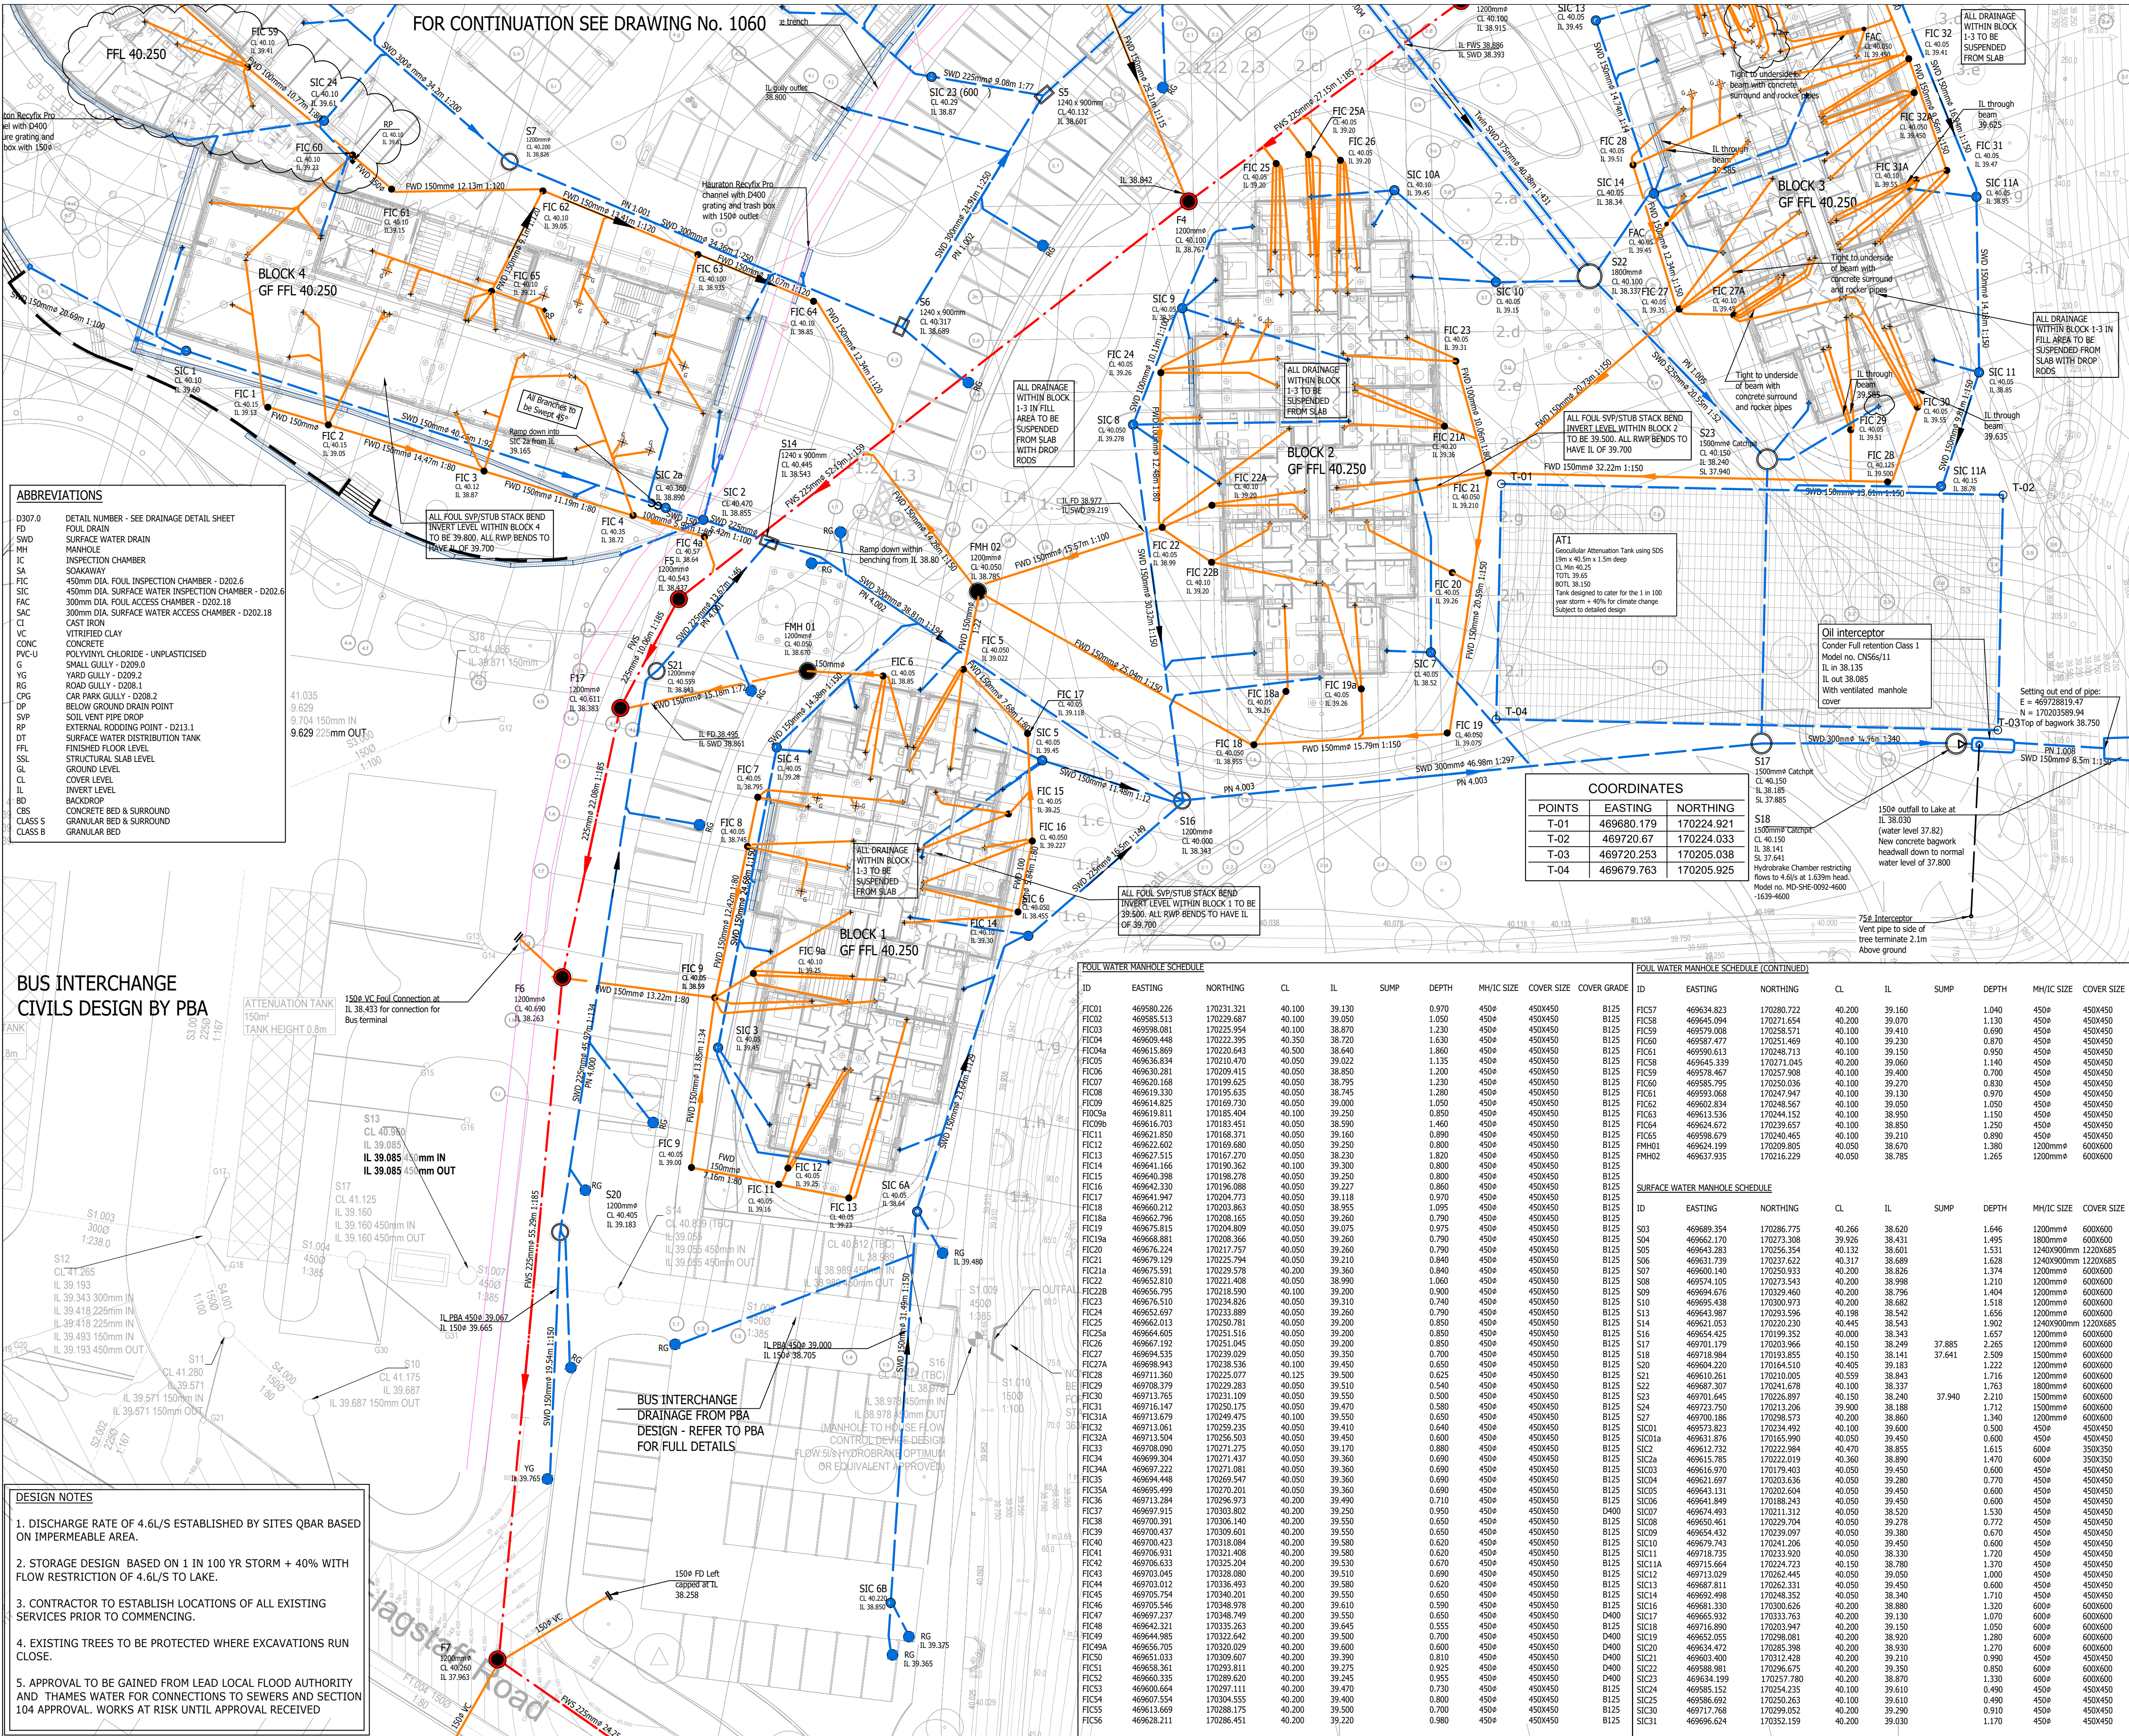

- GENERAL NOTES**
- The location, size, depth and identification of existing services that may be shown or referred to on this drawing have been assessed from non intrusive observations, record drawings or the like. The contractor shall safely carry out intrusive investigations, trial holes or soundings prior to commencing work to satisfy himself that it is safe to proceed and that the assessments are accurate. Any discrepancies shall be notified to gta prior to works commencing.
 - Tender or billing drawings shall not be used for construction or the ordering of materials.
 - Do not scale. All dimensions and levels to be site confirmed.
 - This drawing shall be read in conjunction with all relevant architects, consultants drawings and specifications, together with H&S plan requirements.
 - Copyright: This drawing must not be copied, amended nor reproduced without the prior written agreement of gta.
 - All drawings specifications and recommendations made by gta are subject to Local Authority and other relevant Statutory Authorities approval. Any works or services made abortive due to the client proceeding prior to these approvals is considered wholly at the Clients risk. gta hold no responsibility for resuting abortive works or costs.

KEY

- Existing Foul Drainage
- Existing Storm Drainage
- Adoptable Storm Drainage S104
- Adoptable Foul Drainage S104
- Private Storm Drainage
- Private Foul Drainage
- Adoptable Foul Sewer Manhole
- Adoptable Foul Sewer Manhole - Type 3
- Adoptable Storm Sewer Manhole - Type 3
- Adoptable Storm Sewer Manhole - Type 3
- Manholes fitted with Backdrop Connection
- 450mm Foul Plastic Inspection Chamber
- 450mm Storm Plastic Inspection Chamber
- 300mm Foul Water Access Chamber
- Foul Water Roding Point
- Storm Water Roding Point
- Foul Drain connection to SWP/S
- Rain Water Pipe 100p unless noted otherwise
- Private Road Gully
- Private Yard Gully
- Channel Drain
- Direction of Fall

FOR SPECIFICATION NOTES, REFER TO DRAWING 1060

REFER TO DRAWING 1070, 1071 & 1072 FOR DRAINAGE DETAILS RELATIVE TO ALL PRIVATE DRAINAGE

BUS INTERCHANGE CIVILS DESIGN BY PBA

- DESIGN NOTES**
- DISCHARGE RATE OF 4.6L/S ESTABLISHED BY SITES QBAR BASED ON IMPERMEABLE AREA.
 - STORAGE DESIGN BASED ON 1 IN 100 YR STORM + 40% WITH FLOW RESTRICTION OF 4.6L/S TO LAKE.
 - CONTRACTOR TO ESTABLISH LOCATIONS OF ALL EXISTING SERVICES PRIOR TO COMMENCING.
 - EXISTING TREES TO BE PROTECTED WHERE EXCAVATIONS RUN CLOSE.
 - APPROVAL TO BE GAINED FROM LEAD LOCAL FLOOD AUTHORITY AND THAMES WATER FOR CONNECTIONS TO SEWERS AND SECTION 104 APPROVAL. WORKS AT RISK UNTIL APPROVAL RECEIVED

FOUL WATER MANHOLE SCHEDULE									
ID	EASTING	NORTHING	CL	IL	SUMP	DEPTH	MH/C SIZE	COVER SIZE	COVER GRADE

FOUL WATER MANHOLE SCHEDULE (CONTINUED)									
ID	EASTING	NORTHING	CL	IL	SUMP	DEPTH	MH/C SIZE	COVER SIZE	COVER GRADE

SURFACE WATER MANHOLE SCHEDULE									
ID	EASTING	NORTHING	CL	IL	SUMP	DEPTH	MH/C SIZE	COVER SIZE	COVER GRADE
S03	469689.354	170286.775	40.266	38.620		1.646	1200mm	600x600	D400
S04	469662.170	170273.308	39.926	38.431		1.495	1800mm	600x600	D400
S05	469643.283	170256.354	40.132	38.601		1.531	1240x900mm	1220x685	D400
S06	469631.739	170237.522	40.317	38.689		1.628	1240x900mm	1220x685	D400
S07	469600.140	170250.933	40.200	38.826		1.374	1200mm	600x600	D400
S08	469574.105	170273.543	40.200	38.998		1.210	1200mm	600x600	D400
S09	469694.676	170239.460	40.200	38.796		1.404	1200mm	600x600	D400
S10	469656.438	170200.973	40.200	38.682		1.518	1200mm	600x600	D400
