




FOR DESIGN INTENT ONLY - NOT FOR CONSTRUCTION

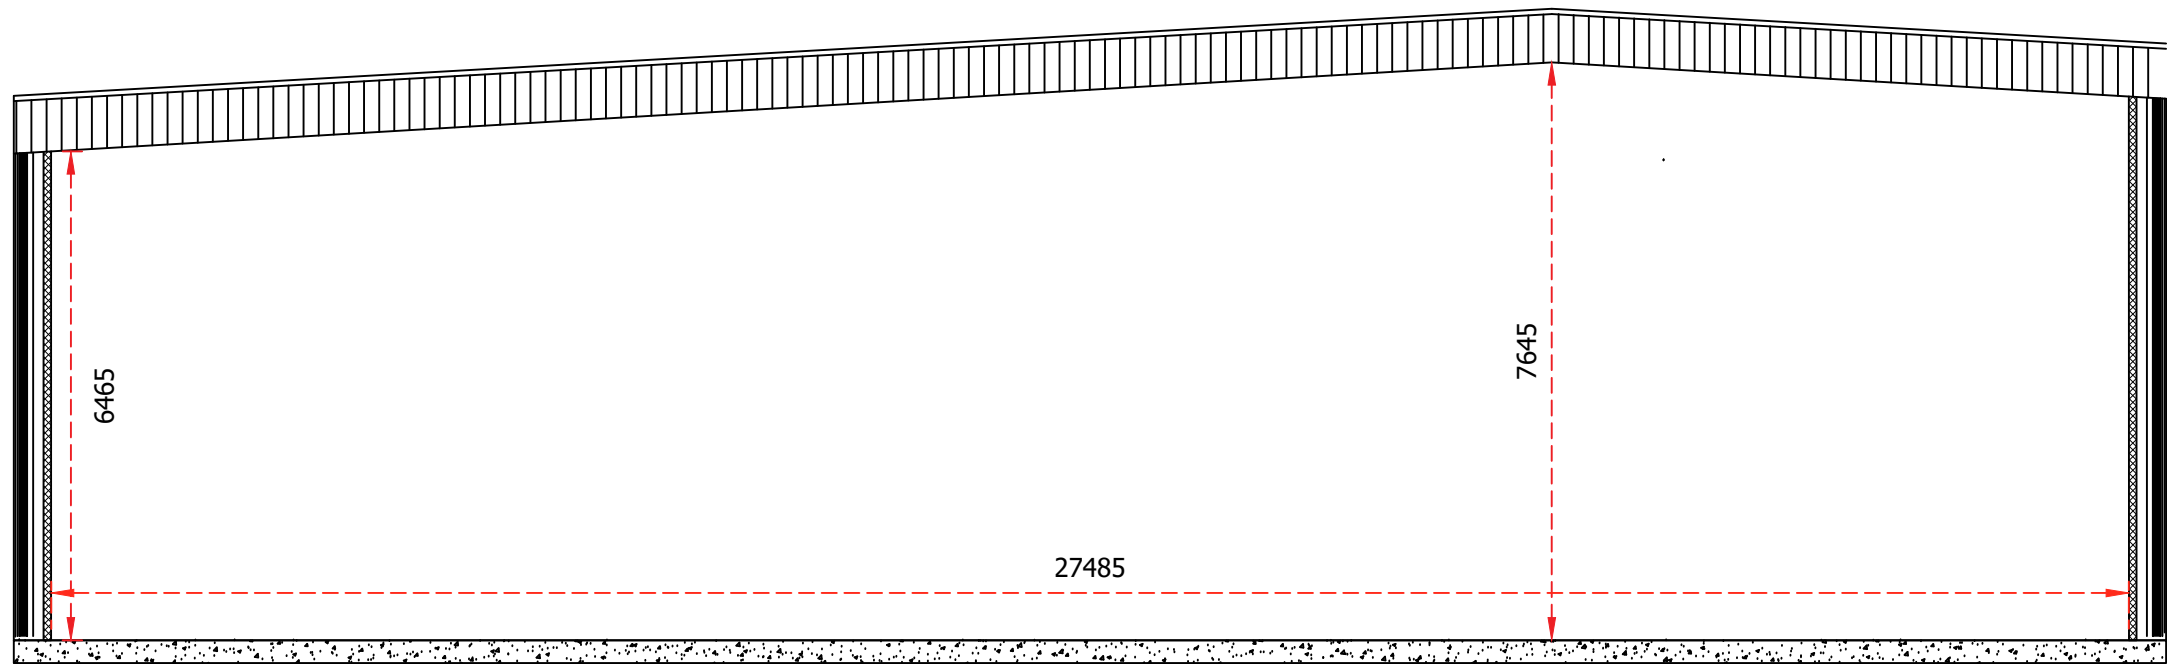

A SECTION
SCALE 1:100 @A3

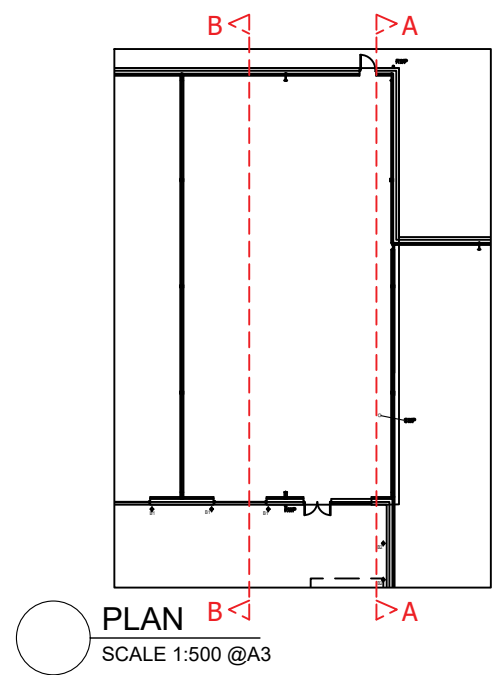

PLAN
SCALE 1:500 @A3

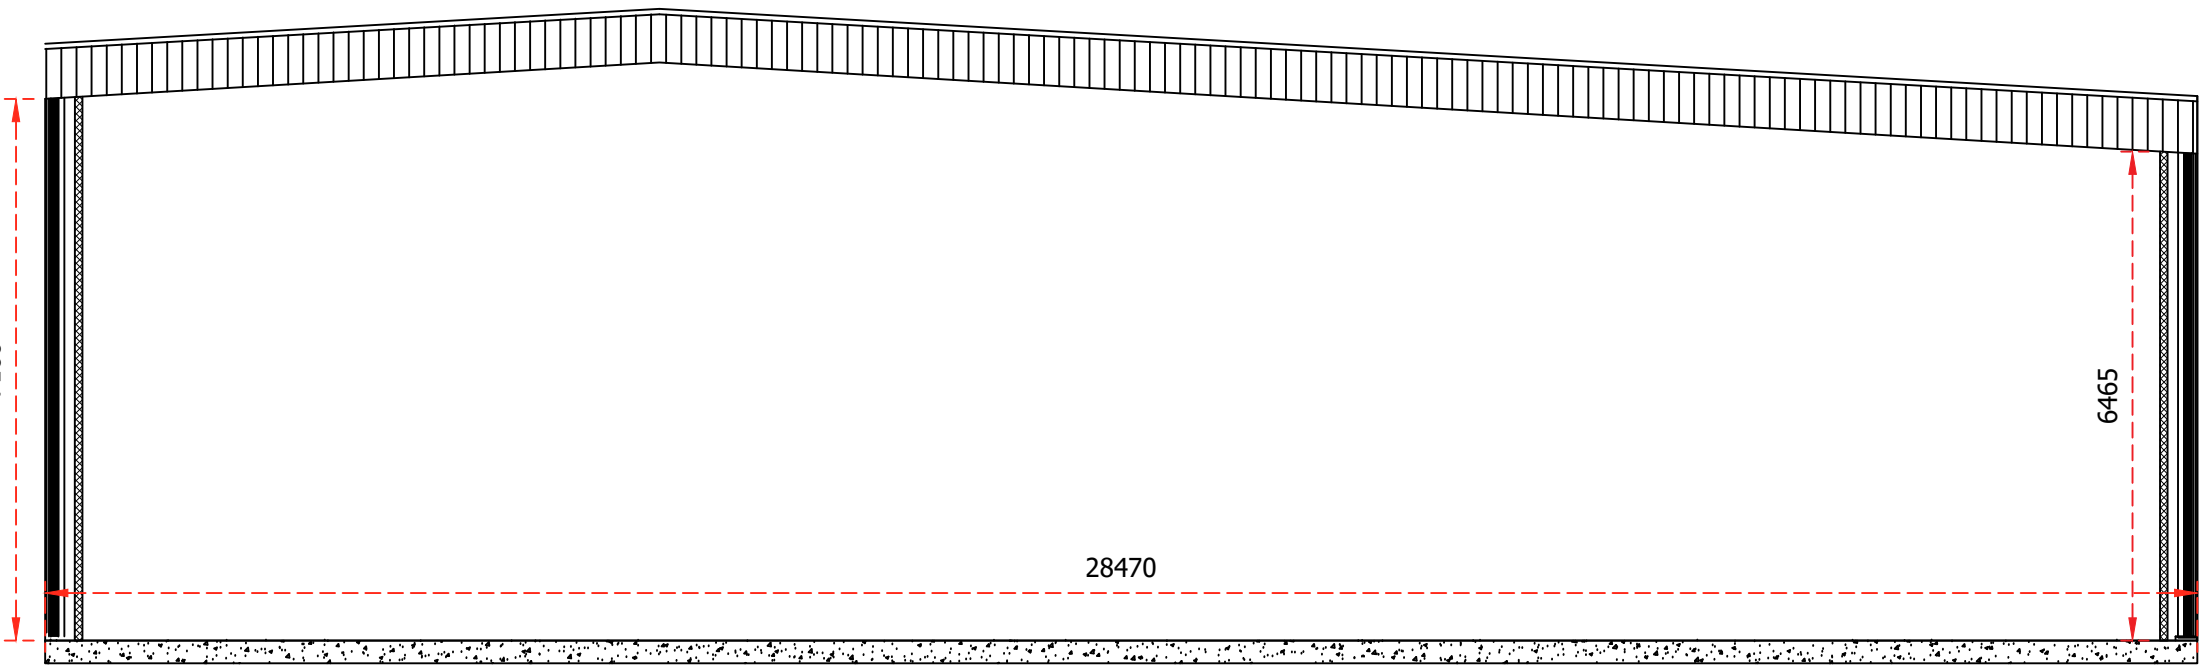

B SECTION
SCALE 1:100 @A3

A	AS BUILT	23.09.19
issue	description	date

BUILDER AND / OR SUB-CONTRACTORS SHALL VERIFY ALL PROJECT DIMENSIONS BEFORE COMMENCING ON-SITE OR OFF-SITE FABRICATIONS FIGURED DIMENSIONS SHALL TAKE PRECEDENCE OVER SCALED DIMENSIONS. THIS DRAWING IS COPYRIGHT AND CANNOT BE REPRODUCED IN WHOLE OR IN PART OR BY ANY MEDIUM WITHOUT THE WRITTEN PERMISSION OF STAMP DESIGN. NO WARRANTY IS OFFERED OR IMPLIED ON THE CONTENT OF THESE DRAWINGS. CLIENT AND CONTRACTOR SHOULD SATISFY THEMSELVES THAT THE DESIGN INTENT AS INDICATED IS SUITABLE IN TERMS OF FUNCTION AND FEASIBILITY. GUIDANCE SHOULD BE SOUGHT FROM THE LANDLORDS RETAINED ARCHITECT, STRUCTURAL ENGINEERS AND PROJECT TEAM AS TO THE FEASIBILITY OF DESIGN INTENT CONTAINED HEREIN. THE LANDLORDS AGENTS WILL BE RESPONSIBLE IN ALL CASES FOR ENSURING ADEQUATE PROVISION OF DESIGN INFORMATION, AND SIGN OFF OF DESIGN INTENT HEREIN. NO STRUCTURAL DESIGN HAS TAKEN PLACE. SHOULD STRUCTURAL DESIGN BE REQUIRED, THIS MUST BE COMMISSIONED AND SIGNED OFF BY AN INDEPENDENT STRUCTURAL ENGINEER IN ALL CASES. NO GUIDANCE OR WARRANTY AS TO THE STRUCTURAL SUITABILITY OF ANY WORK CONTAINED HEREIN IS OFFERED OR IMPLIED. **IF IN DOUBT, ASK!**



SIXT RENT A CAR
UNIT 5, READING TRADE CENTRE
ROSE KILN LANE
READING
RG2 0JZ



STUDIO 3.1.2
THE LEATHER MARKET
LONDON
SE1 3ER
www.stampdesign.co.uk

title
INTERNAL ELEVATIONS

scale
1:100 @A3

drawn
JRS

drawing no.
STA.SIXT.READING.SU02

