


EXISTING SIDE ELEVATION

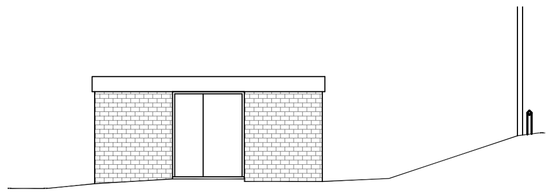


EXISTING FRONT ELEVATION

EXISTING MATERIALS


Grey flat roof

Grey painted doors,


Red-Brown facing brickwork

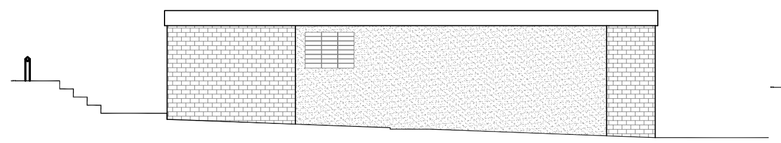


EXISTING SIDE ELEVATION

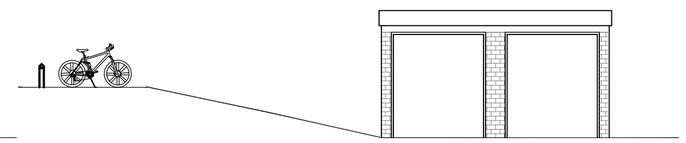


EXISTING REAR ELEVATION

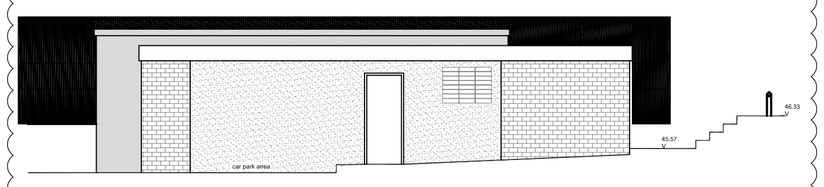


PROPOSED SIDE ELEVATION

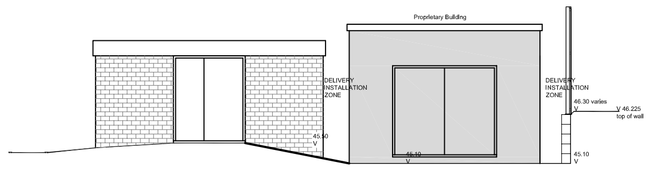

PROPOSED FRONT ELEVATION

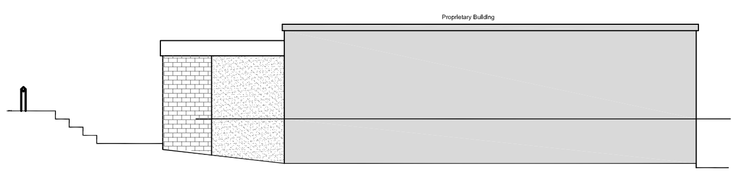

PROPOSED SIDE ELEVATION

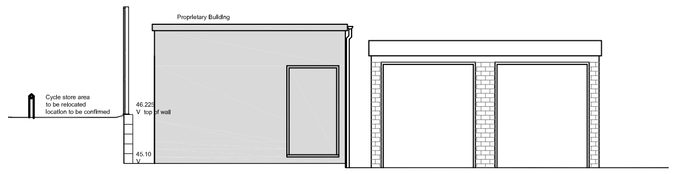

EXISTING REAR ELEVATION


PROPOSED FENCING IMAGE



PLANNING NOTES


Prefabricated light grey structure
Roof, Walls and grey doors


Palisade fencing colour to match existing

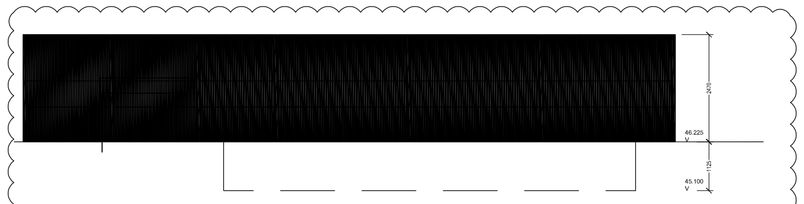

PROPOSED PATH SIDE ELEVATION

1 0 1 2 3 4 5
SCALE 1:100 m

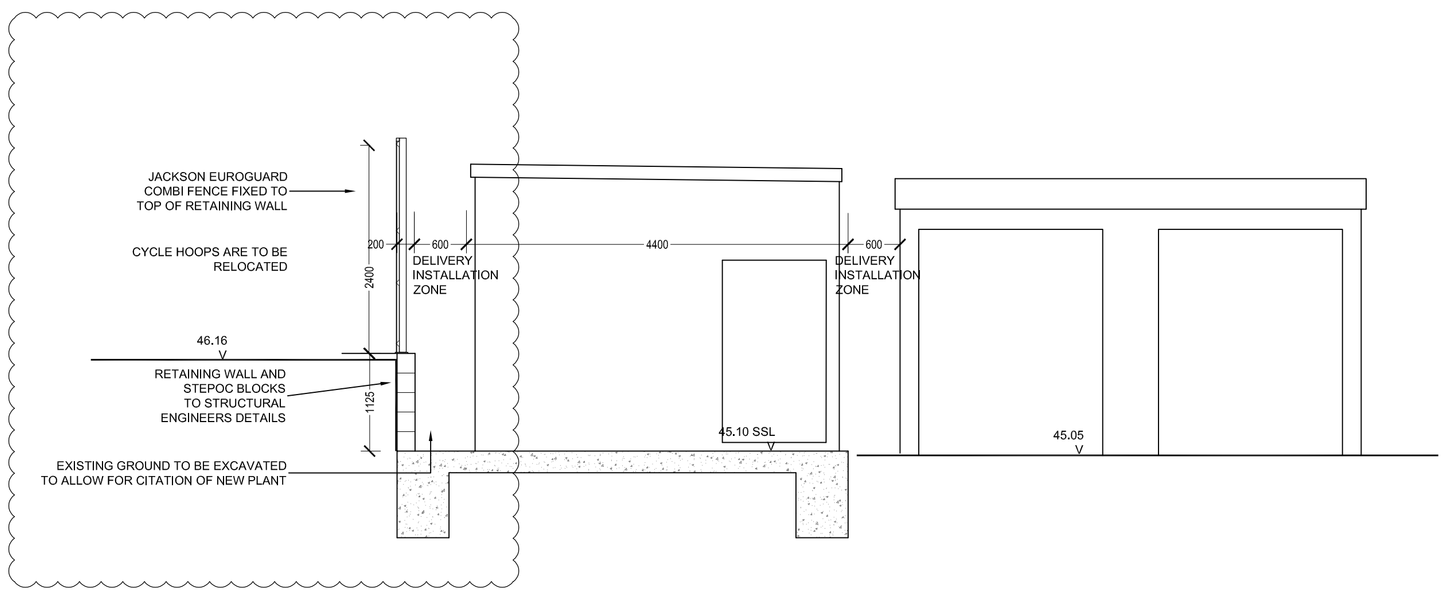

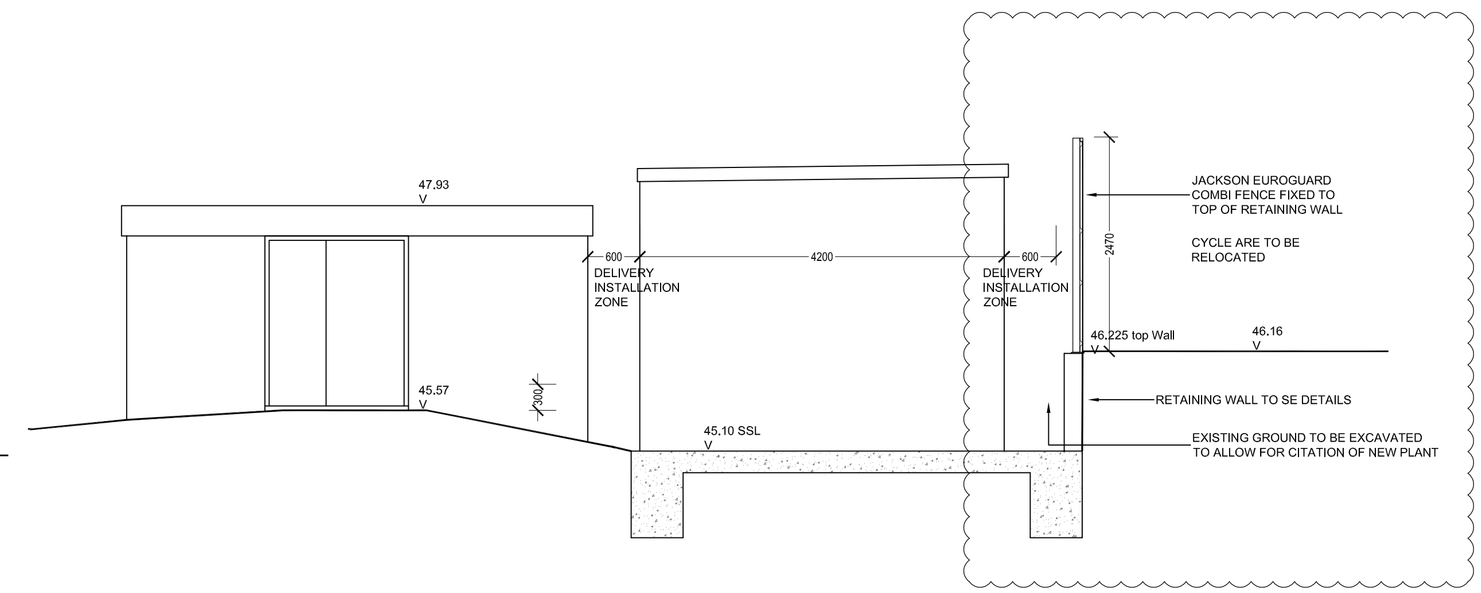

0.5 0 0.5 1 1.5 2 2.5
SCALE 1:50 m

N

DISCLAIMER NOTES:

- THIS DOCUMENT IS COPYRIGHT OF THE ORIGINATOR AND MUST BE TREATED AS CONFIDENTIAL
- THIS DOCUMENT MUST NOT BE ALTERED, REPRODUCED OR DISTRIBUTED WITHOUT PRIOR WRITTEN CONSENT OF THE ORIGINATOR
- THIS DOCUMENT MUST NOT BE ALTERED - THE ORIGINATOR ACCEPTS NO RESPONSIBILITY FOR ANY DISCREPANCIES ARISING AS A RESULT OF THE ORIGINATORS INFORMATIONS BEING ALTERED BY OTHERS
- ANY DISCREPANCY MUST BE REPORTED TO THE ORIGINATOR
- DO NOT SCALE THIS DOCUMENT - USE FIGURED DIMENSIONS ONLY
- ALL DIMENSIONS MUST BE CHECKED ON SITE PRIOR TO COMMENCEMENT OF ANY RELATED WORKS
- THIS DOCUMENT MUST BE READ IN CONJUNCTION WITH ALL SUPPORTING DOCUMENTS PRODUCED BY THE ORIGINATOR AND OTHER PROJECT DISCIPLINES
- THE ORIGINATOR ACCEPTS NO RESPONSIBILITY FOR THE ACCURACY OF BACKGROUND INFORMATION PRODUCED BY THIRD PARTIES - THIS MUST BE TREATED AS INDICATIVE ONLY
- USERS OF THIS DOCUMENT ARE RESPONSIBLE FOR CHECKING WHICH REVISION IS CURRENT
- THE DOCUMENT STATUS "INFORMATION" OR "PRELIMINARY", INDICATES THAT THIS DRAWING IS FOR REFERENCE PURPOSES ONLY - THE ORIGINATOR WILL ACCEPT NO RESPONSIBILITY FOR THE COMPLETENESS OF INFORMATION UNDER THIS STATUS
- THE DOCUMENT STATUS "RECORD" OR "AS BUILT" HAS BEEN PREPARED, IN PART, BASED UPON INFORMATION FURNISHED BY OTHERS, WHILE THIS INFORMATION IS BELIEVED TO BE RELIABLE, THE ORIGINATOR ASSUMES NO RESPONSIBILITY FOR THE ACCURACY OF THIS "RECORD" OR "AS BUILT" DOCUMENT OR FOR ANY ERRORS OR OMISSIONS THAT MAY HAVE BEEN INCORPORATED INTO IT AS A RESULT OF INCORRECT INFORMATION PROVIDED TO THE ORIGINATOR, THOSE RELYING ON THE "RECORD" OR "AS BUILT" DOCUMENT ARE ADVISED TO OBTAIN INDEPENDENT VERIFICATION OF ITS ACCURACY

DRAWING NOTES:

CDM REGULATIONS 2015
SIGNIFICANT OR NON-OBVIOUS RISKS AND RISKS WHICH ARE DIFFICULT TO MANAGE ARE IDENTIFIED ON THIS DRAWING USING THE FOLLOWING SYMBOL IDENTIFIED TO THE RIGHT WITH BRIEF ACCOMPANYING TEXT, FOR FUTHER DETAILS OF THE RISKS IDENTIFIED BY DESIGNERS, REFERENCE SHOULD BE MADE TO CDM HAZARD REGISTER.

REV	DESCRIPTION	DATE	BY	CHKD
A	OAK TREE REMOVED, FENCING ALTERED AND PLANTING ADDED	19/11/2018	DAF	DT

ORIGINATOR:

RIDGE
PROPERTY & CONSTRUCTION CONSULTANTS

BEAUMONT HOUSE
59 HIGH STREET
THEALE
READING, RG7 5AL

TEL: 0118 932 3088
FAX: 01993 815001
WWW.RIDGE.CO.UK

CLIENT:

Reading Borough Council
Working better with you

IN ASSOCIATION WITH:

PROJECT:

Pre-Fabricated Water Storage & Treatment Plant Building
205 Wensley Road RG1 6ED

TITLE:

EXISTING - PROPOSED ELEVATIONS

DRAWN BY:	DT	SCALE: 1:100	@ A1
CHECKED BY:	DF	DATE: 19/12/2017	

STATUS: PLANNING

DRAWING No: -

JOB No:	ORG:	ZONE:	LEVEL:	TYPE:	ROLE:	NUMBER:	REV:
5002914	RDG	XX	ST	EL	A	103	A