

400 Longwater Avenue
NMA03 - Mark-up of changes compared to NMA 02

The car park structures have been amended to accommodate changing room and shower facilities, together with cycles and bin stores and the required plantrooms

The configuration of the car park at grade has been adjusted according to the new car park structures. The overall number of car park spaces is the same as the NMA 02.


The shape of the southern car park structure matches the one of the northern; its footprint has been reduced and its location is further away from the main building.

Disclaimer
Do not scale from this drawing.
Check all dimensions on site before fabrication or setting out.
This document is copyright and may not be reproduced without permission of the owner.

Notes

00	NMA 03	05/09/18	RPP
Rev	Reason for Issue	Date	Iss

Consultants
Landscape Architects: Place Design + Planning
Planning Consultant: Deloitte LLP
Quantity Surveyors: Gardiner & Theobald LLP
Structure: Ramboll
Building Services: Hoare Lea

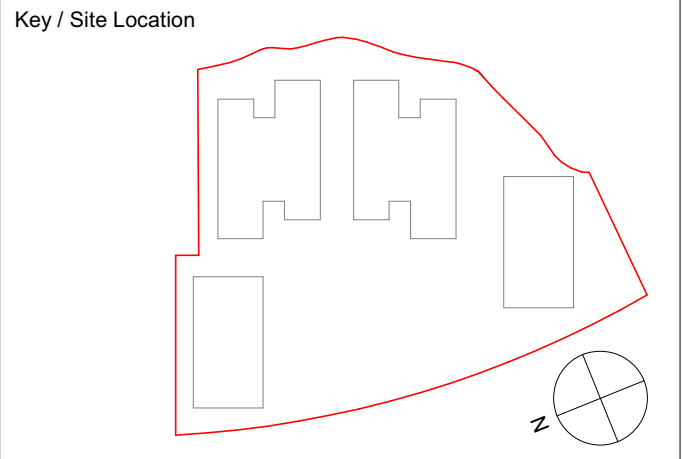

Robin Partington & Partners
235 St. John Street
London
EC1V 4NG
+44 20 7419 3500
mail@rpplondon.com
www.rpplondon.com

Client
Green Park Reading No.1 LLP

Project 400 Longwater Avenue, Green Park		
Drawing Title Alternative Scheme Site Plan		
Scale 1 : 500 @ A1	Drawn By RPP	Issued By RPP
Stage 3		
Project No. 15011	Drawing No. A_PL_020	Revision 00