DO NOT SCALE from this drawing
Contractors must verify all dimensions on site before setting out, commencing work or making any shop drawings

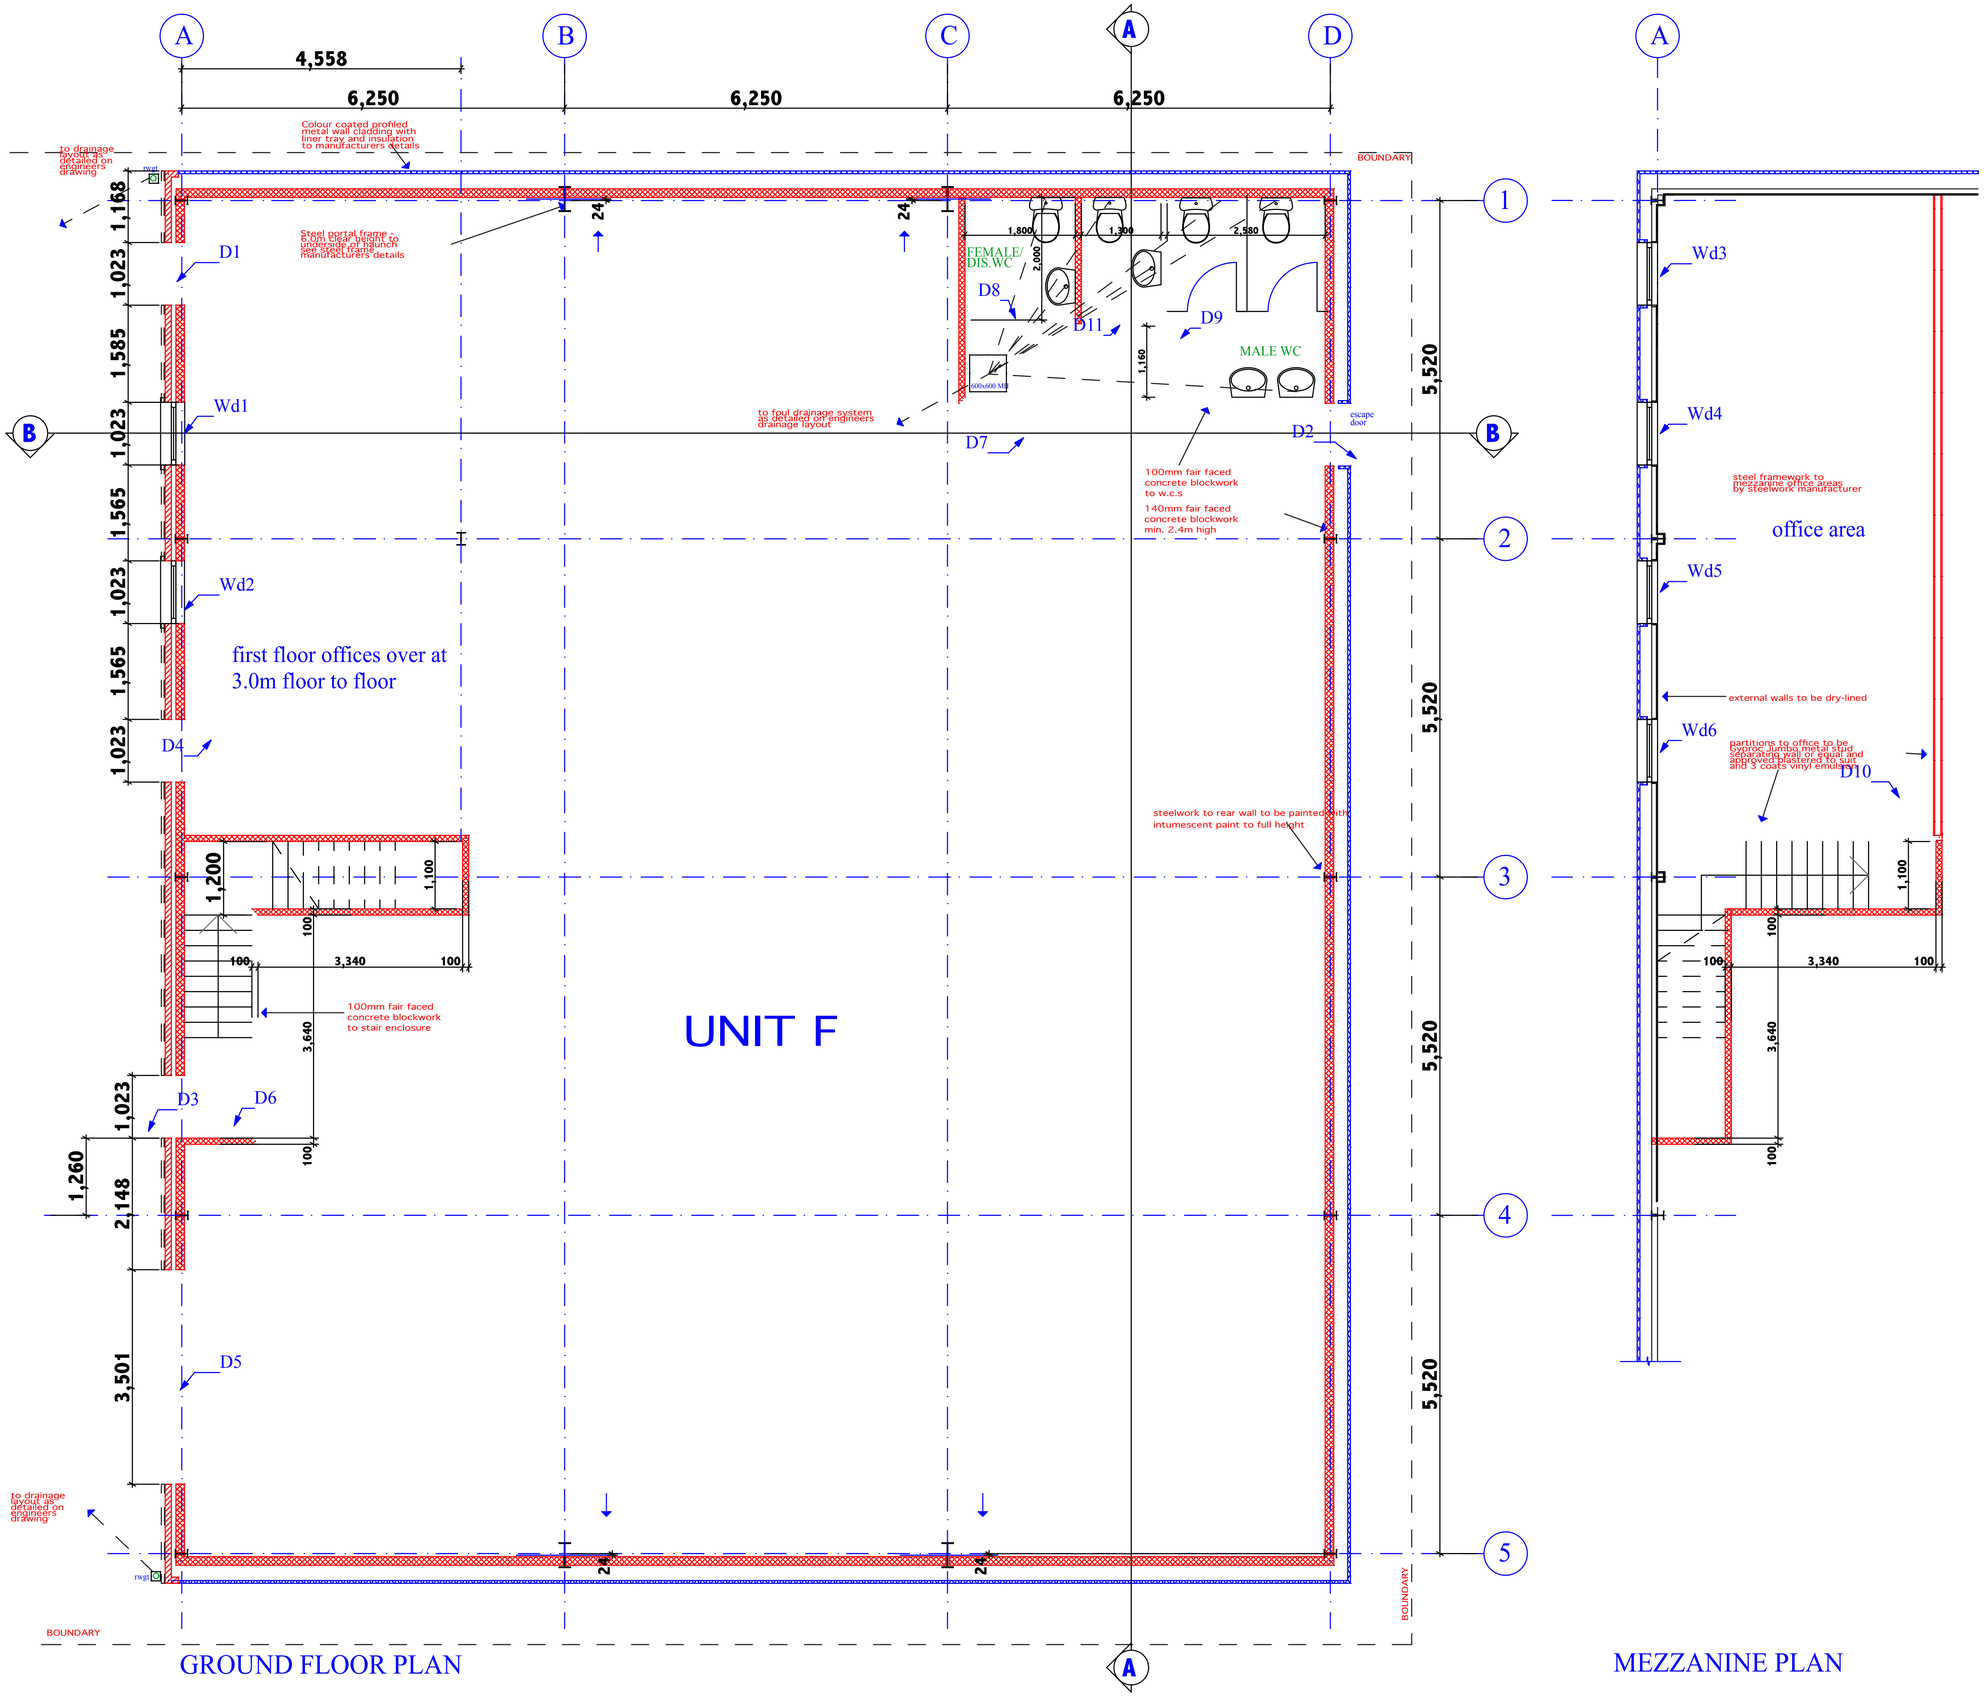

GROUND FLOOR PLAN

MEZZANINE PLAN

RECORD DRAWING

P8 Position of lower stair flight amended, position on D3 and D6 amended to coordinate with steel work 14.09.98
P7. Inner leaf external walls amende to 140mm block 14.08.98
P6. Toilet layout amended to include extra female w.c. 11.08.98
P5. Unit wall layout amended after meeting 22.06.98
P4. General amendments, specification added 17.06.98
P3. Position of escape door and w.c. layout and corner stanchions amended 11.06.98
P2. Door to stairwell at GF level added, escape door position revised 03.06.98

Spicegrid Ltd

Redevelopment
203-205 Shinfield Road
Reading

Unit F

1:50 02.98

2032 43 P8