


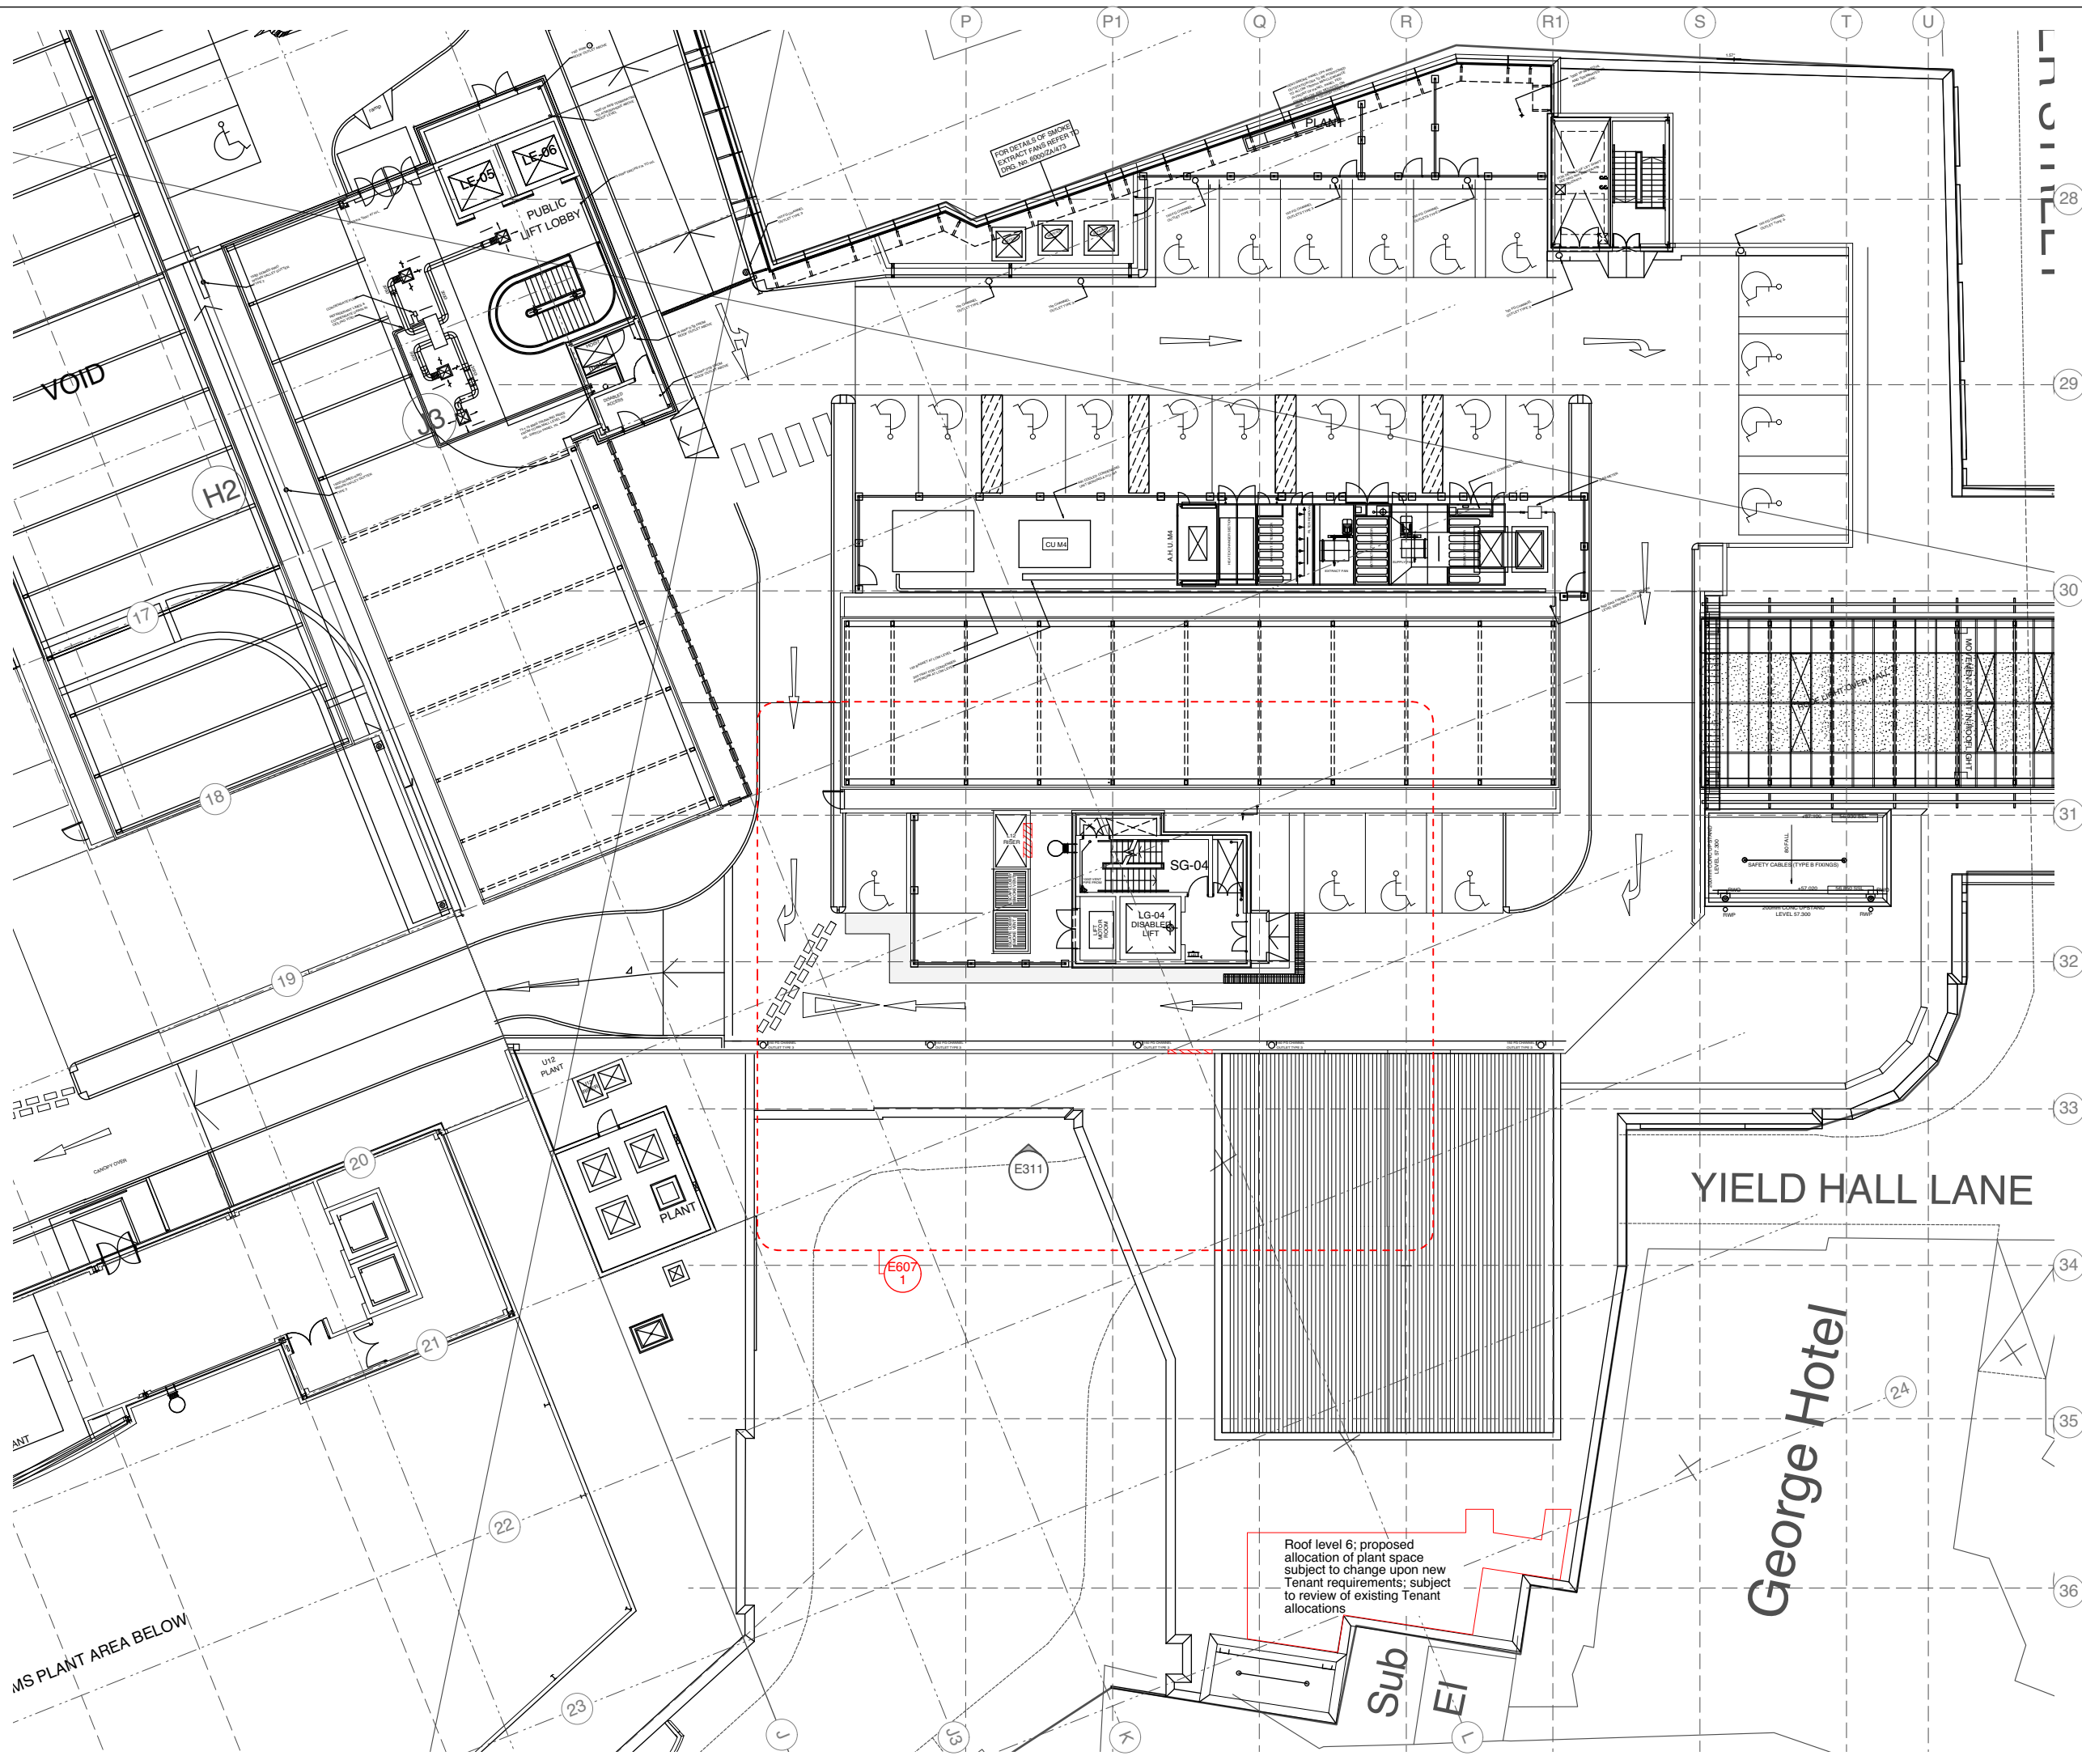

NOTE: Proposal subject to confirmation from Structural and Fire Engineering Consultants

SOLID RED LINE: INDICATES PROPOSED EXTENTS OF NEW DEMISE

RED HATCH: STRIP OUT / DEMOLITIONS

G 1/9/17 Issued for Stage 2 Tender
F 25/8/17 Updated for Stage 2 Tender WIP team issue
E 9/8/17 Updated to show extent of breakout required

Stage 2 Tender

© HADDON FEW MONTUSCHI ARCHITECTS LTD.
Do not scale from this drawing, dimensions to be checked on site.
Errors and omissions to be reported to the architect - if in doubt, ask.

HFM ARCHITECTS
25 Fouberts Place
Carnaby Street
London W1F 7QF
+44 (0)20 7434 3532
mail@hfm.uk.com
www.hfm.uk.com

CLIENT
Hammerson
The Oracle, Reading

PROJECT
Project Jenga

DRAWING TITLE
Existing Level 7 Plan

Car Park Level 2

SCALE	PRINT SIZE	PROJECT	
1:300	A3	3407	
DATE	BY	DRAWING NO	REV
15.04.14	dg	E107	G