
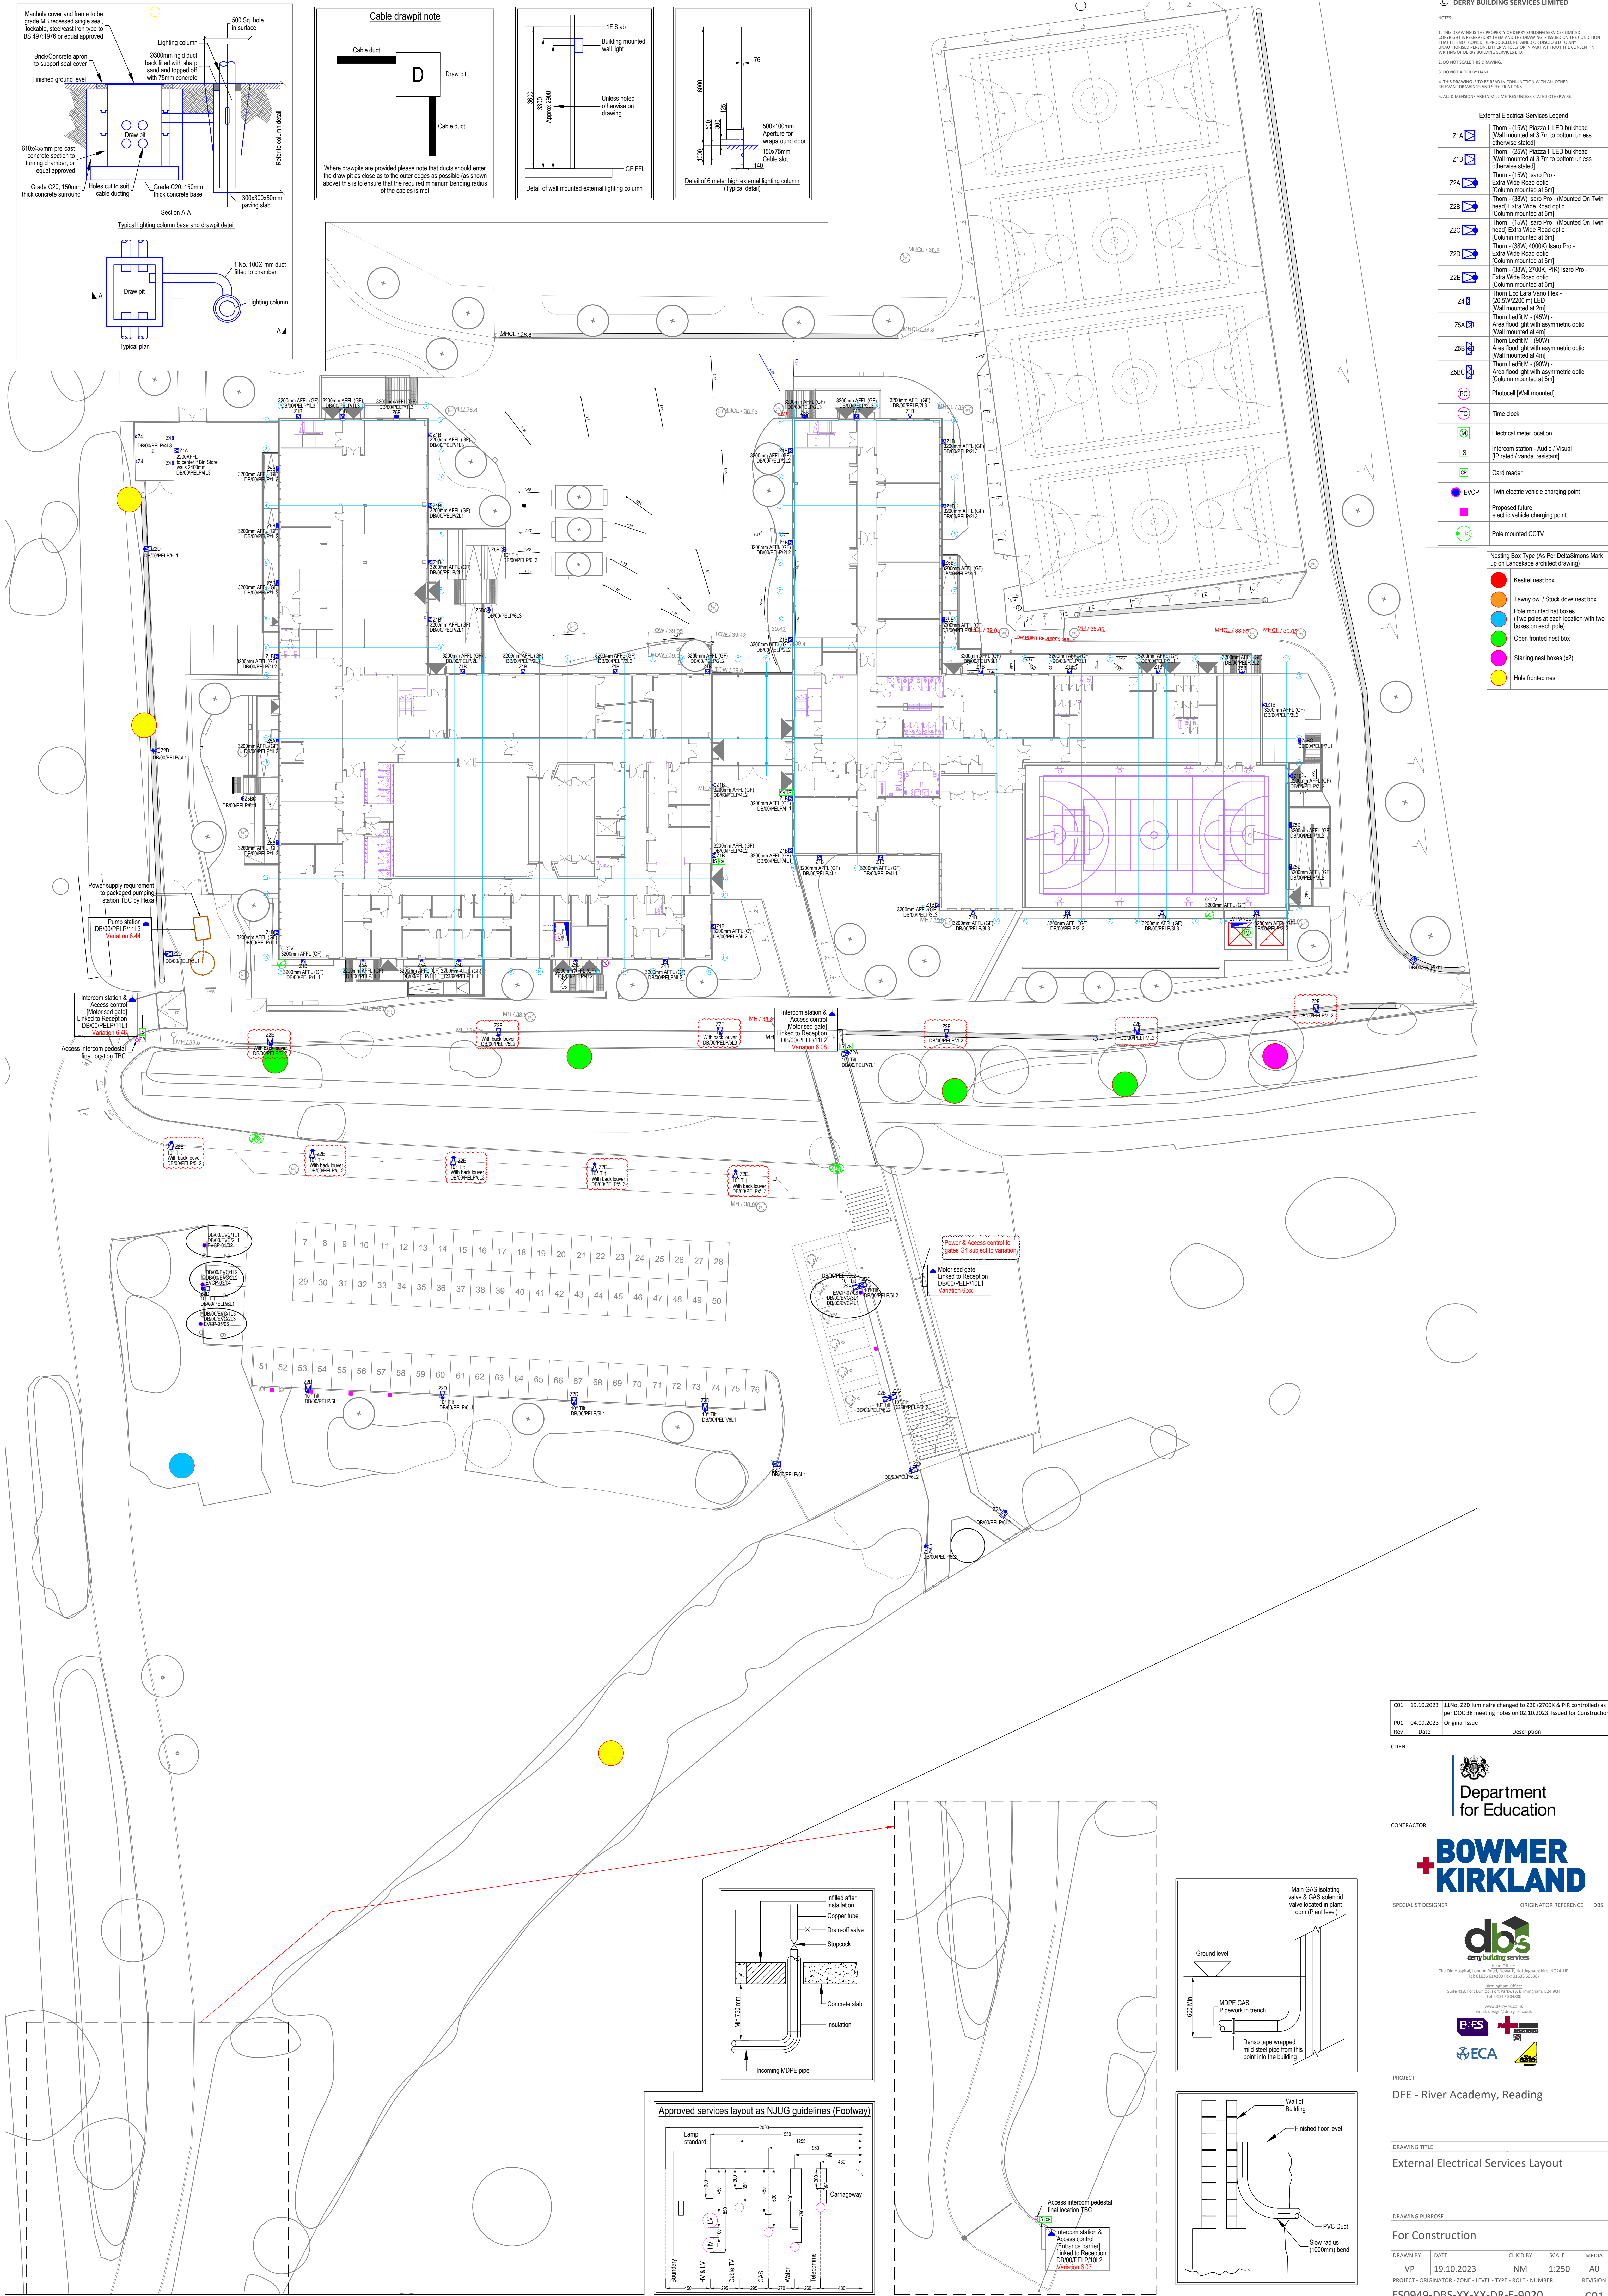
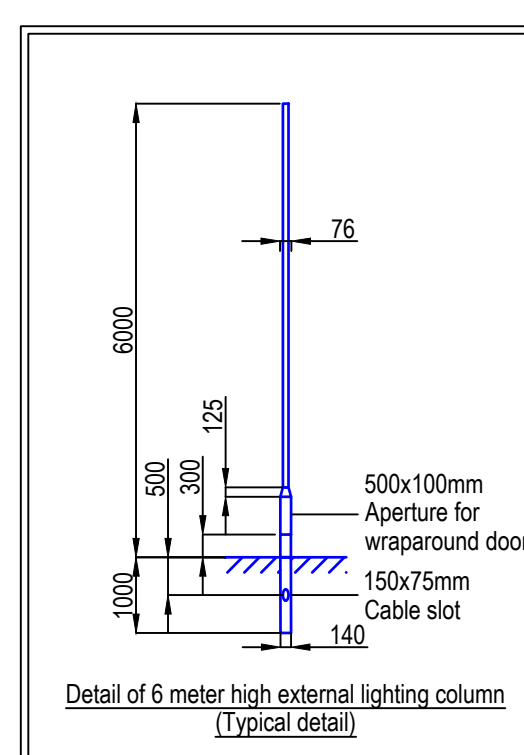
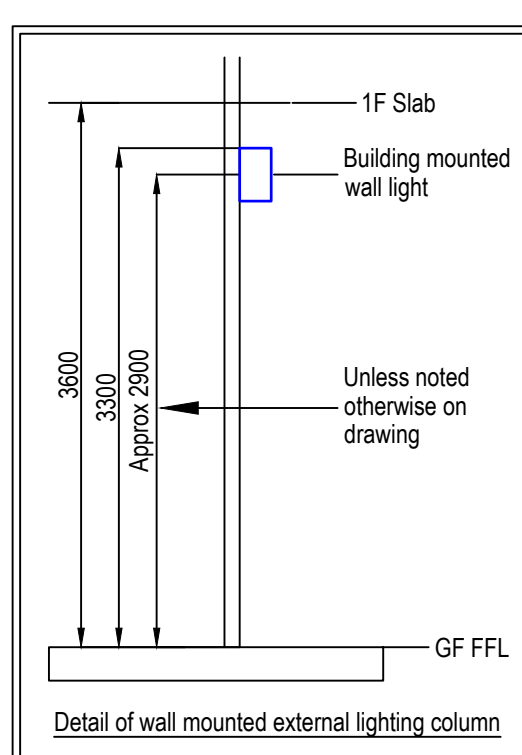
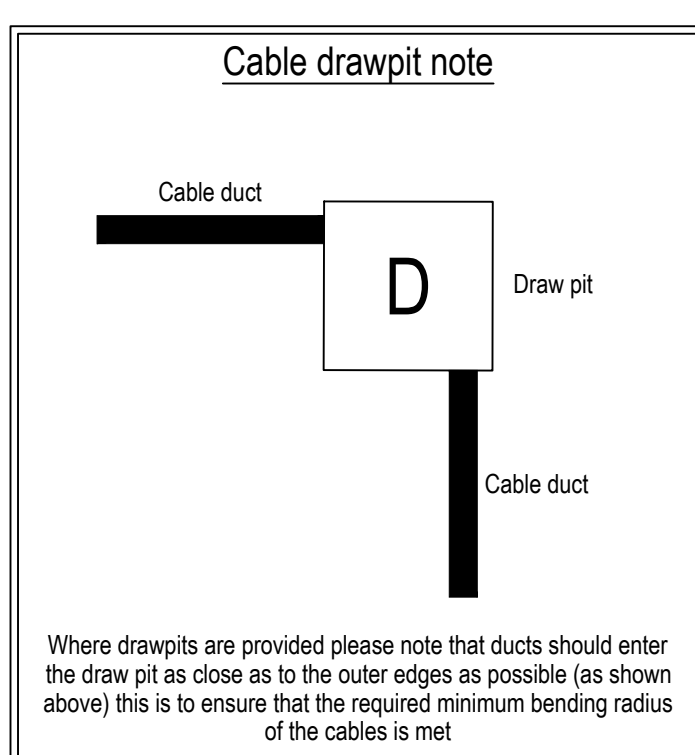


- NOTES:
- THIS DRAWING IS THE PROPERTY OF DERRY BUILDING SERVICES LIMITED. CONCEPT IS RESERVED BY THEM AND THE DRAWINGS ISSUED ON THE CONDITION THAT IT IS NOT TO BE REPRODUCED, COPIED, EITHER WHOLLY OR IN PART WITHOUT THE CONSENT IN WRITING OF DERRY BUILDING SERVICES LIMITED.
  - DO NOT SCALE THIS DRAWING.
  - THIS DRAWING IS TO BE READ IN CONJUNCTION WITH ALL OTHER RELEVANT DRAWINGS AND SPECIFICATIONS.
  - ALL DIMENSIONS ARE IN MILLIMETRES UNLESS STATED OTHERWISE.

| External Electrical Services Legend |                                                                                              |
|-------------------------------------|----------------------------------------------------------------------------------------------|
| Z1A                                 | Thom - (15W) Piazza II LED bulkhead (Wall mounted at 3.7m to bottom unless otherwise stated) |
| Z1B                                 | Thom - (25W) Piazza II LED bulkhead (Wall mounted at 3.7m to bottom unless otherwise stated) |
| Z2A                                 | Thom - (15W) Isaro Pro - Extra Wide Road optic (Column mounted at 6m)                        |
| Z2B                                 | Thom - (38W) Isaro Pro - (Mounted On Twin head) Extra Wide Road optic (Column mounted at 6m) |
| Z2C                                 | Thom - (15W) Isaro Pro - (Mounted On Twin head) Extra Wide Road optic (Column mounted at 6m) |
| Z2D                                 | Thom - (38W, 4000K) Isaro Pro - Extra Wide Road optic (Column mounted at 6m)                 |
| Z2E                                 | Thom - (38W, 2700K, PIR) Isaro Pro - Extra Wide Road optic (Column mounted at 6m)            |
| Z4                                  | Thom Eco Lara Vario Flex - (20.5W/2200lm) LED (Wall mounted at 2m)                           |
| Z5A                                 | Thom Leffle M - (45W) - Area floodlight with asymmetric optic (Wall mounted at 4m)           |
| Z5B                                 | Thom Leffle M - (50W) - Area floodlight with asymmetric optic (Wall mounted at 4m)           |
| Z5BC                                | Thom Leffle M - (50W) - Area floodlight with asymmetric optic (Column mounted at 6m)         |
| PC                                  | PhotoCell (Wall mounted)                                                                     |
| TC                                  | Time clock                                                                                   |
| EM                                  | Electrical meter location                                                                    |
| IS                                  | Intercom station - Audio / Visual (IP rated / vandal resistant)                              |
| CR                                  | Card reader                                                                                  |
| EVCP                                | Twin electric vehicle charging point                                                         |
|                                     | Proposed future electric vehicle charging point                                              |
| ECCTV                               | Pole mounted CCTV                                                                            |

Nesting Box Type (As Per DeltaSimons Mark up on Landscape architect drawing)

- Kestrel nest box
- Tawny owl / Stock dove nest box
- Pole mounted bat boxes (Two poles at each location with two boxes on each pole)
- Open fronted nest box
- Starling nest boxes (x2)
- Hole fronted nest

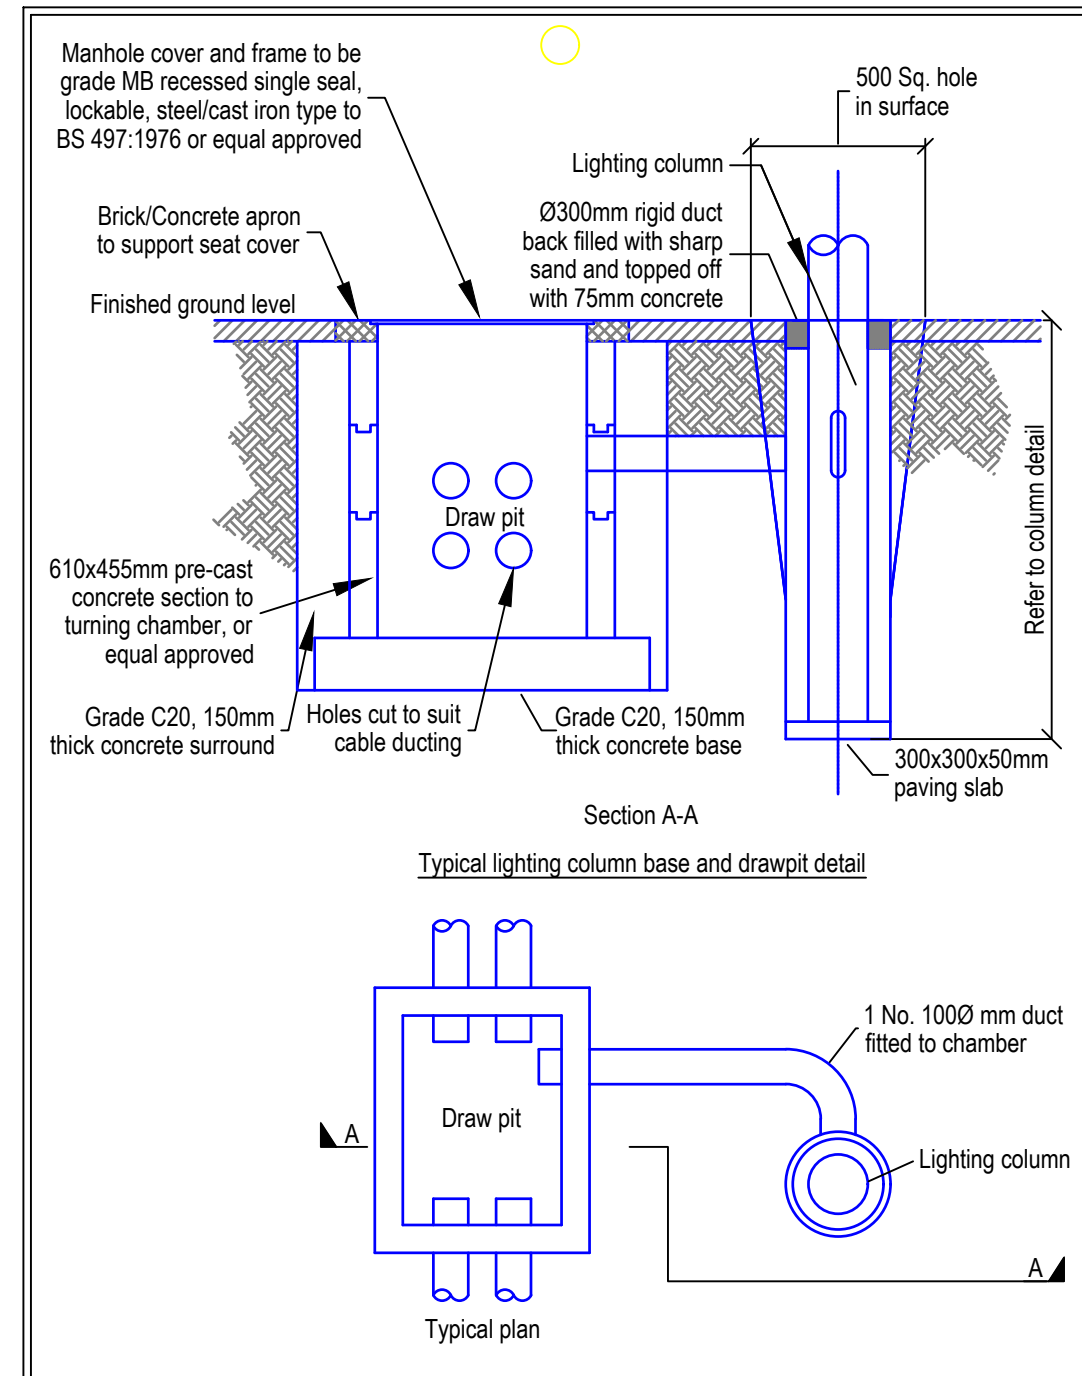

| CO1 | 19.10.2023 | 11No. Z2D luminaire changed to Z2E (2700K & PIR controlled) as per DOC 38 meeting notes on 02.10.2023. Issued for Construction |
|-----|------------|---|
| PO1 | 04.09.2023 | Original Issue   |
| Rev | Date       | Description   |

CLIENT



PROJECT

DFE - River Academy, Reading

DRAWING TITLE

External Electrical Services Layout

DRAWING PURPOSE

For Construction

| DRAWN BY                                                   | DATE       | CHK'D BY | SCALE | MEDIA |
|------------------------------------------------------------|------------|----------|-------|-------|
| VP                                                         | 19.10.2023 | NMD      | 1:250 | A0    |
| PROJECT - ORIGINATOR - ZONE - LEVEL - TYPE - ROLE - NUMBER | REVISION   |          |       |       |
| FS0949-DBS-XX-XX-DR-E-9020                                 | CO1        |          |       |       |