



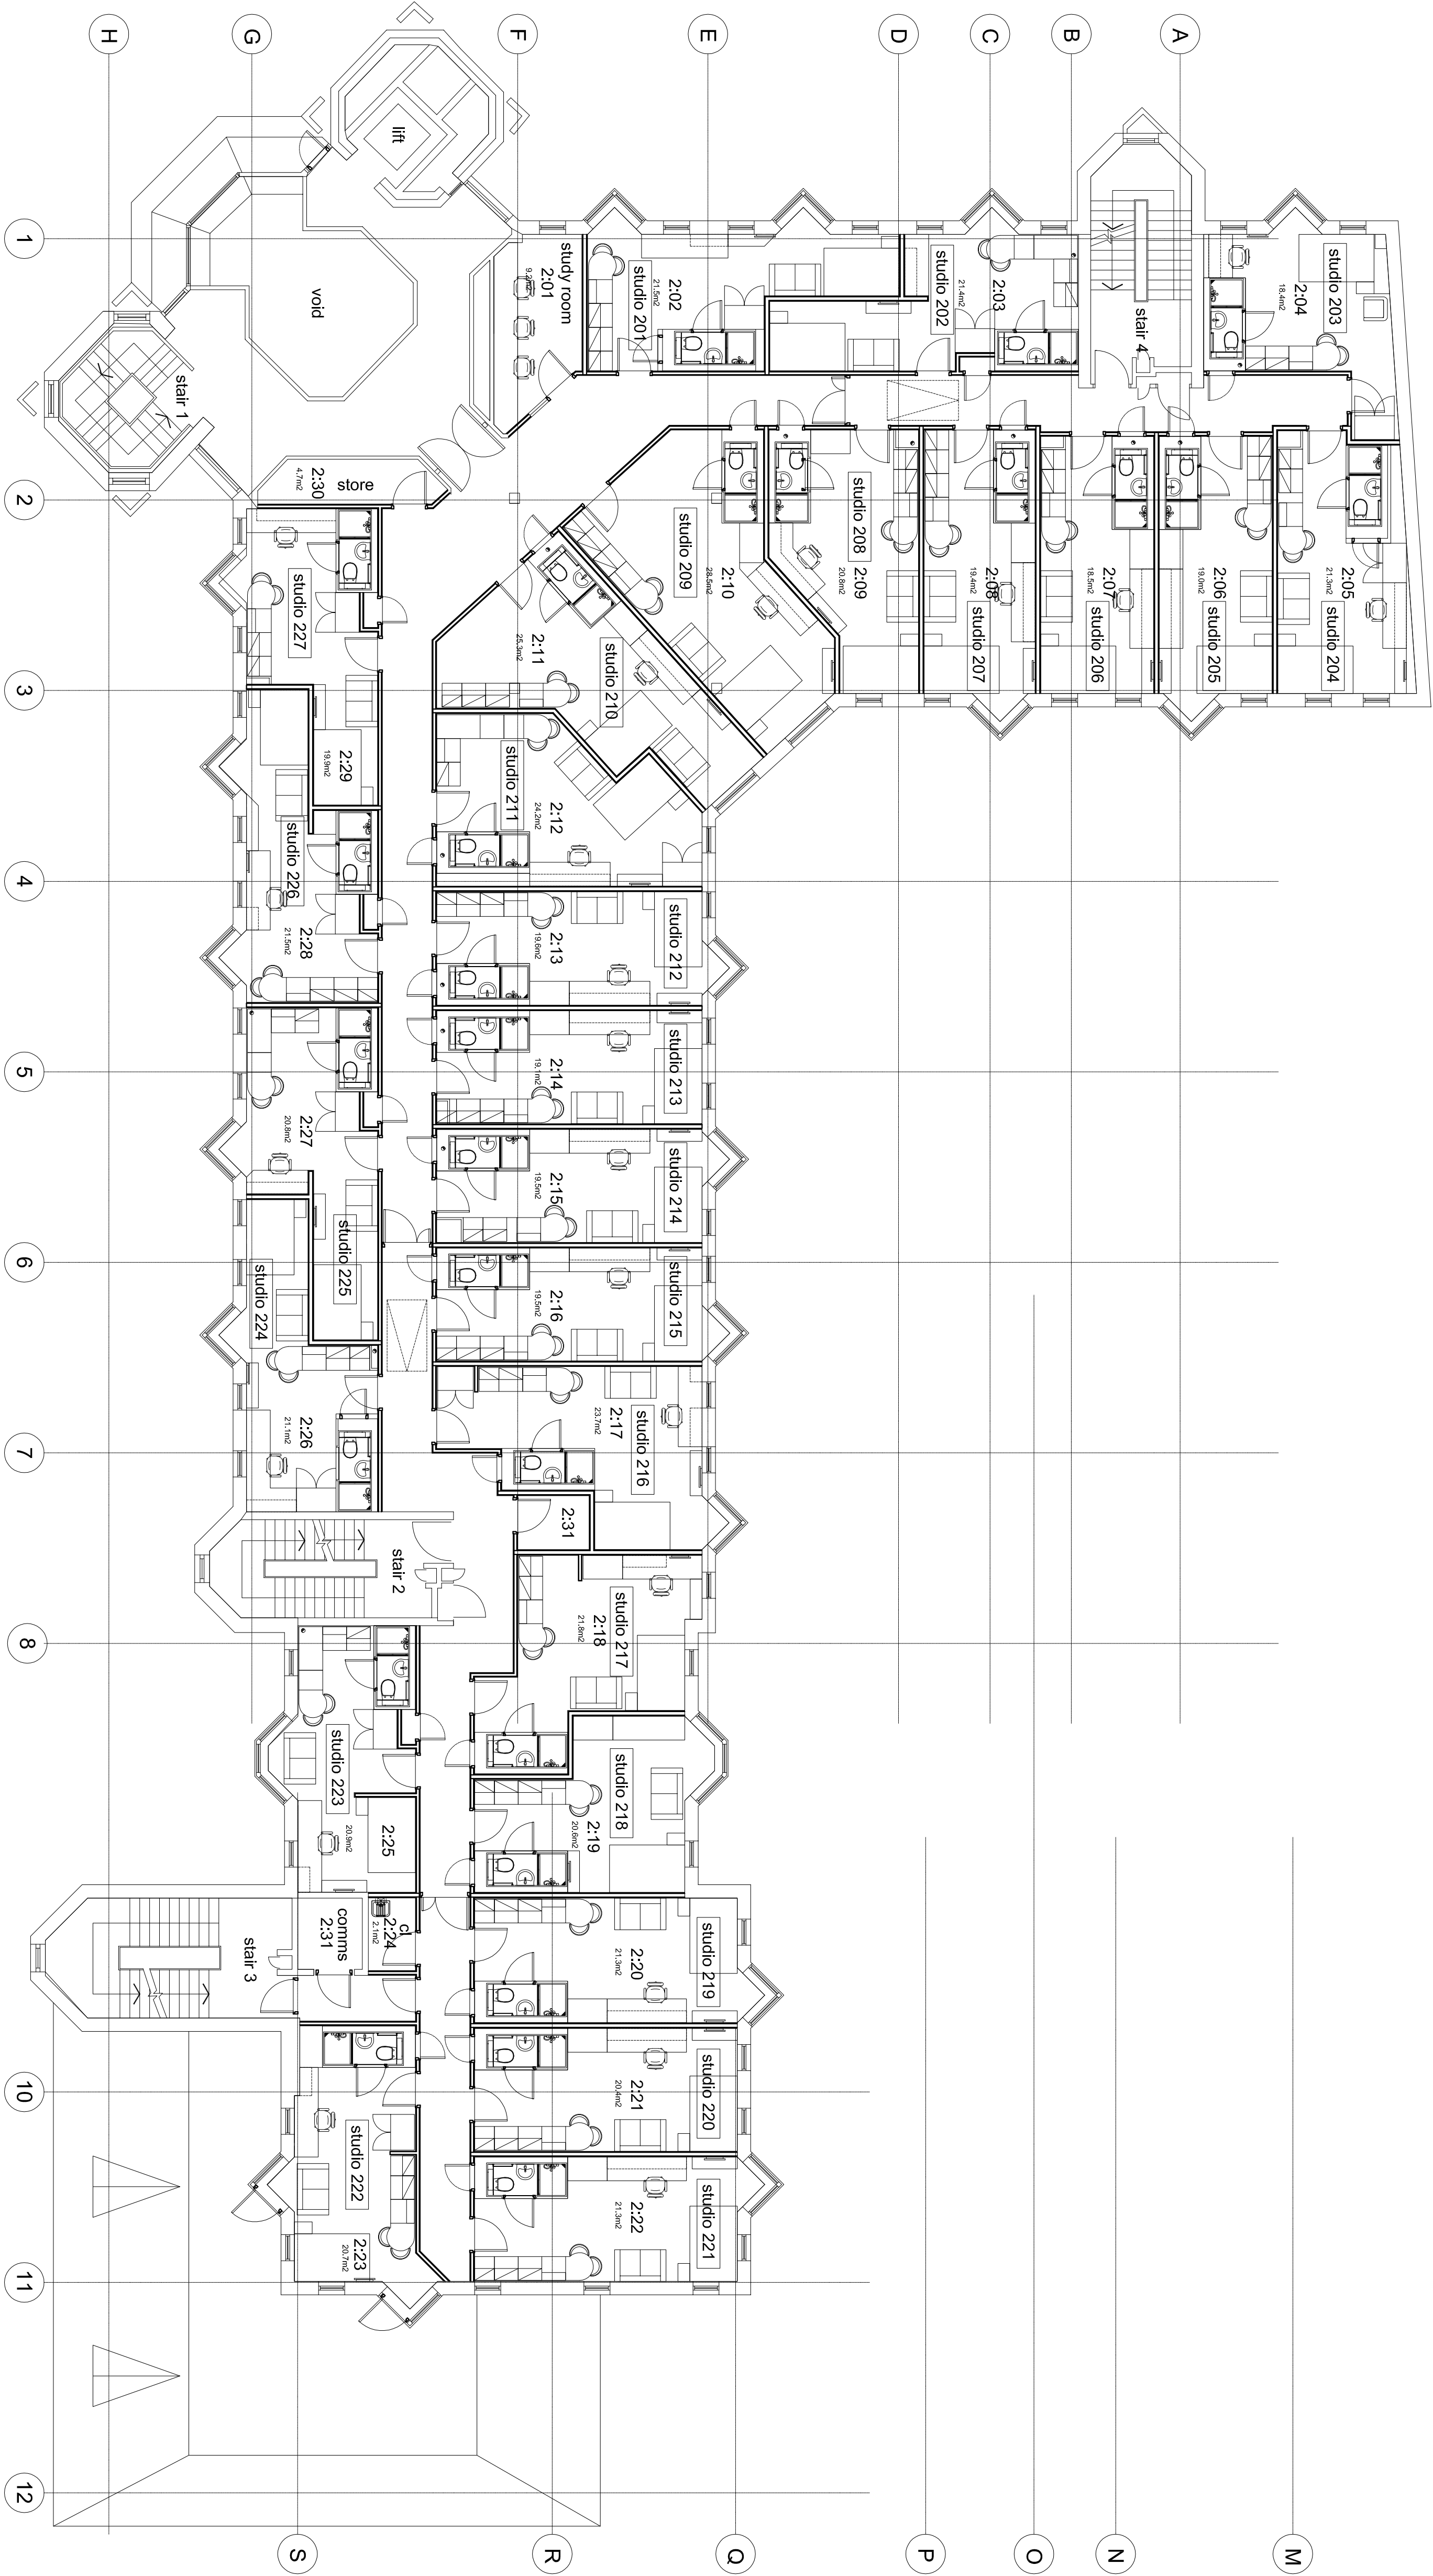

- GENERAL NOTES
1. This drawing is copyright and must not be reproduced without the consent of Greenwell Design Ltd.
 2. All dimensions are in millimeters unless otherwise noted.
 3. Do not scale from this drawing - if in doubt ask.
 4. Any construction or materials to be used on site prior to commencement of work or preparation of a shop drawing must be checked on site prior to commencement of work or preparation of a shop drawing.
 5. The contractor shall report any discrepancies in information in writing to the design team at the earliest opportunity.
 6. This drawing is to be read in conjunction with the following relevant information:
 - a) All architects and structural engineers drawings and specifications.
 - b) All CDM information including designers risk assessments.

revision	notes	status	date	author	reviewer
K	RECORD DRAWING ISSUE	P	2015.09.17	MB	-
J	studio signage numbers added	P	2015.09.04	MB	-
H	Stud walls indicated where required	P	2015.05.15	MB	-
G	TENDER ISSUE STAGE 2	P	2015.03.25	MB	-
F	Plans updated to reflect comments received DTM	P	2015.03.10	MB	DAS
E	- fixtures updated to reflect colleague comments	P	2015.03.22	MB	DAS
D	- fixtures updated to reflect colleague comments	P	2015.02.10	MB	-
C	Layouts updated to reflect floors below	P	2015.02.10	MB	-
B	ROOM LAYOUTS INDICATED	P	2015.01.25	MB	-
A	PD APPLICATION ISSUE	P	2015.01.16	MB	TS
-	First Issue	P			

Bywater Capital (St Giles) Ltd
46 James Street
London W1U 1EZ
United Kingdom

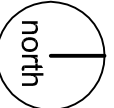

design
architecture
interiors
urban design
masterplanning
graphic design
conservation

Studio 2, Riverside Centre, Finsbury Lane, Durham, DH1 5TA
t: 0191 447 1775
www.greenwelldesign.co.uk

Project
St Giles House,

Reading

PROPOSED LEVEL 2
27 No. (C3 Residential)

Scale: 1:100	Job no.: 14 038	Dwg no.: 112 Prop L2	Rev.: K
at size: A1	Status: RECORD		

Do not scale. This drawing is copyright

14038_112 Prop L2 / 01
ST GILES HOUSE - PROPOSED LEVEL 2 PLAN
scale 1:100