



NOTES:
FOR ALL INTERNAL REPAIRS TO ROOF PLEASE REFER SECTION 3.2.7 ON STRUCTURAL REPORT.


FOR ALL REPAIRS TO INTERNAL ROOMS REFER SECTION 3.2.8 ON STRUCTURAL REPORT.

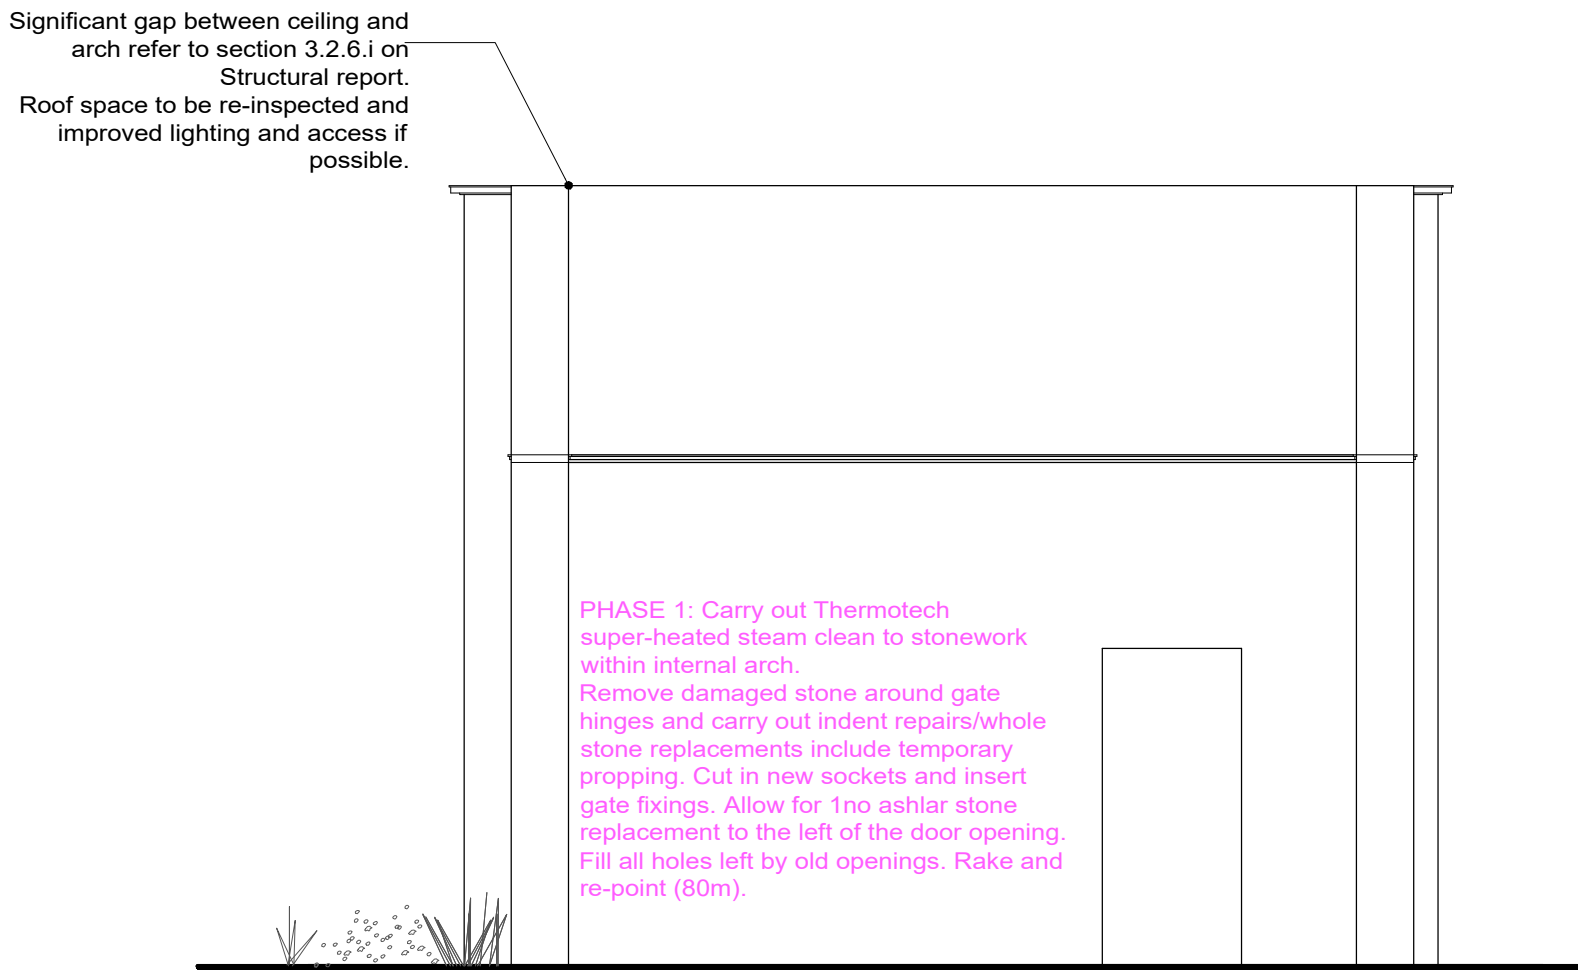

Internal north elevation

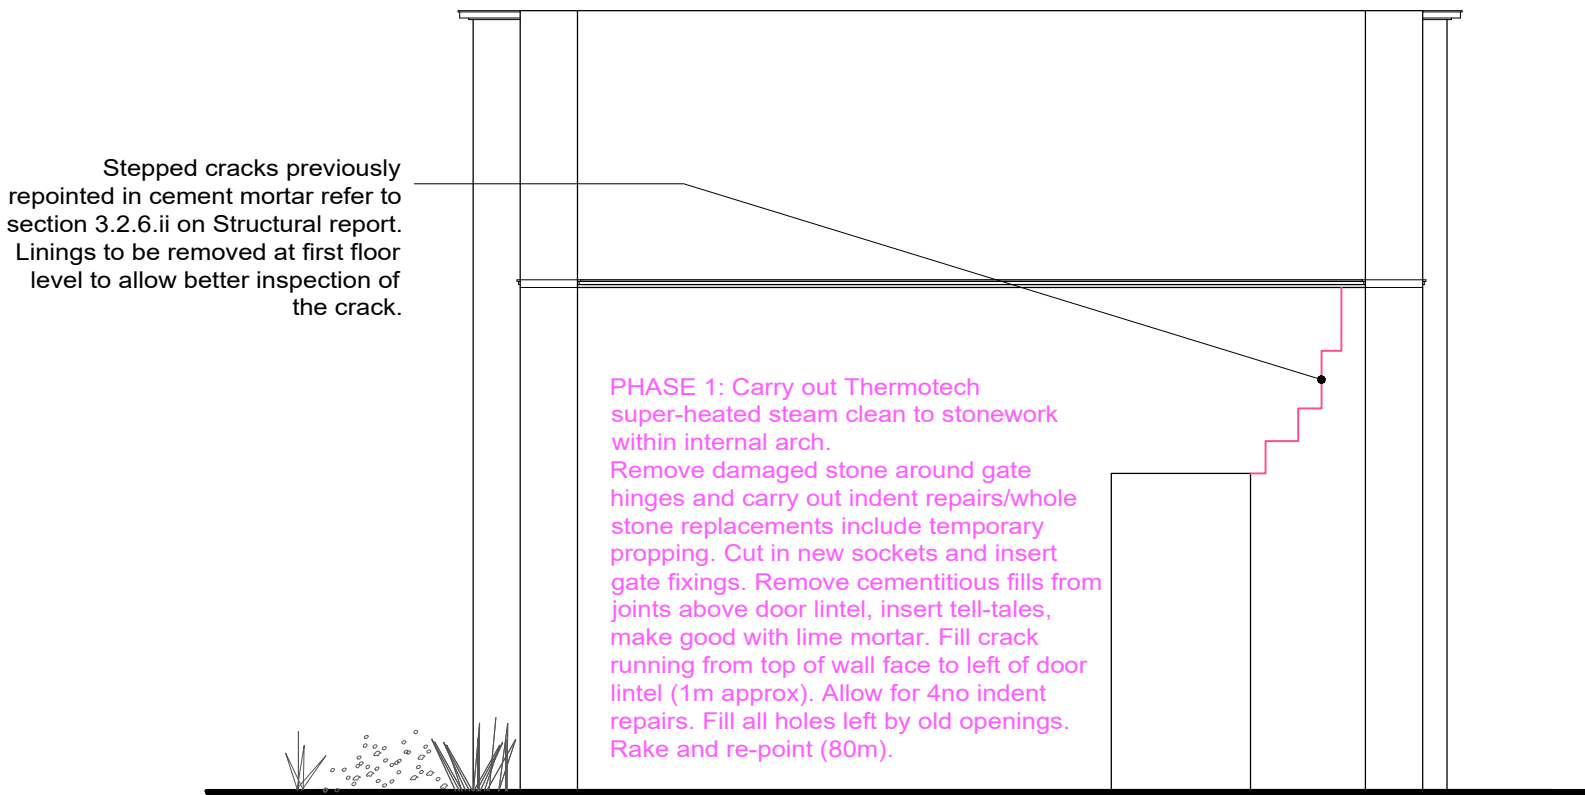

Internal south elevation

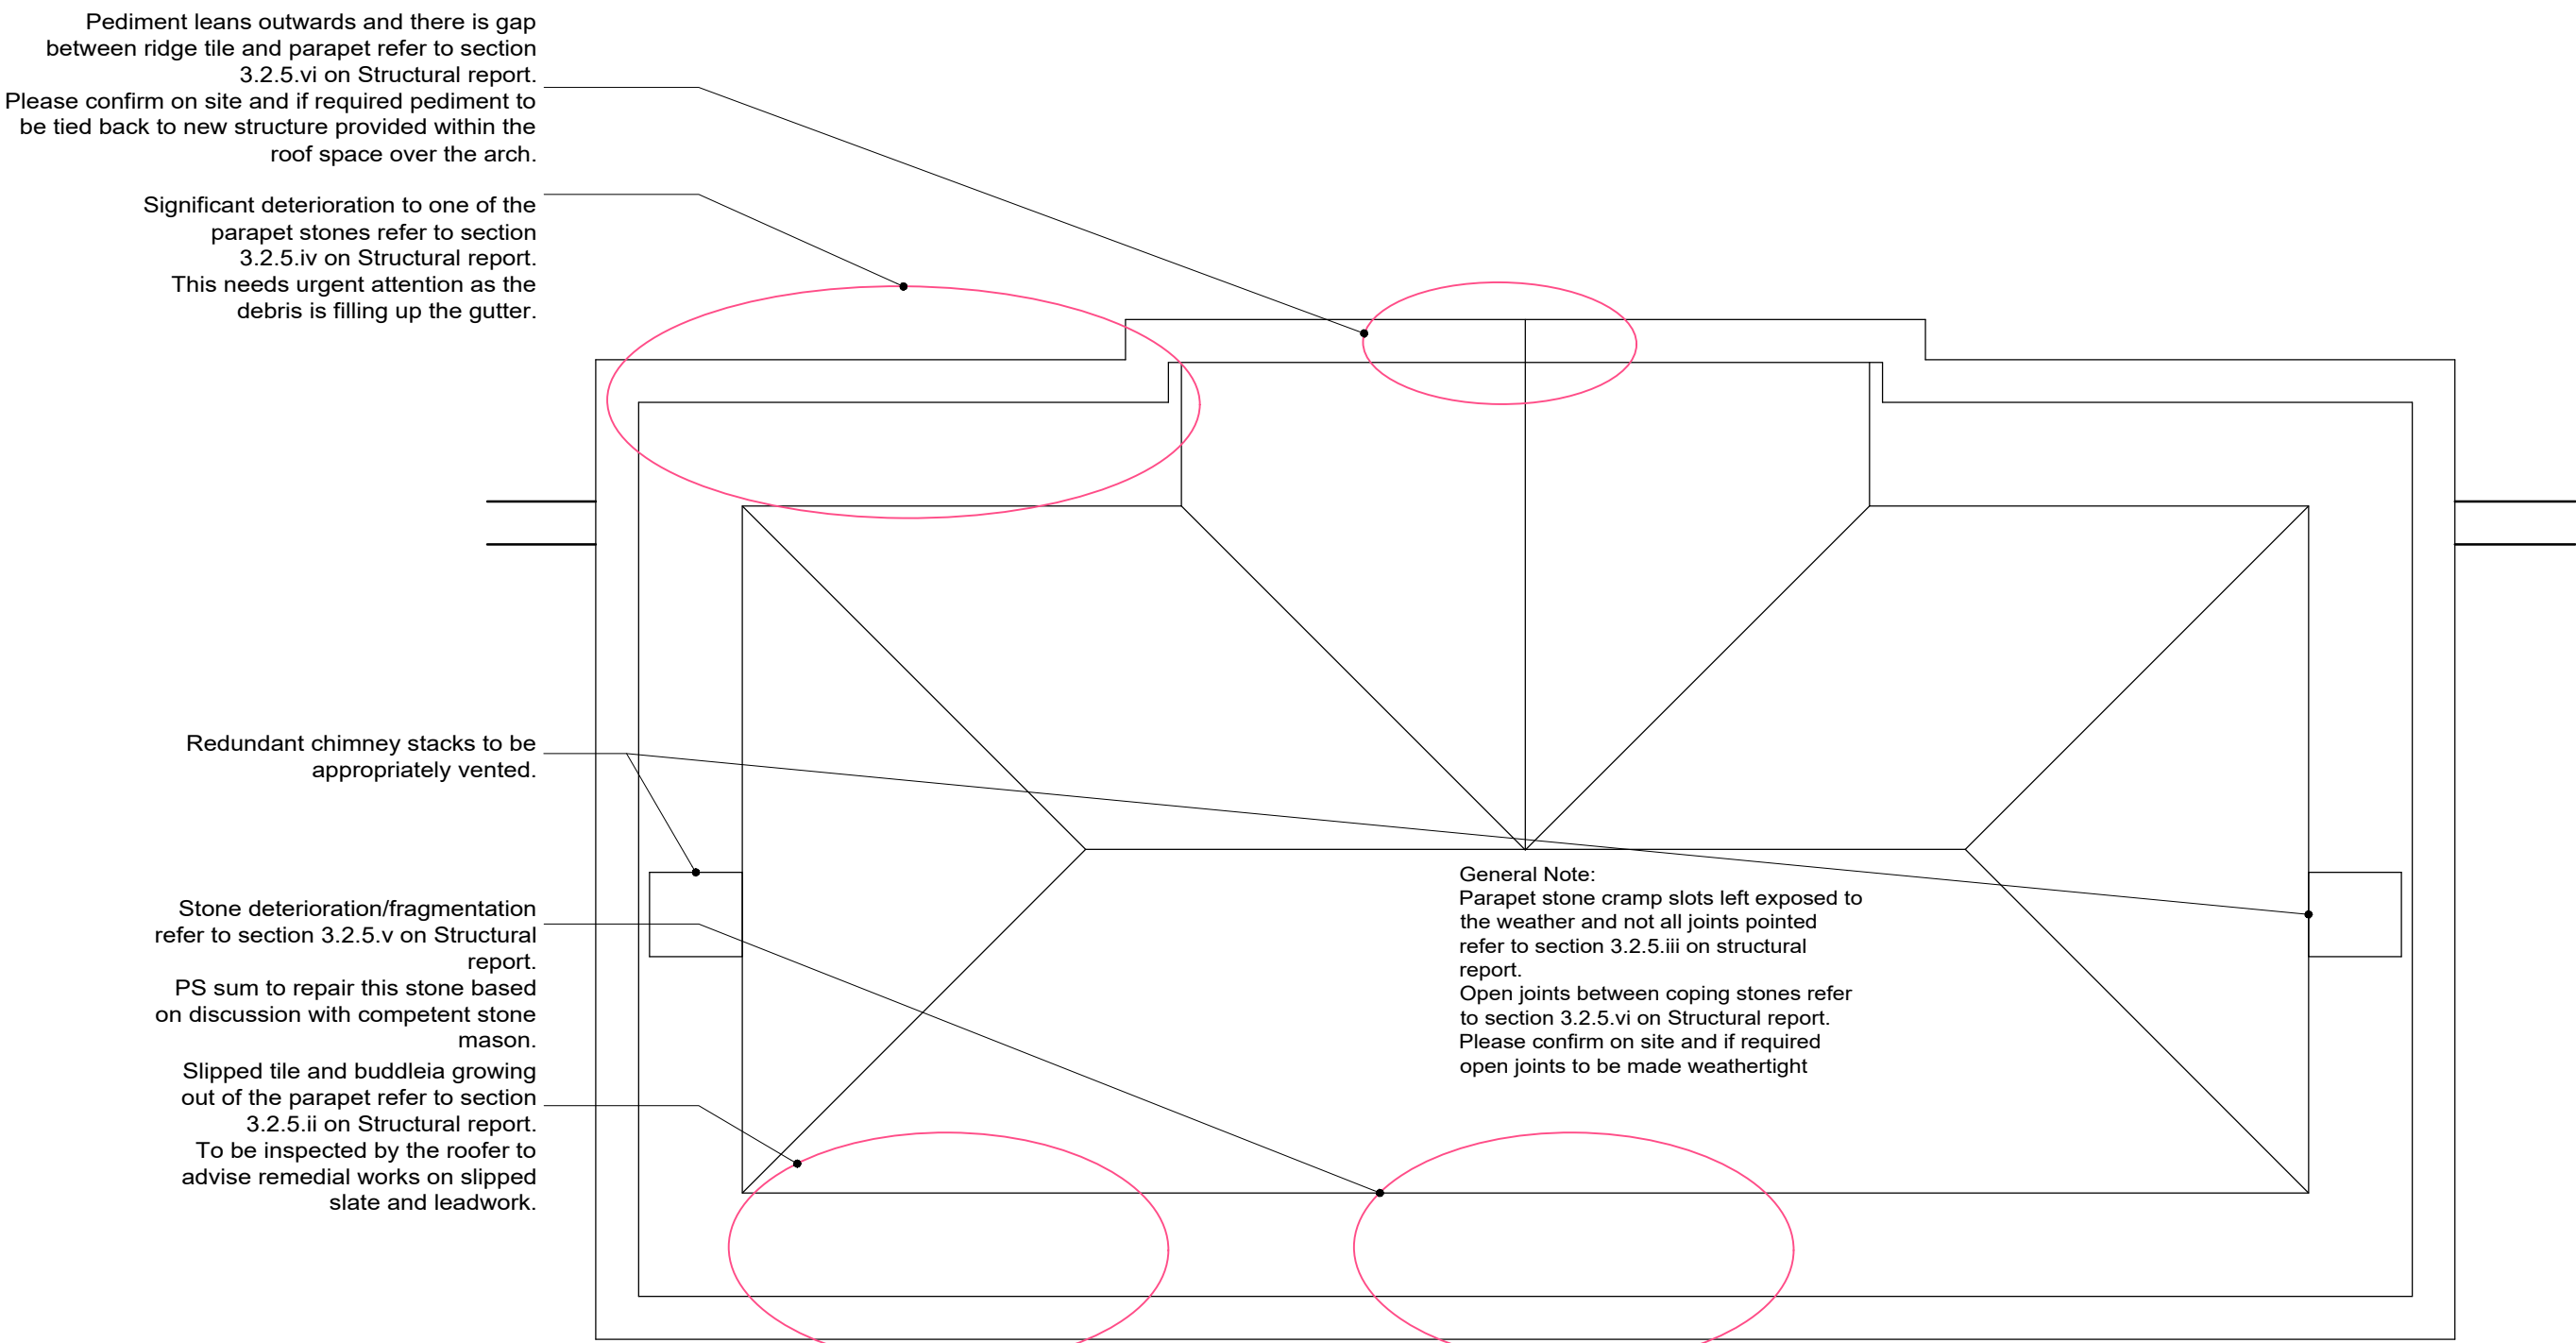

PHASE 1: To inspect all areas of pediment and parapets from roof gully once accessible.

Roof Plan

REV	COMMENTS	DATE
-----	----------	------



SHAUN•TANNER

ARCHITECTURE & PLANNING

www.stlarchitecture.co.ukstudio@stlarchitecture.co.uk0118 989 0808

CLIENT Reading Borough Council - Mr S Hicks
PROJECT Cemetery Arch
Repair Schedule
DRAWING Roof Plan and Internal Elevations: Phase 1 and 2

STATUS CONSERVATION MARK-UP
SCALE 1:50
DRAWN CD
CHECKED NO
3959/202
REV B
DATE Sept 2024

THIS DRAWING MUST NOT BE SCALED UNLESS ISSUED FOR PLANNING PURPOSES. ALL DIMENSIONS ARE TO BE VERIFIED PRIOR TO SETTING OUT, COMMENCING WORK, OR PRODUCTION OF FABRICATION DRAWINGS. REPORT ANY DISCREPANCIES TO THE SUPERVISING OFFICER IMMEDIATELY. ©