




KEY

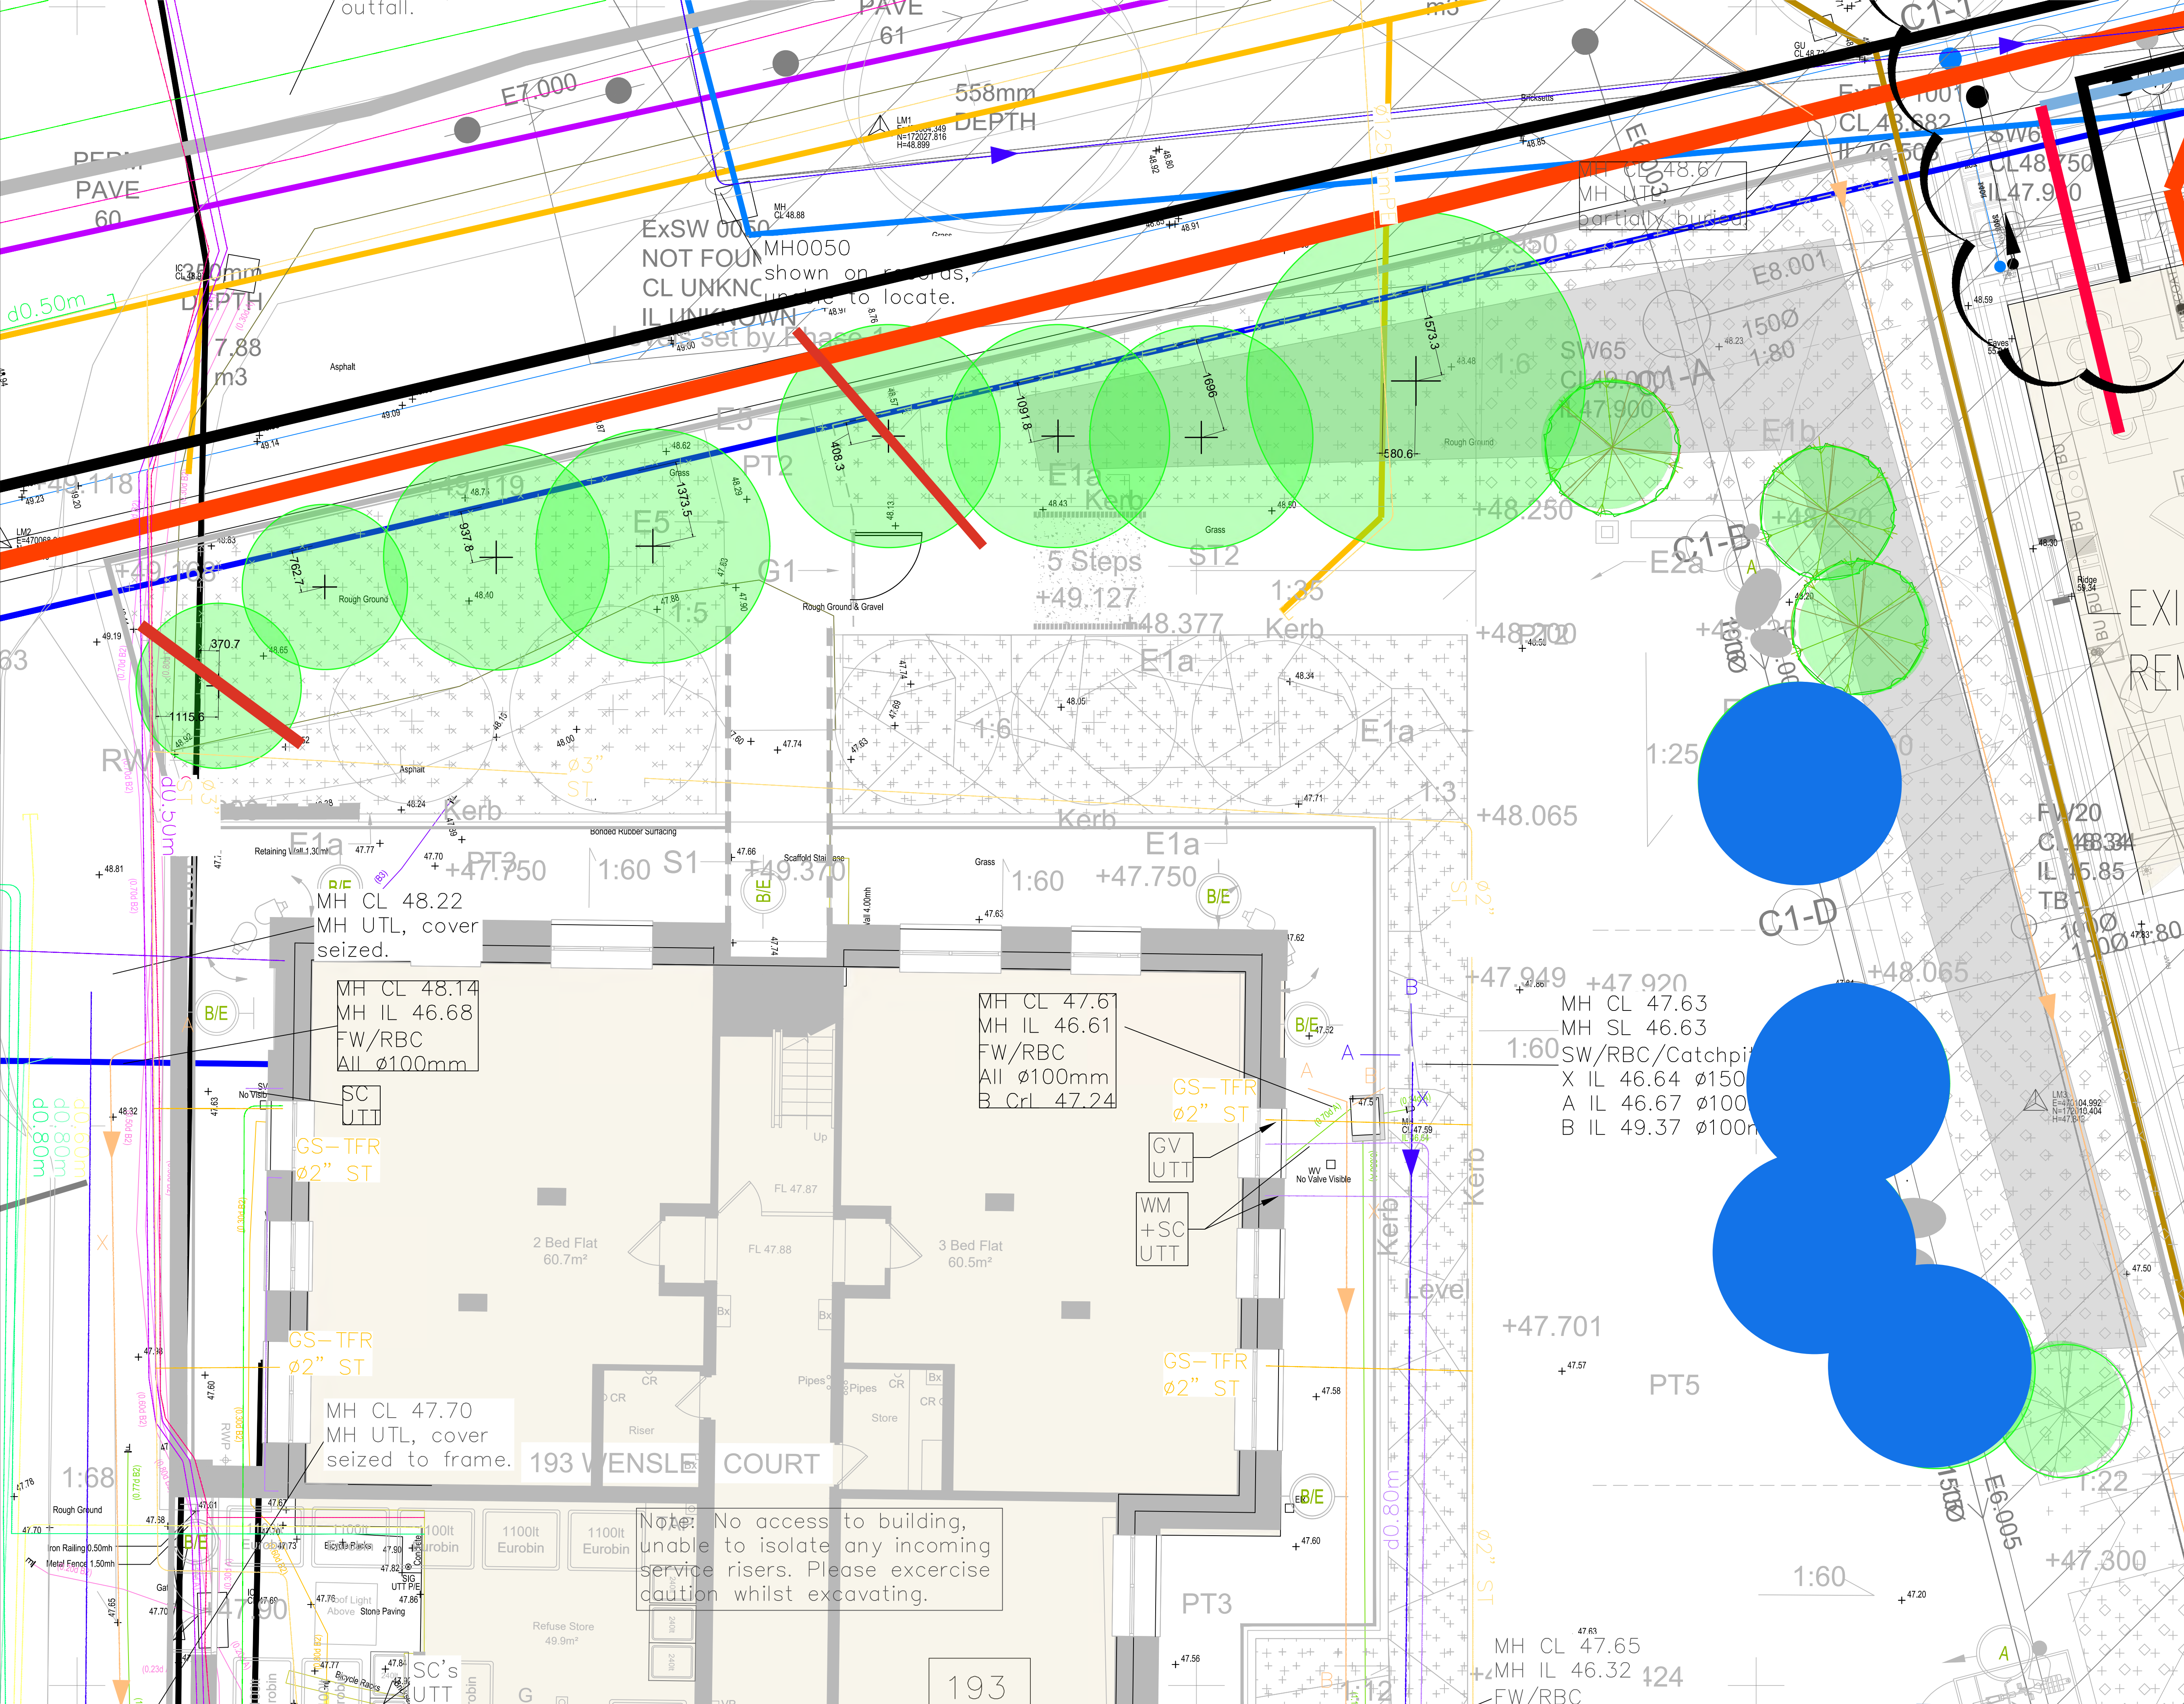

PROPOSED PLANTING WITHIN
2 METERS OF SERVICE ROUTE

- 2 Trees to be relocated

- All other identified trees could be moved further away from service.

- 4 no trees identified (in blue) are in pots and not affected by service clashes

HTA Comments

JRW NTS

Do not scale this drawing
Do not derive dimensions from digital med

Drawing No:
7430-ARC-GL-SK-006

12.08.24


© Drawing & Design Copyright c

Arcus Consulting Ltd
www.arcus.uk.com
info@arcus.uk.com


ARCUS
CONSULTING

Newcastle	0191 272 5781
Manchester	0161 905 3222
Liverpool	0151 708 1080
Cambridge	0122 325 7706
Wokefield	0192 468 9000

PLANTING / SERVICES CLASH DETECTION - 193 WENSLEY COURT - NORTH

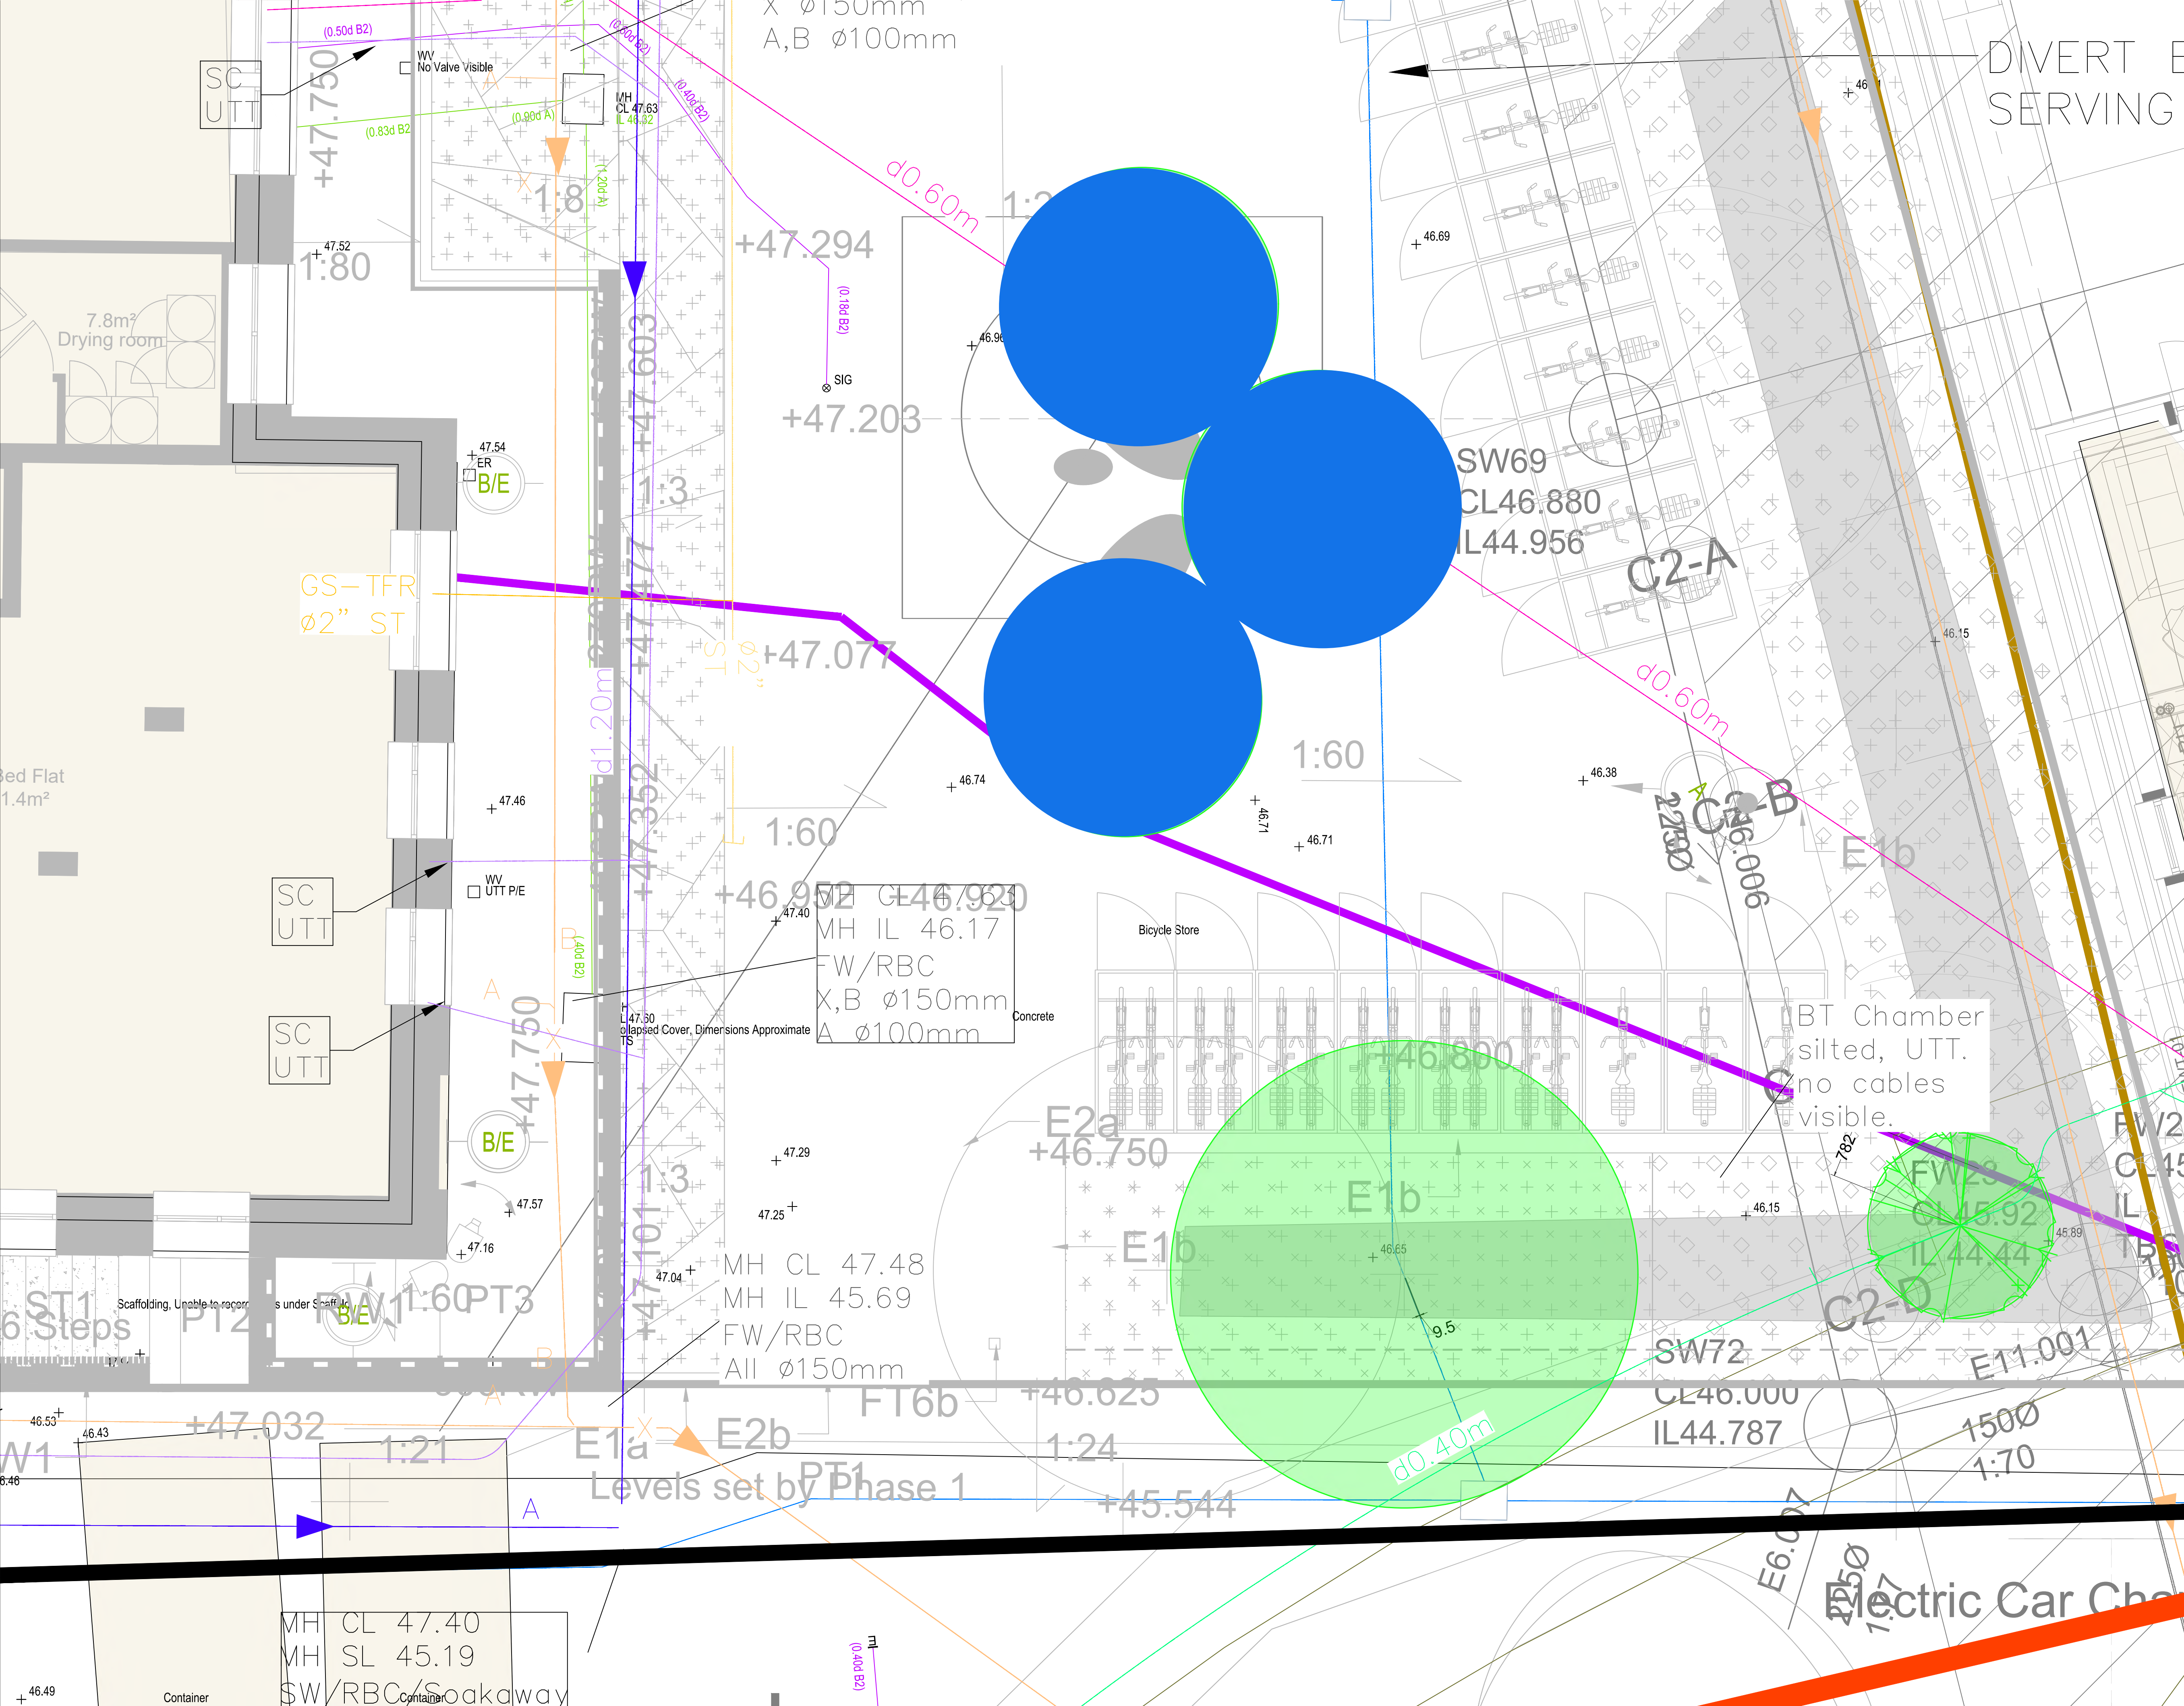

KEY

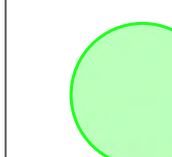

PROPOSED PLANTING WITHIN
2 METERS OF SERVICE ROUTE

- 2 other trees identified trees could be moved further away from service.

- 3 no trees identified (in blue) are in pots and not affected by service clashes

HTA Comments

JRW NTS

Drawing No:
7430-ARC-GL-SK-007

© Drawing & Design Copyright ©

Arcus Consulting Ltd
www.arcus.uk.com
info@arcus.uk.com

ARCUS
CONSULTING


Newcastle	0191 272 5781
Manchester	0161 905 3222
Liverpool	0151 708 1080
Cambridge	0122 325 7706

PLANTING / SERVICES CLASH DETECTION - 193 WENSLEY COURT - EAST

- 3no trees with red strike through: To be relocated.
- 1no tree in yellow: Installed under phase 1.
- 2no trees in red: Unclear as to left hand service constraint, both can be moved 2m clear of service constrain to the right.
- 1no trees in blue: Tree is in pot so is clear of services
- All other identified trees could be adjusted locally to achieve 2m clear zone.

HTA Comments

JRW NTS

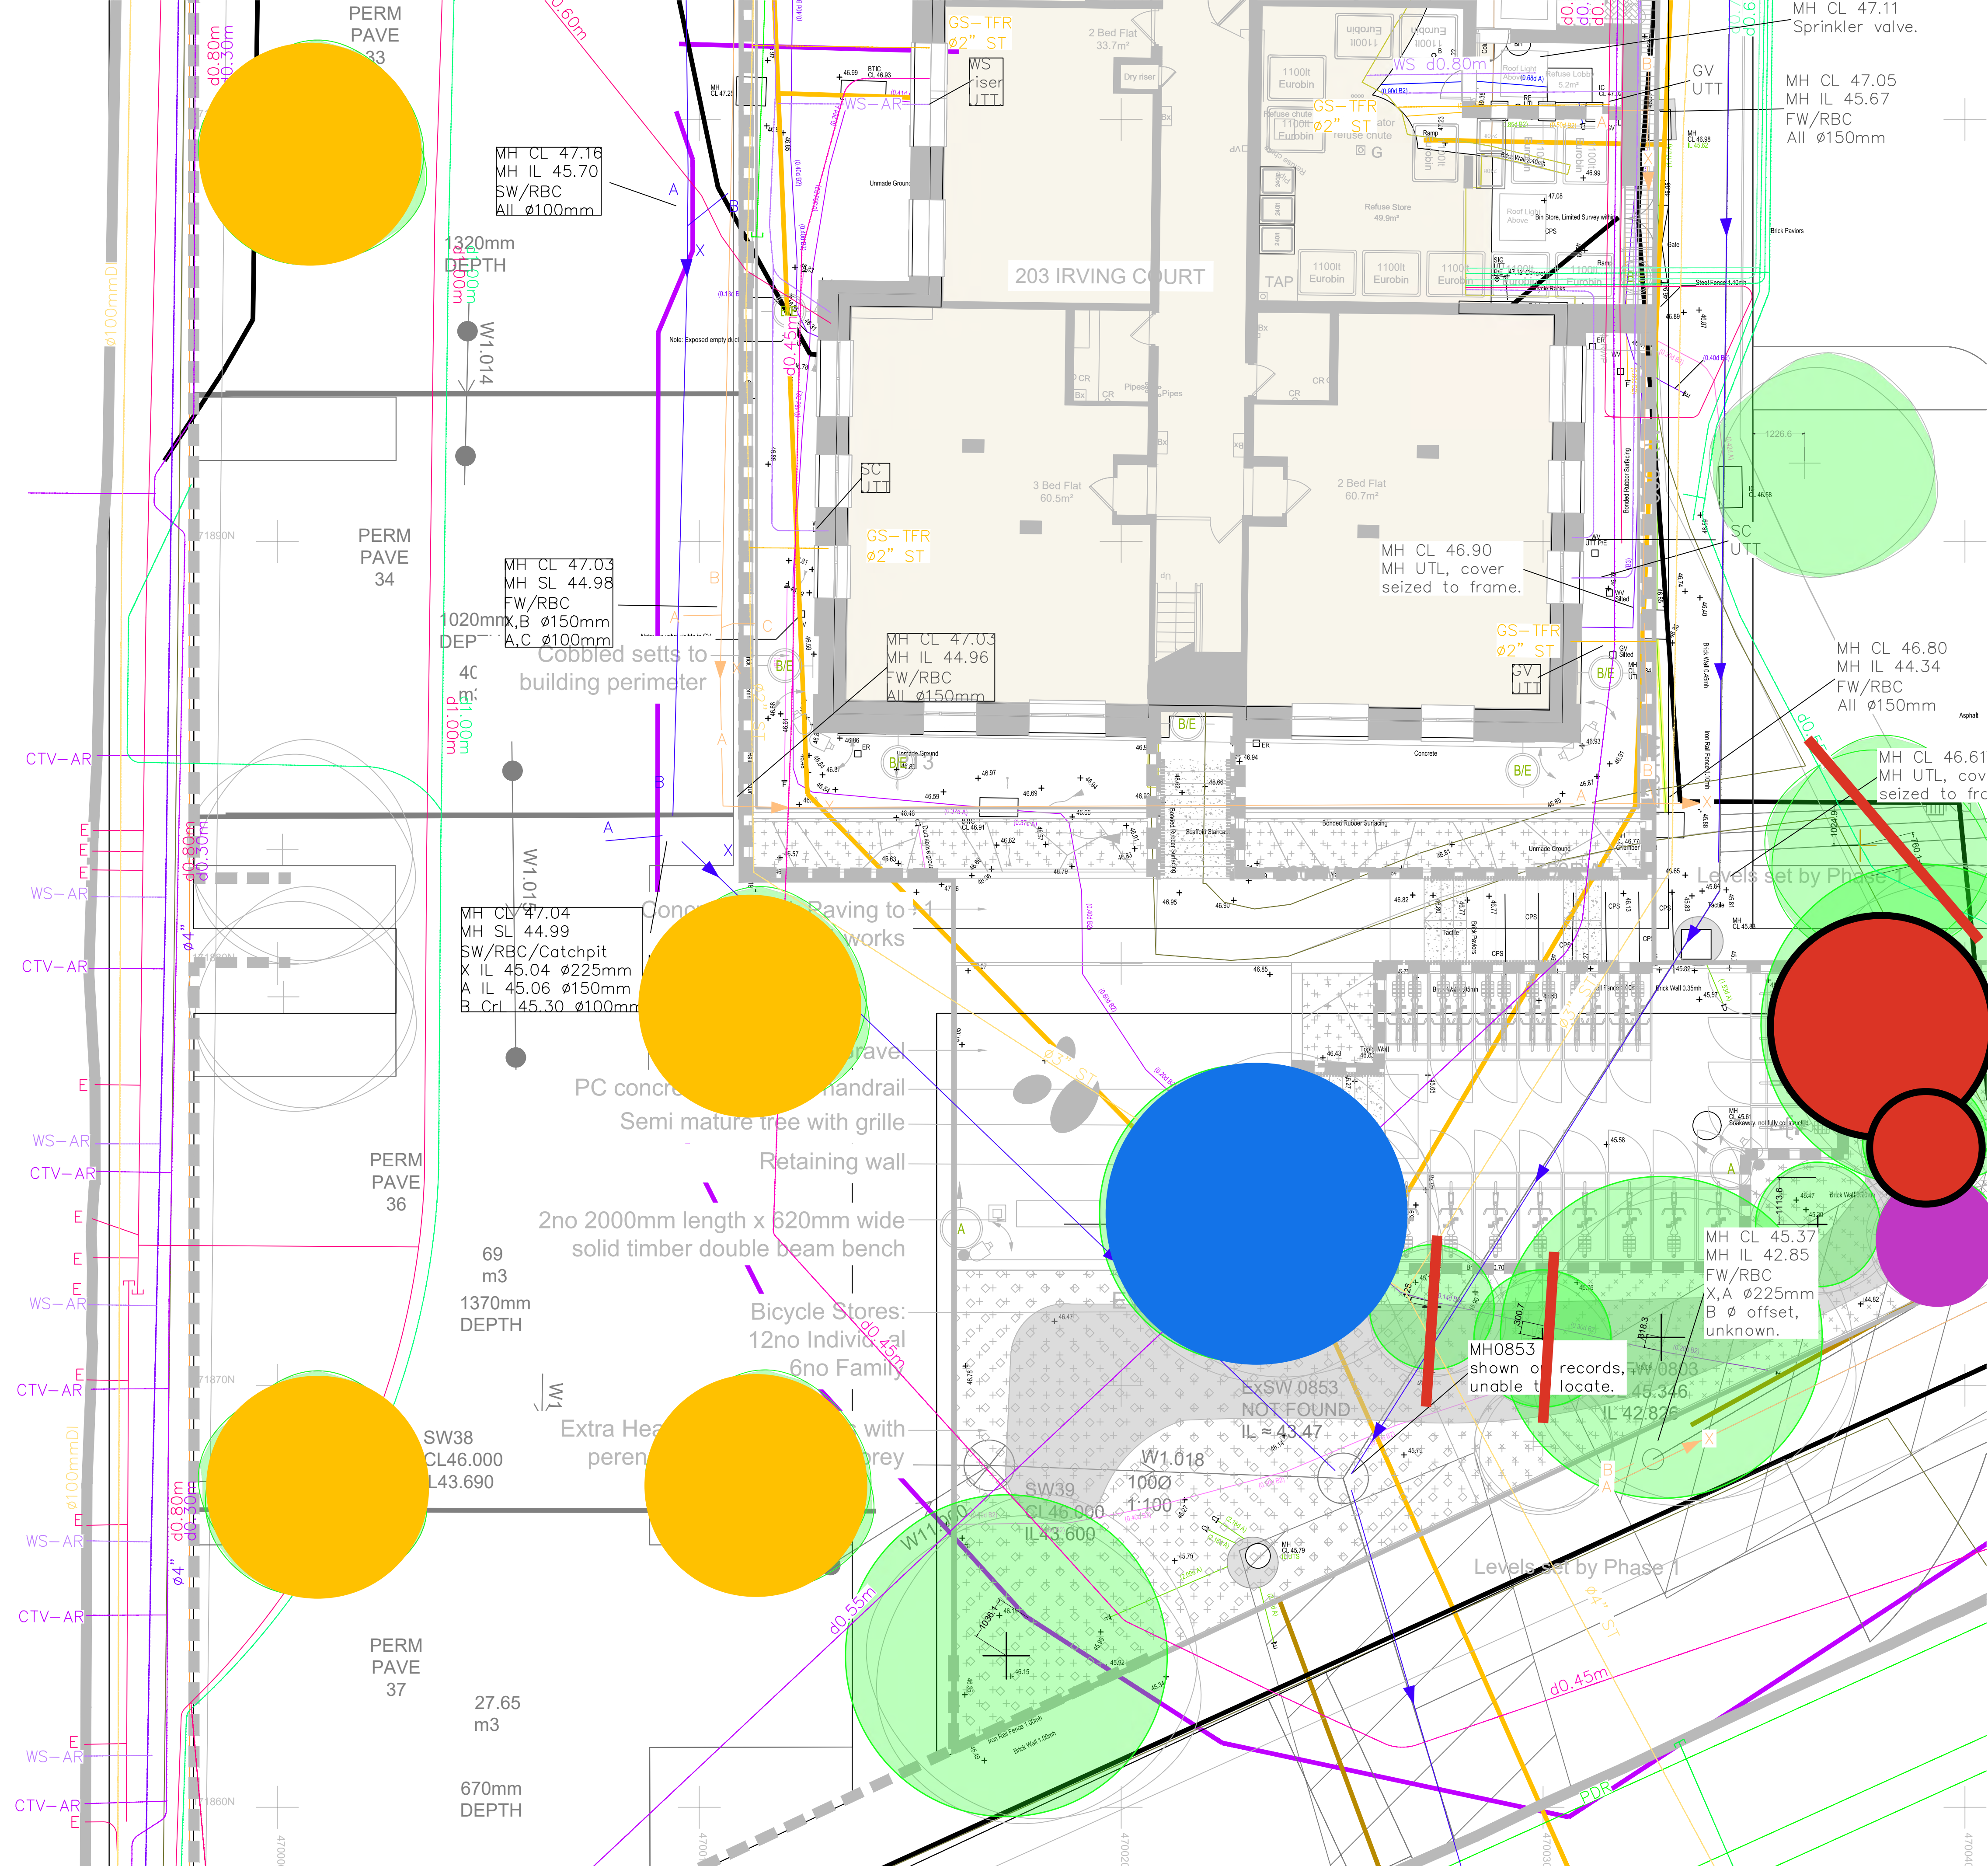

- 3no trees with red strike through: To be relocated.

- 4no trees in yellow: Installed under phase 1.

- 2no trees in red: Unclear as to left hand service constraint, both can be moved 2m clear of service constrain to the right.

- 1no trees in blue: Tree is in a pot so clear of services

- All other identified trees could be adjusted locally to achieve 2m clear zone.

HTA Comments

JRW NTS

Do not scale this drawing
Do not derive dimensions from digital media

Drawing No:
7430-ARC-GL-SK-009


12.08.24

© Drawing & Design Copyright of:

ARCUS
CONSULTING

Arcus Consulting LLP
www.arcus.uk.com
info@arcus.uk.com

Newcastle 0191 272 5781
Manchester 0161 965 3222
Liverpool 0151 708 1060
Walsley 0122 325 7706
Walsley 0192 466 9000

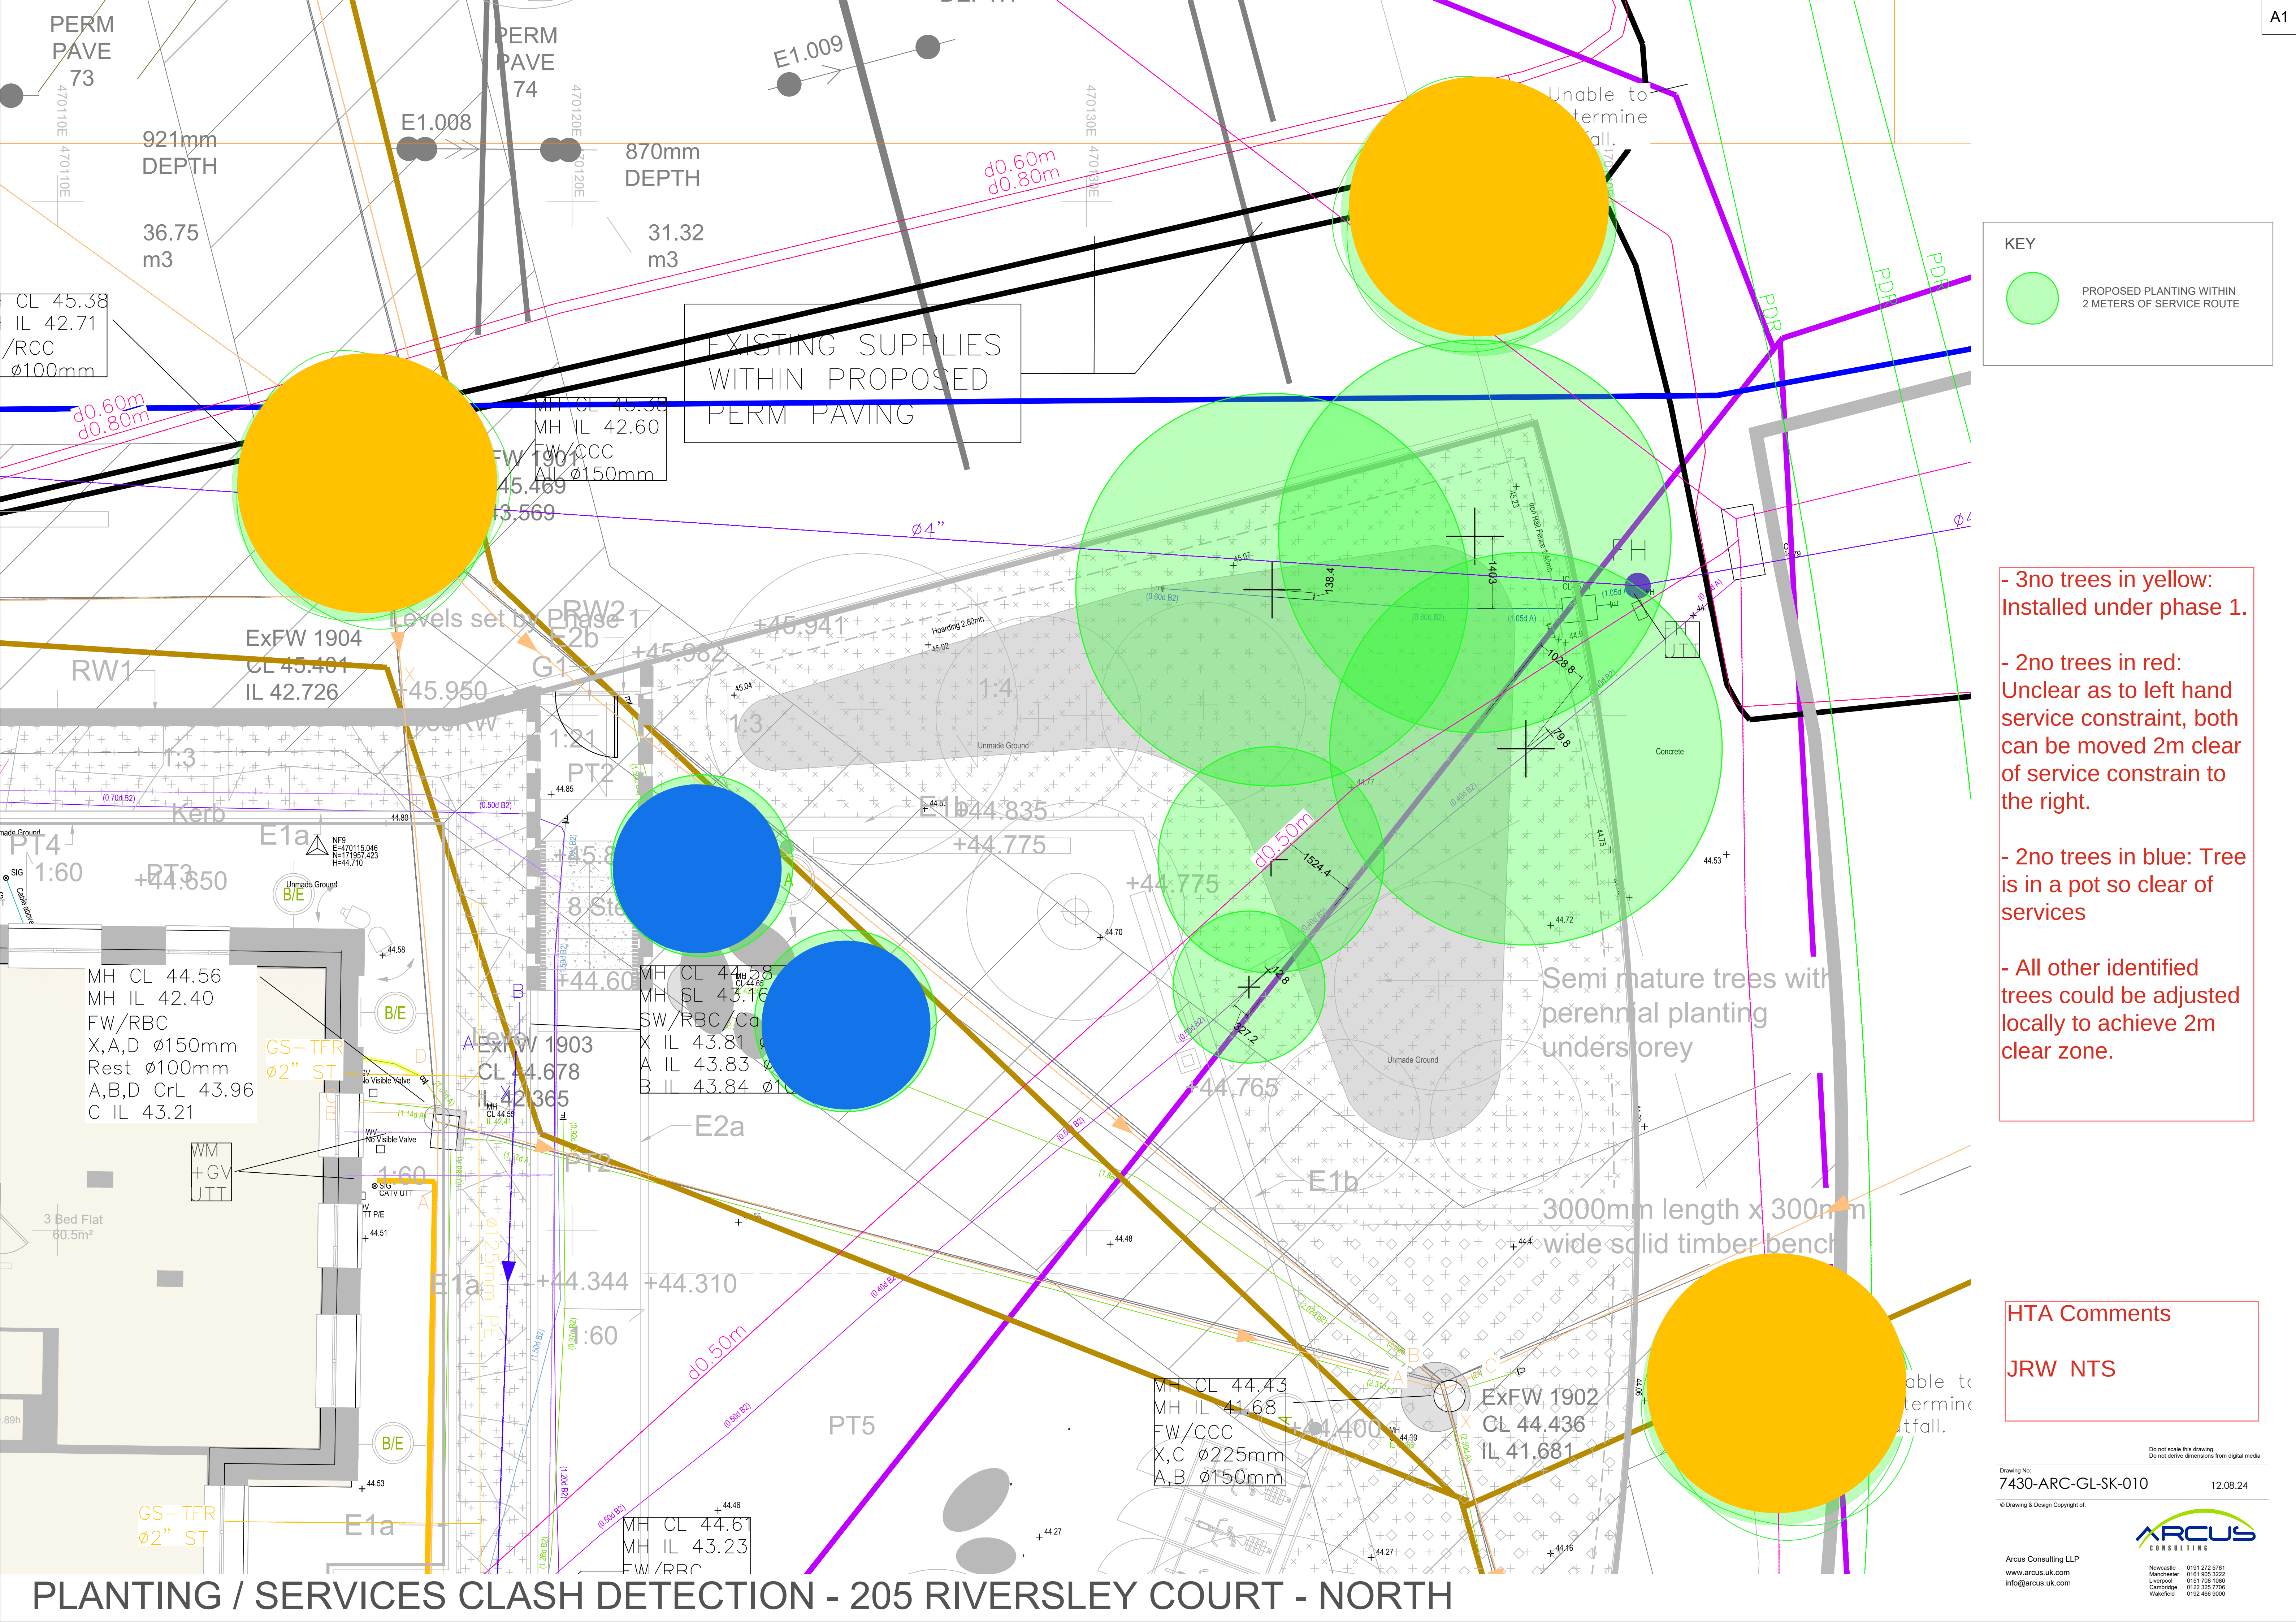

KEY


 PROPOSED PLANTING WITHIN 2 METERS OF SERVICE ROUTE

- 3no trees in yellow:
Installed under phase 1.
- 2no trees in red:
Unclear as to left hand service constraint, both can be moved 2m clear of service constrain to the right.
- 2no trees in blue: Tree is in a pot so clear of services
- All other identified trees could be adjusted locally to achieve 2m clear zone.

HTA Comments

JRW NTS

PLANTING / SERVICES CLASH DETECTION - 205 RIVERSLEY COURT - NORTH

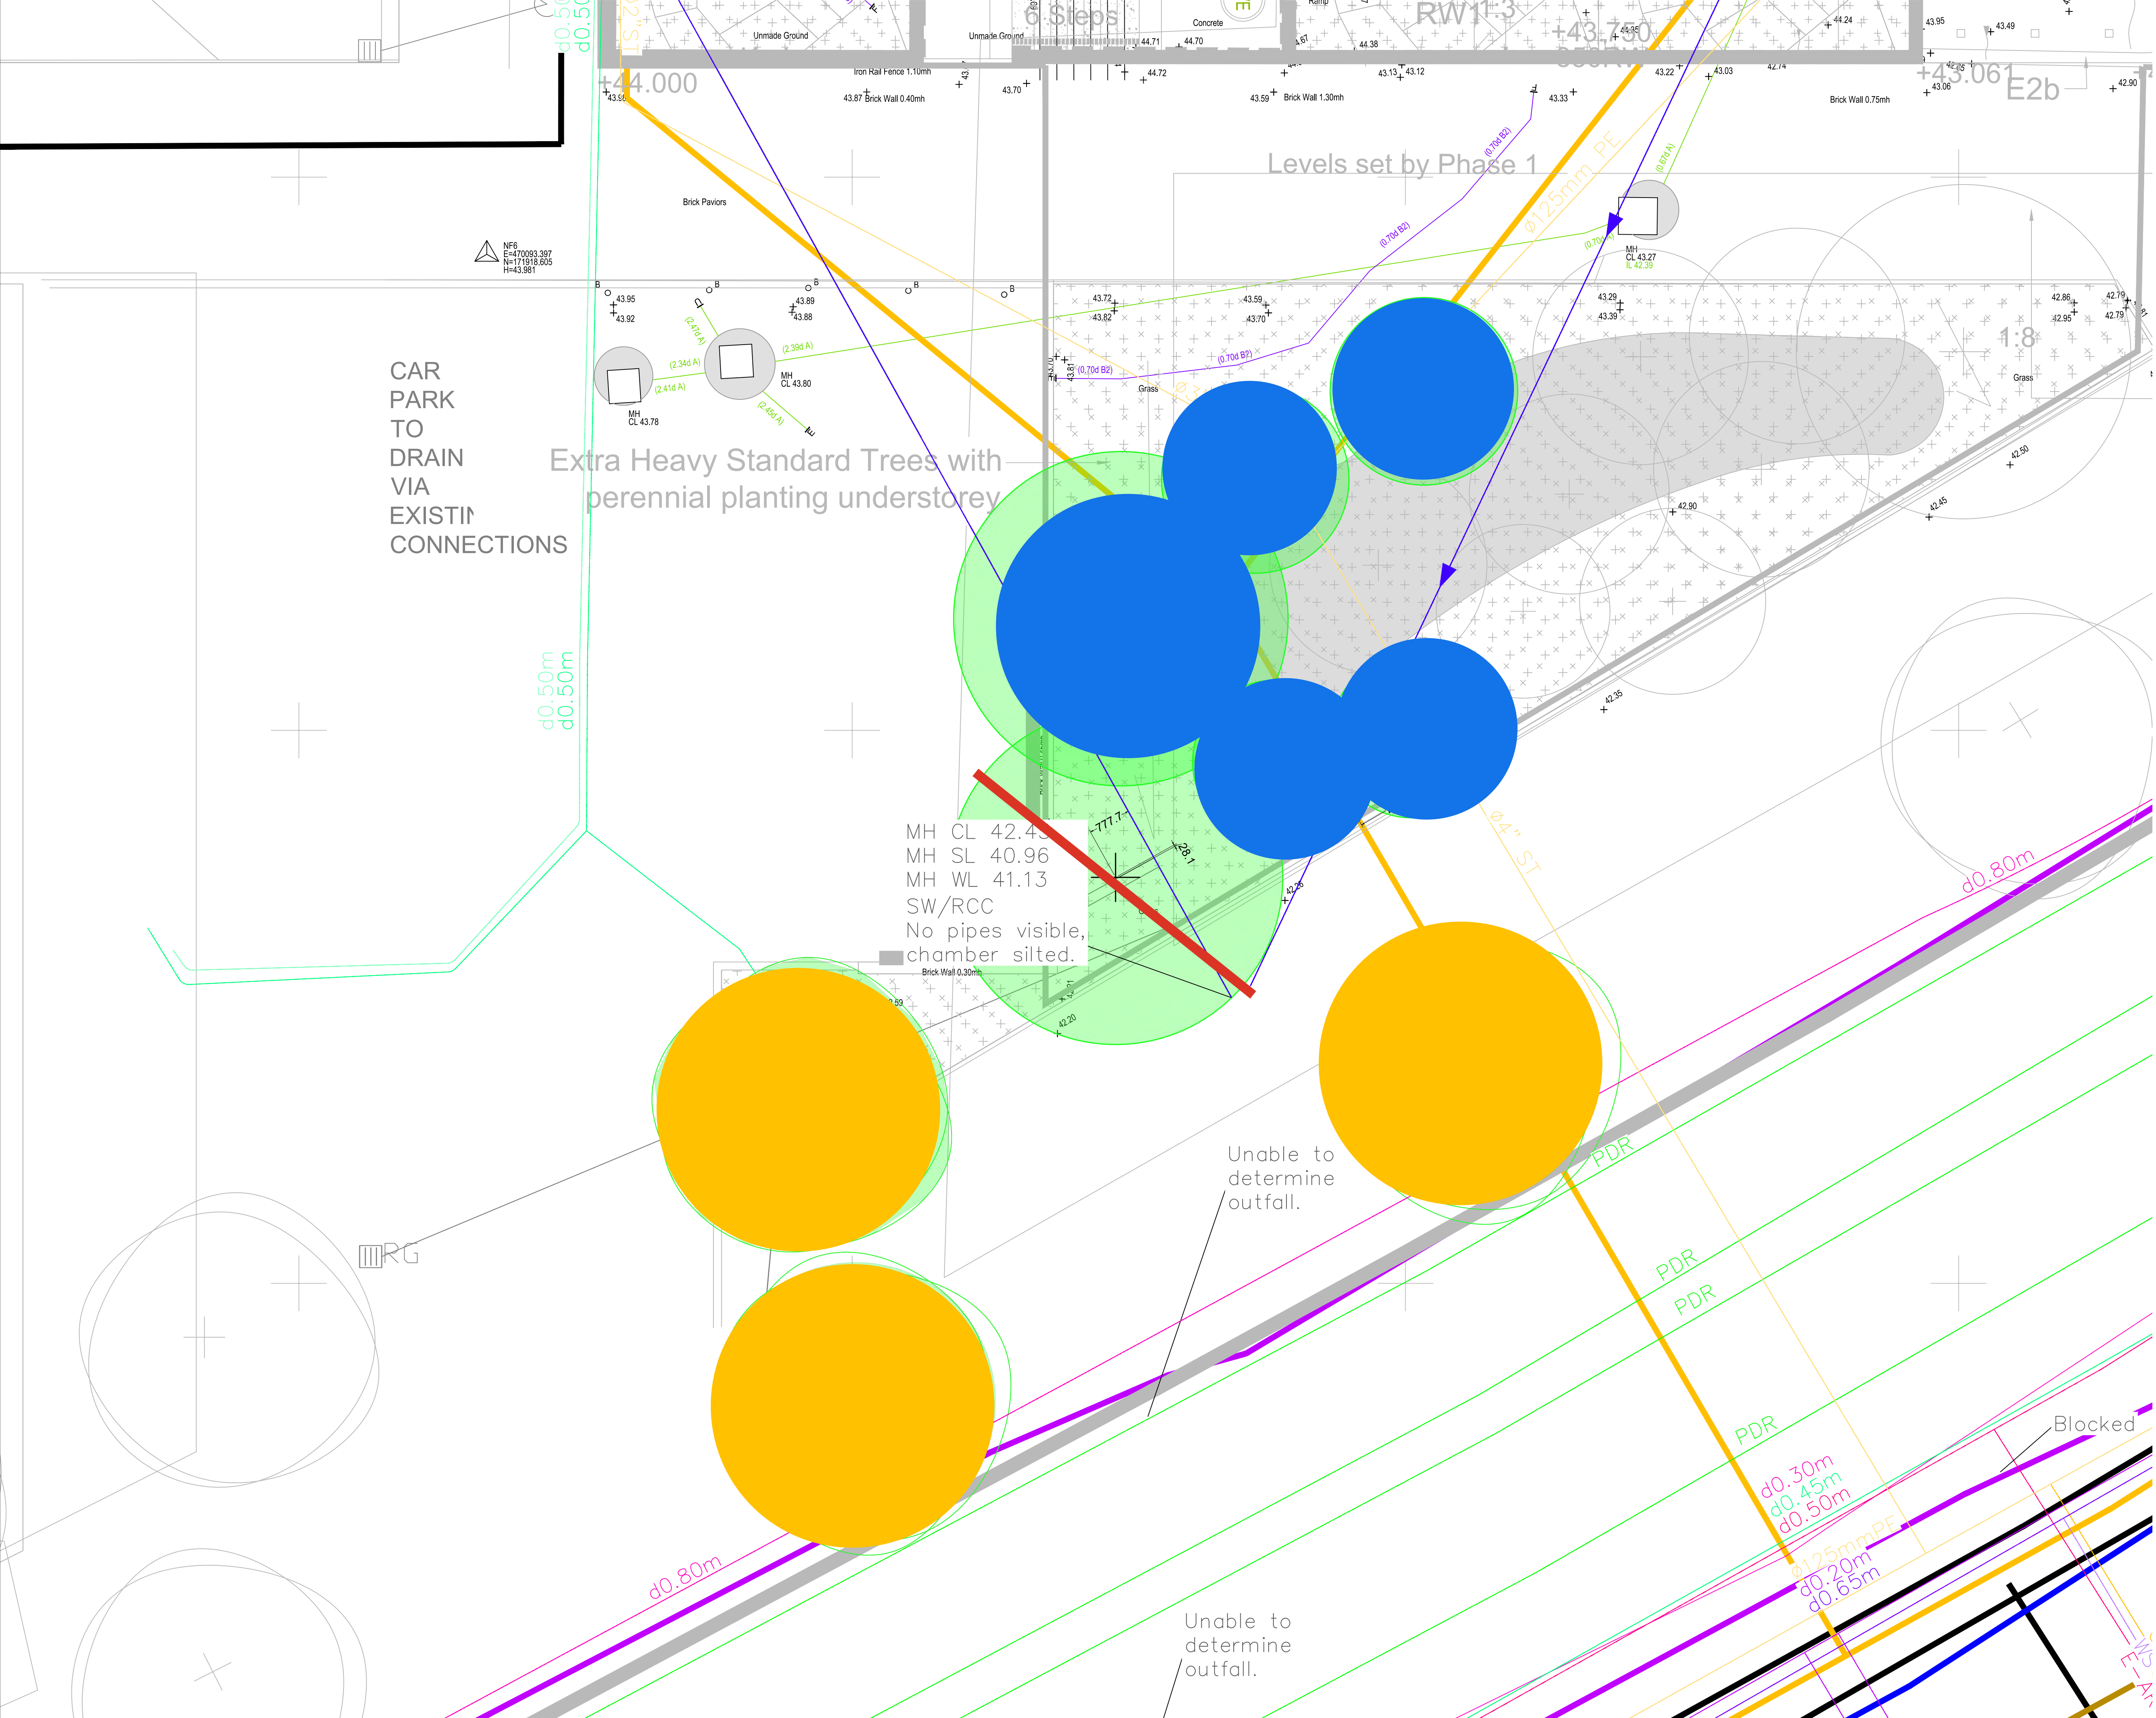

KEY


PROPOSED PLANTING WITHIN 2 METERS OF SERVICE ROUTE

- 1no trees with red strike through: To be relocated.
- 3no trees in yellow: Installed under phase 1.
- 4no trees in blue: Gas main to be broken out. Trees to remain


HTA Comments

JRW NTS

PLANTING / SERVICES CLASH DETECTION - 205 RIVERSLEY COURT - SOUTH

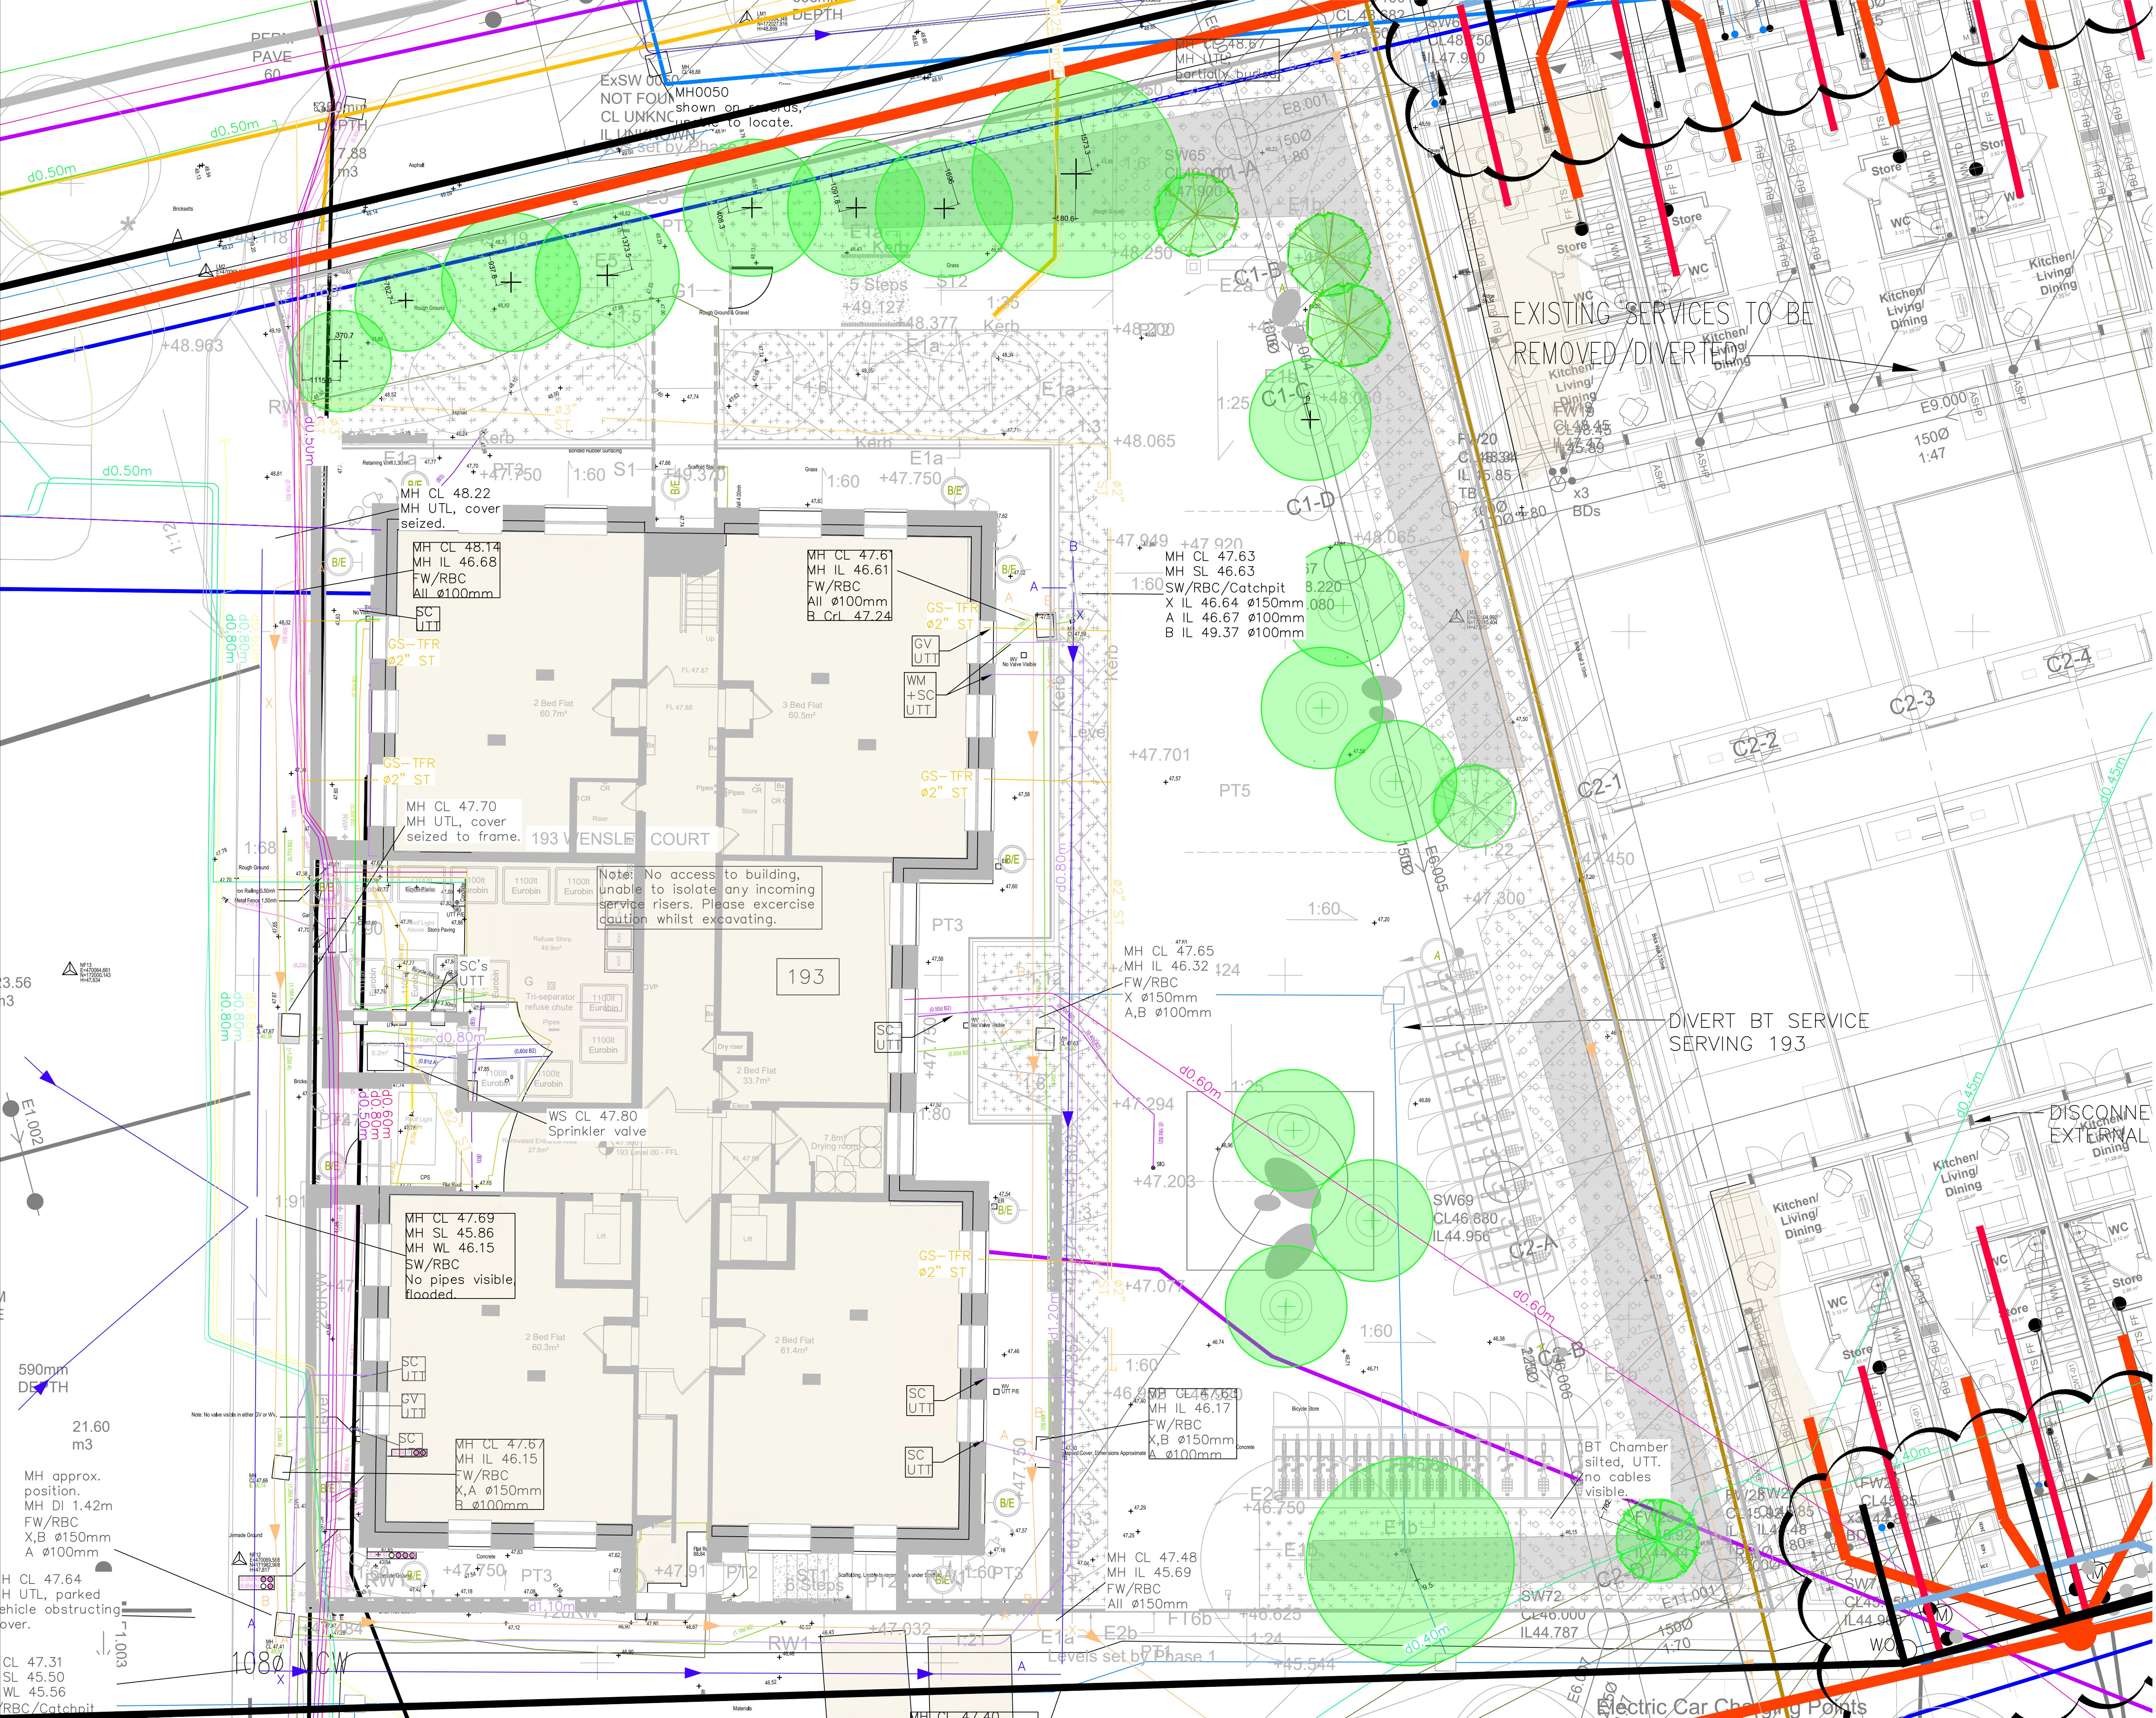

KEY

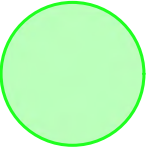
 PROPOSED PLANTING WITHIN 2 METERS OF SERVICE ROUTE

Refer to previous mark-ups on Wensley Court

HTA Comments

JRW NTS

PLANTING / SERVICES CLASH DETECTION - 193 WENSLEY COURT

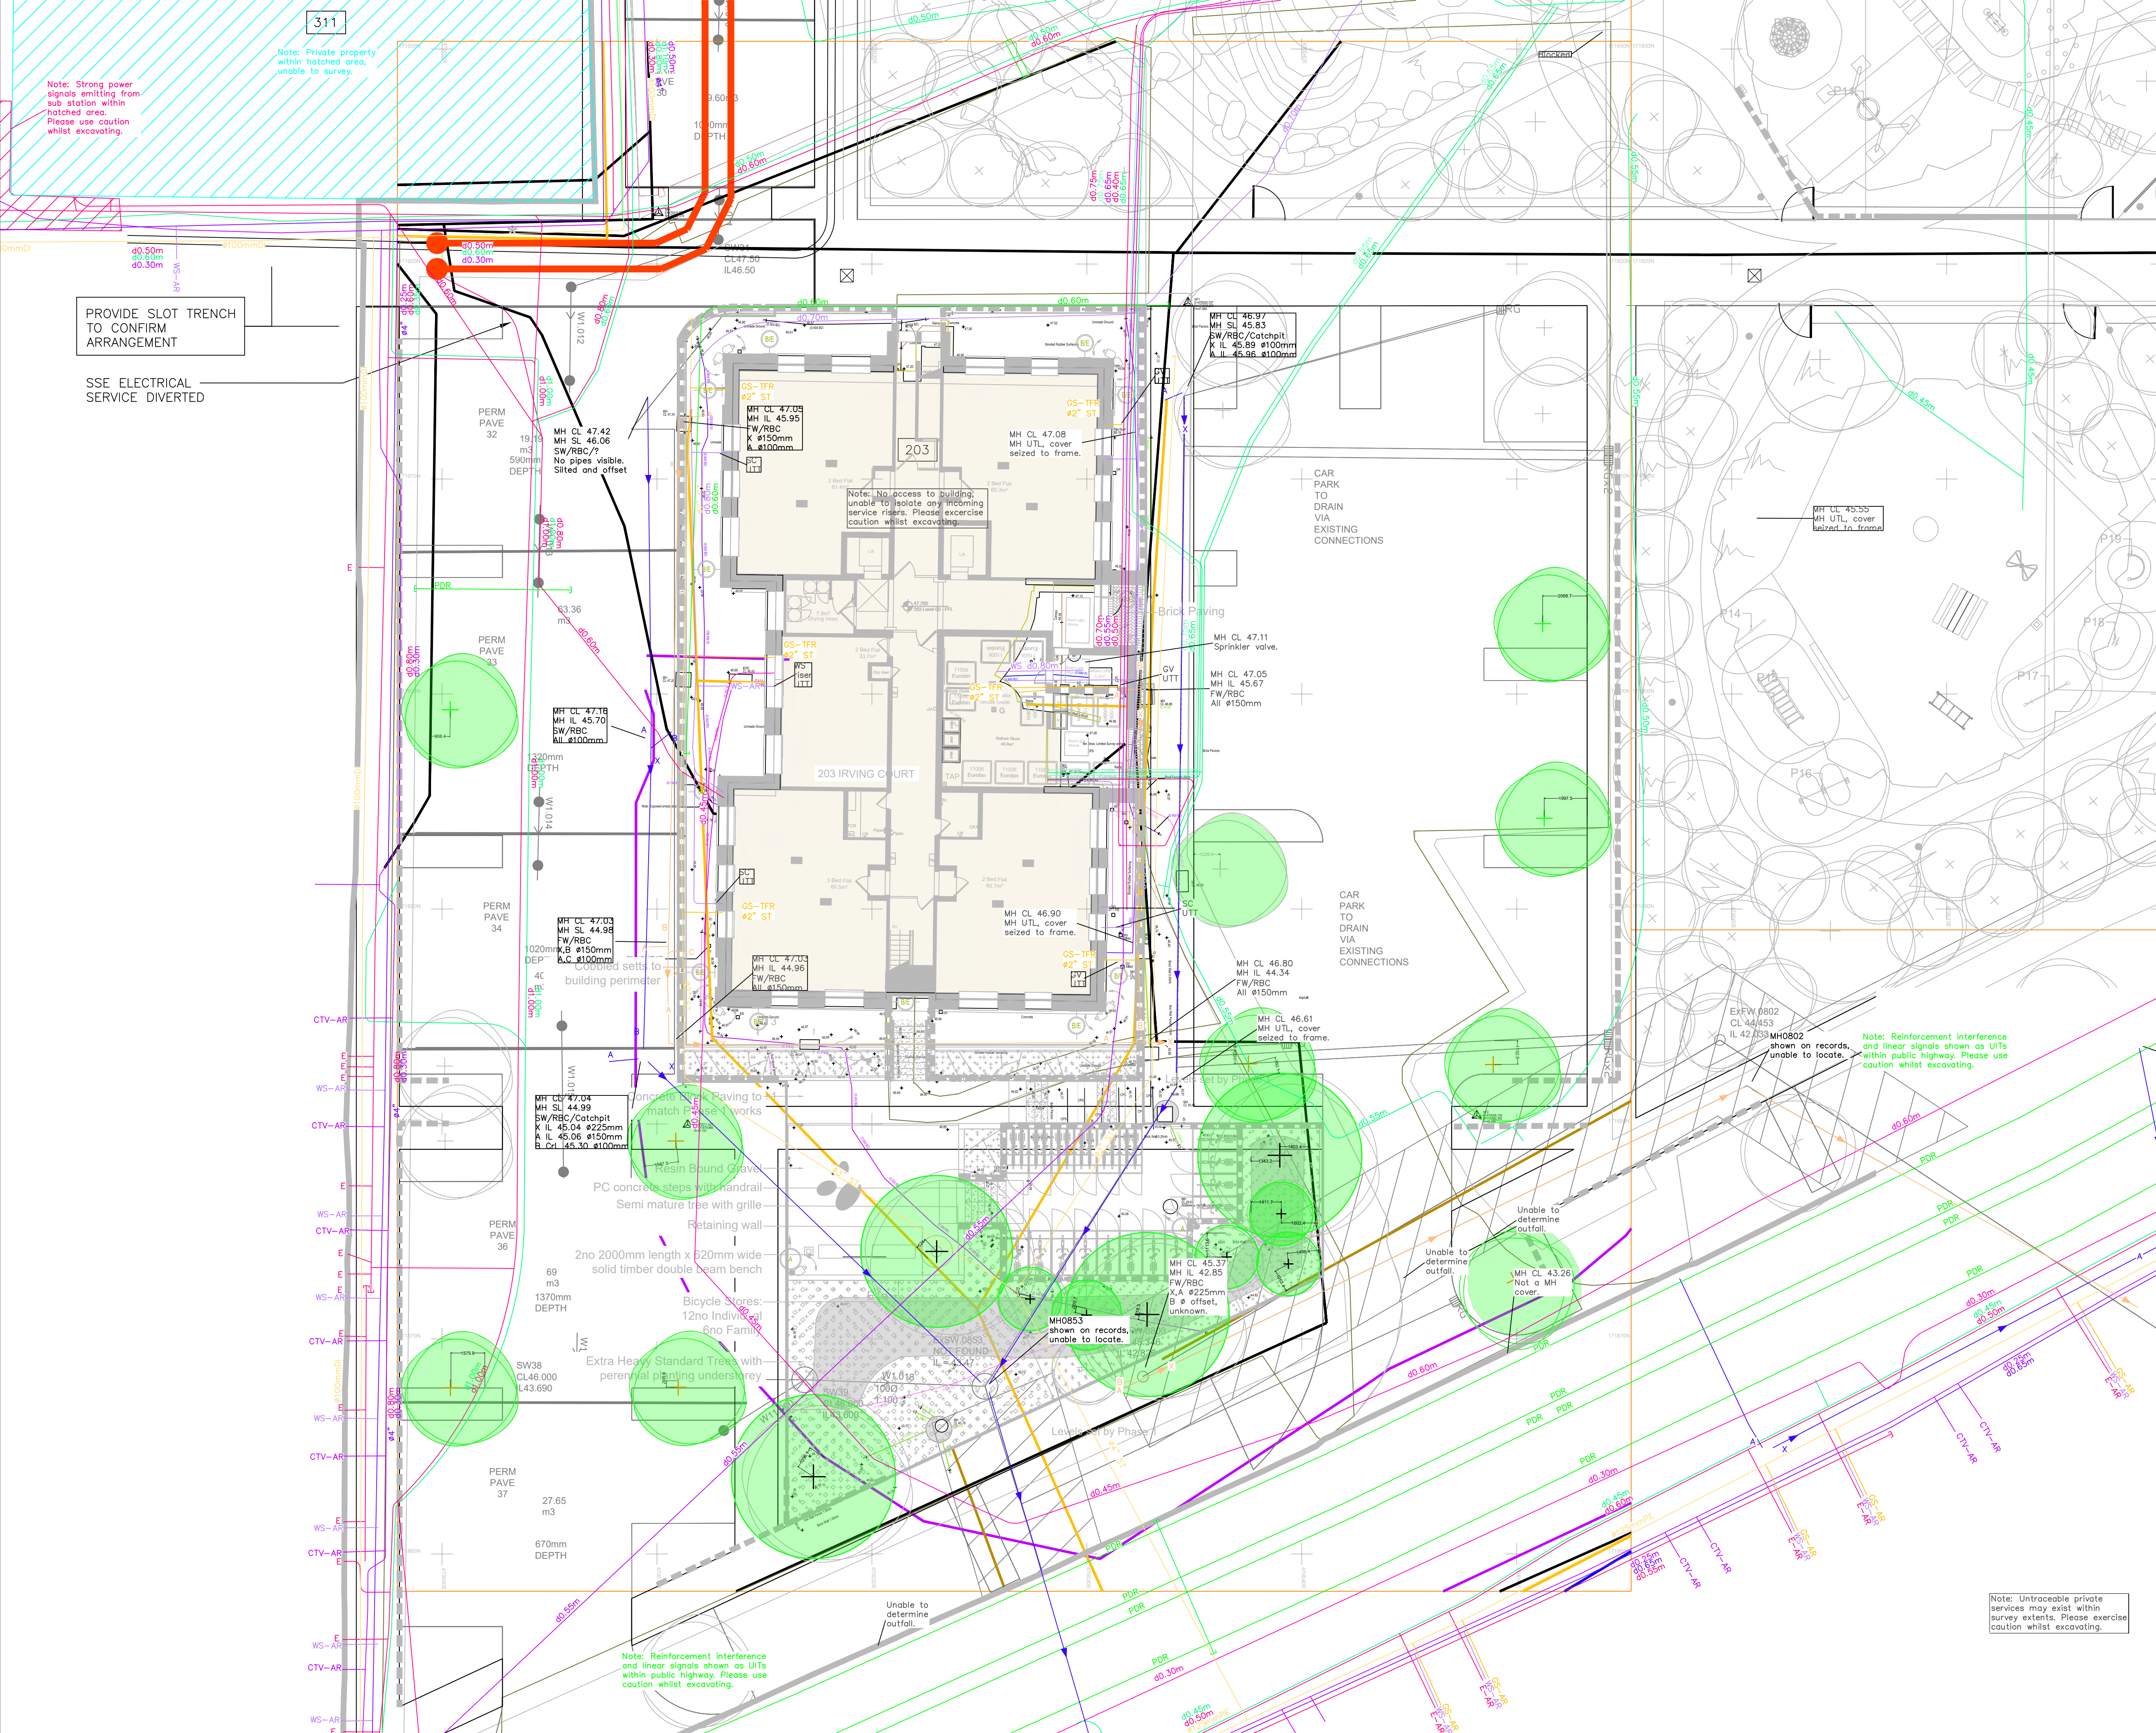

KEY




PROPOSED PLANTING WITHIN
2 METERS OF SERVICE ROUTE

Refer to previous
mark-ups on Irving
Court


HTA Comments

JRW NTS

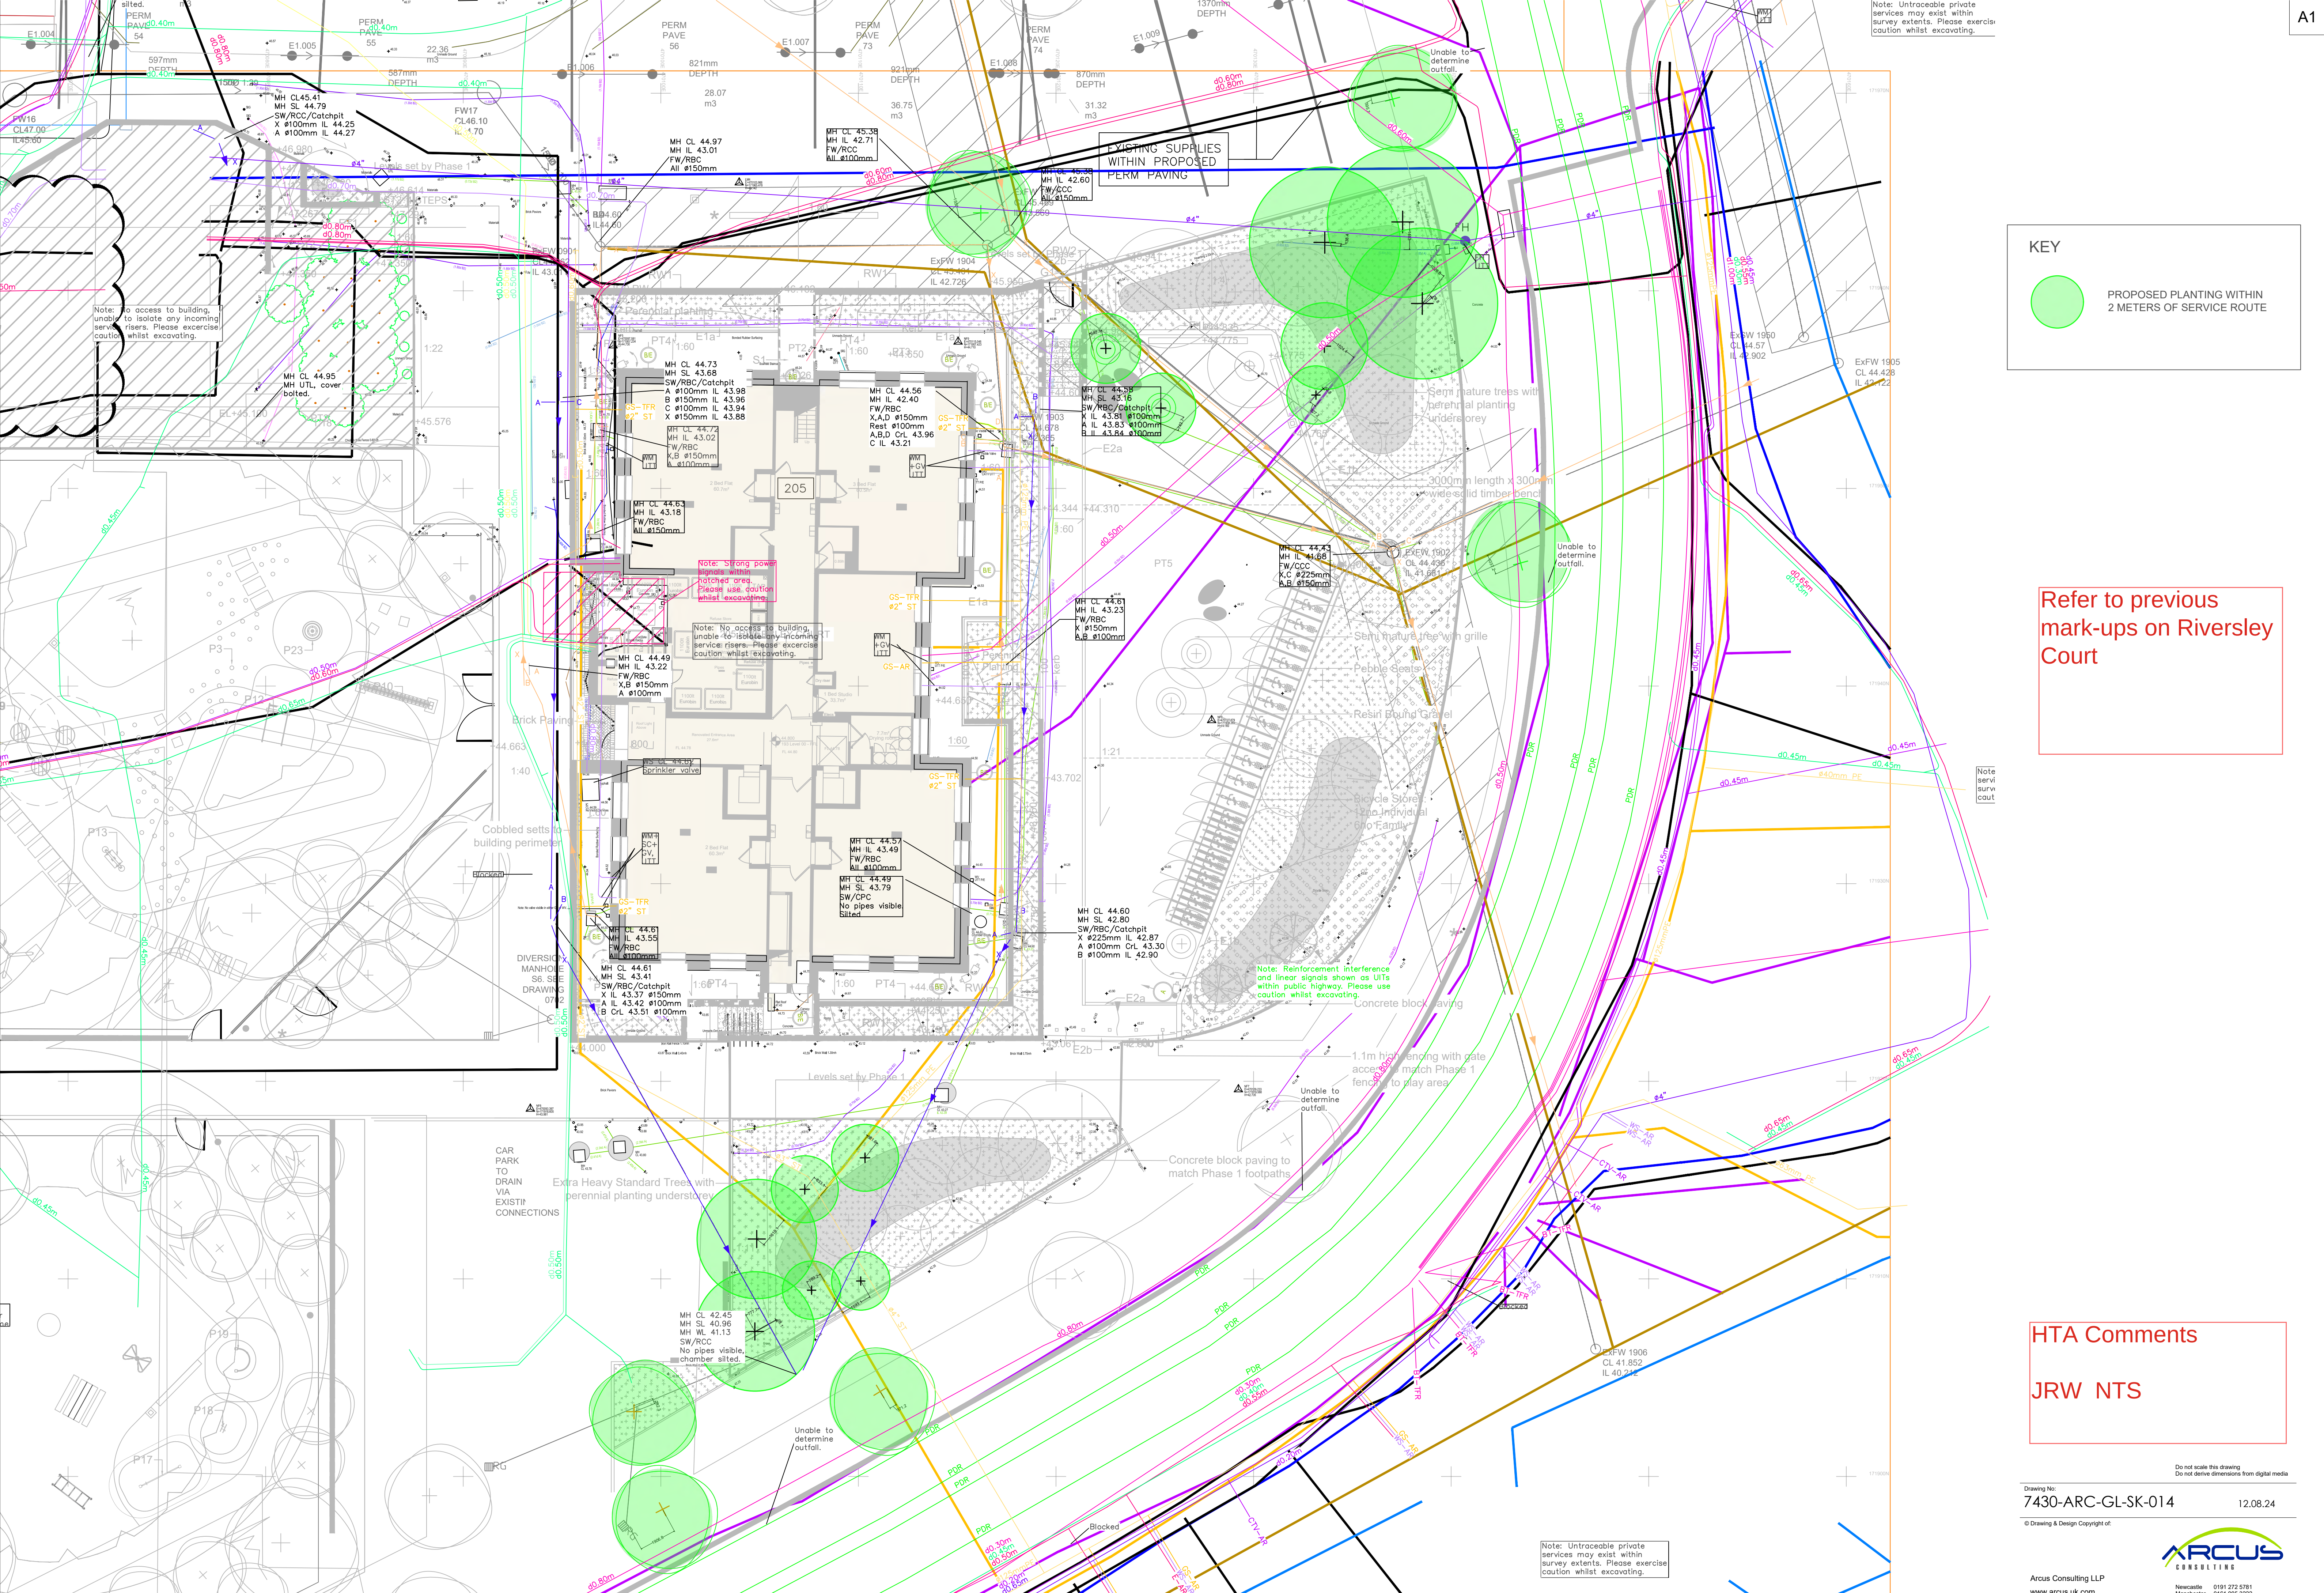

Note: Untraceable private services may exist within survey extents. Please exercise caution whilst excavating.

KEY

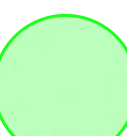 PROPOSED PLANTING WITHIN 2 METERS OF SERVICE ROUTE

Refer to previous mark-ups on Riversley Court

HTA Comments

JRW NTS

PLANTING / SERVICES CLASH DETECTION - 205 RIVERSLEY COURT