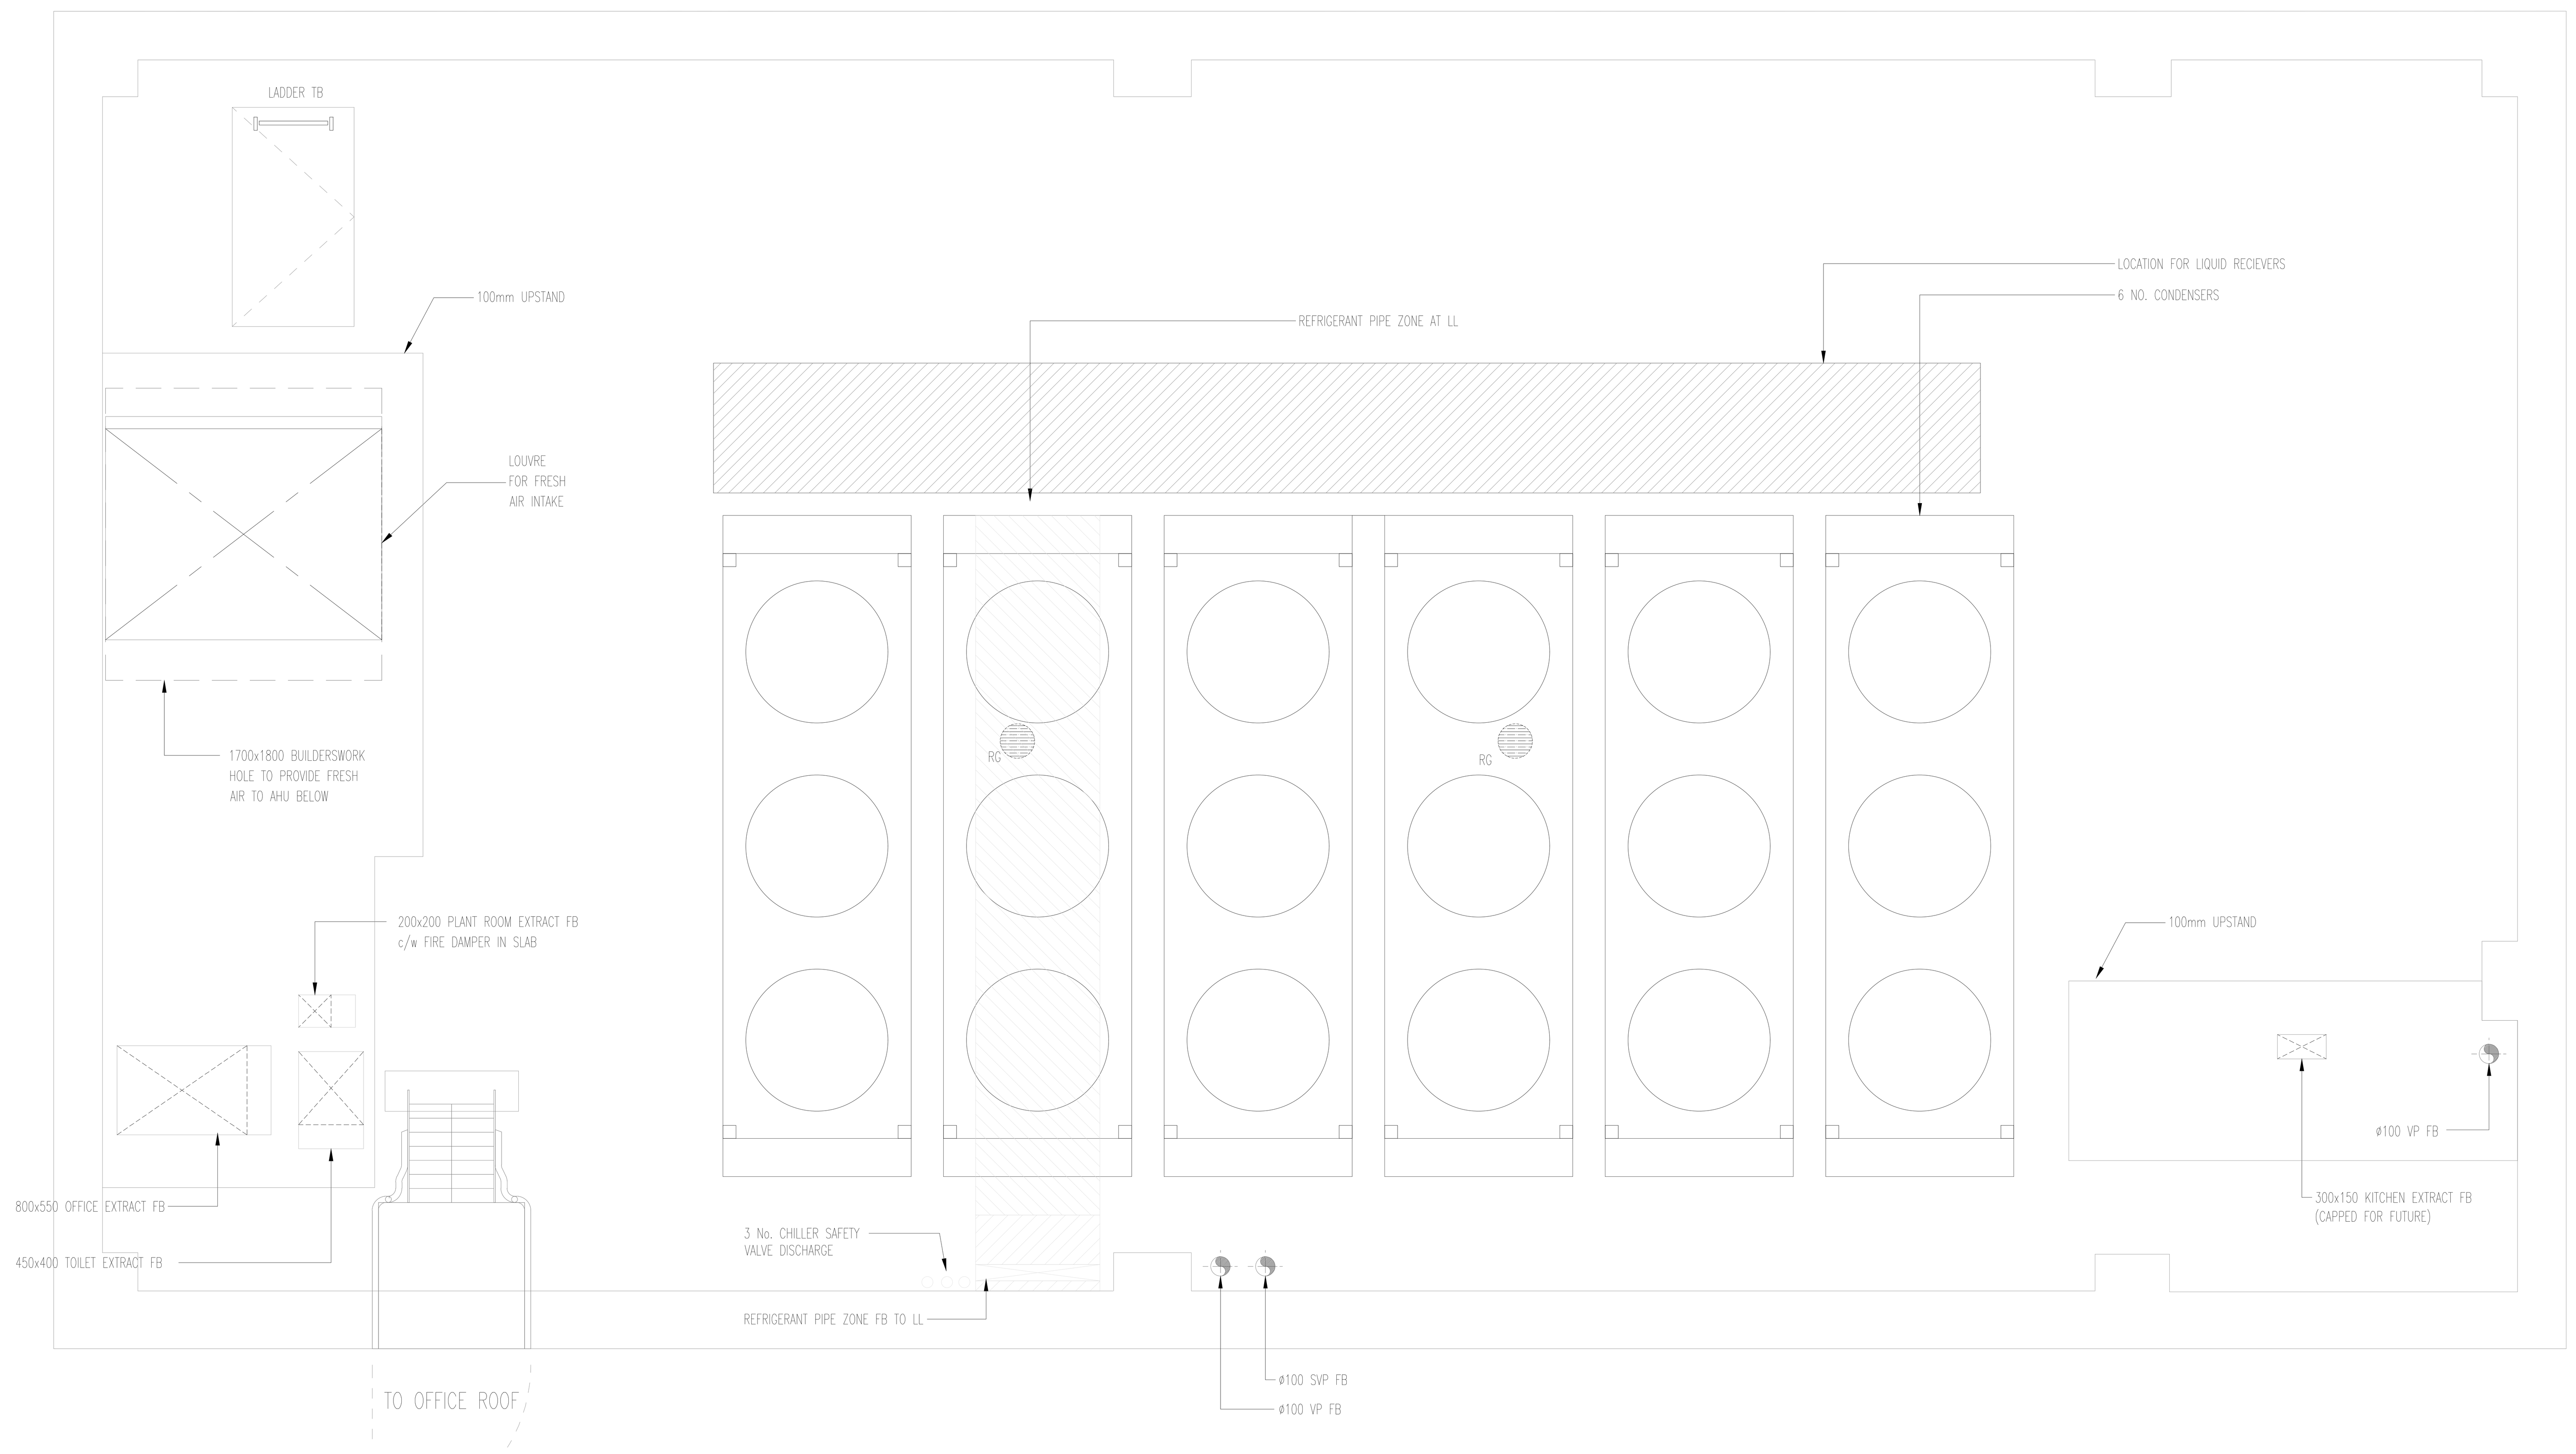

PLAN CORE 1

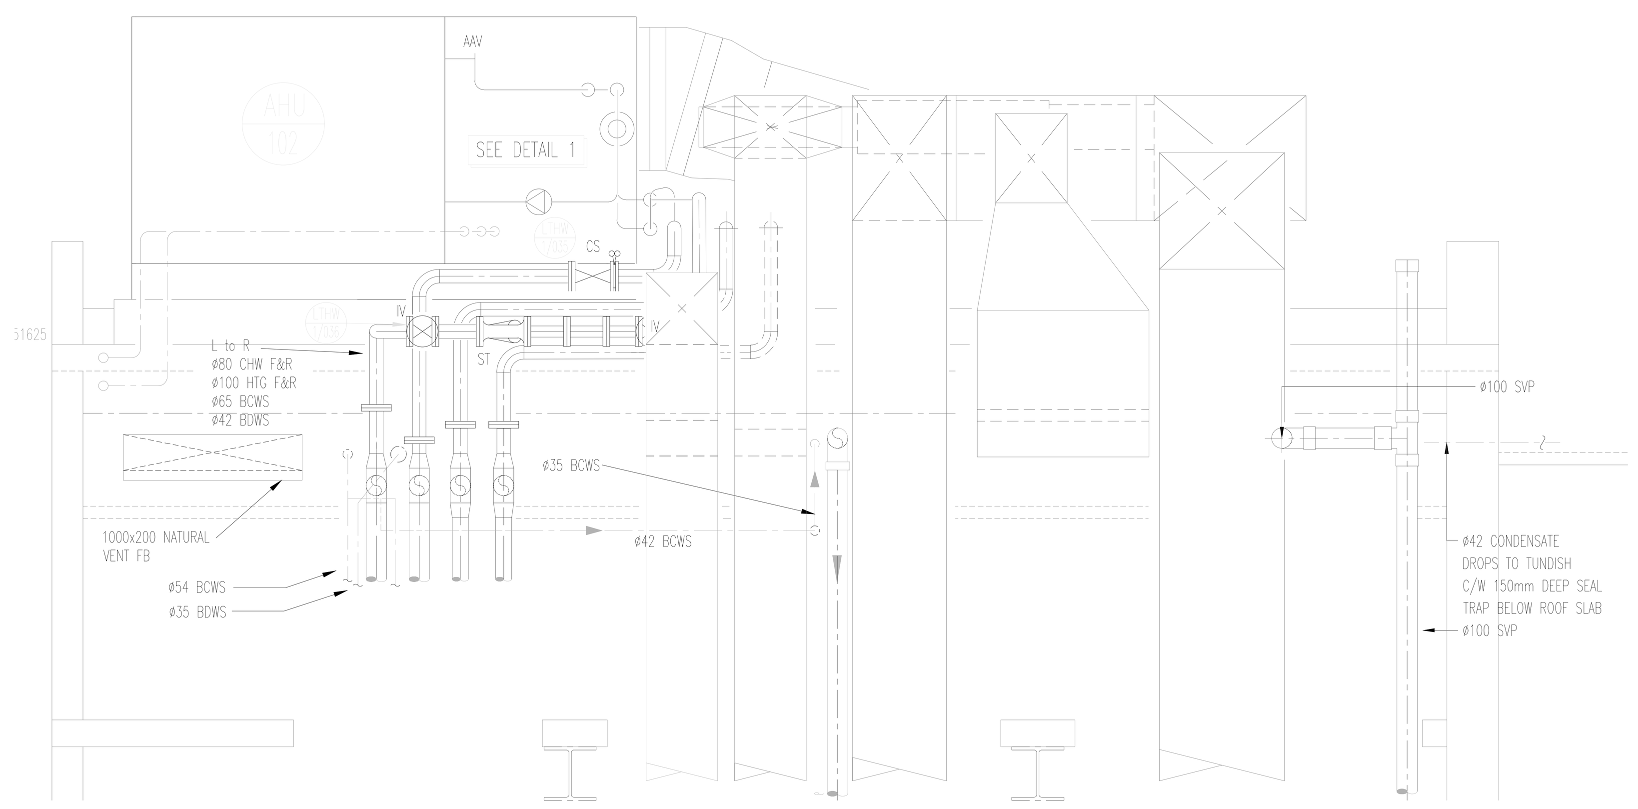

SECTION B–B

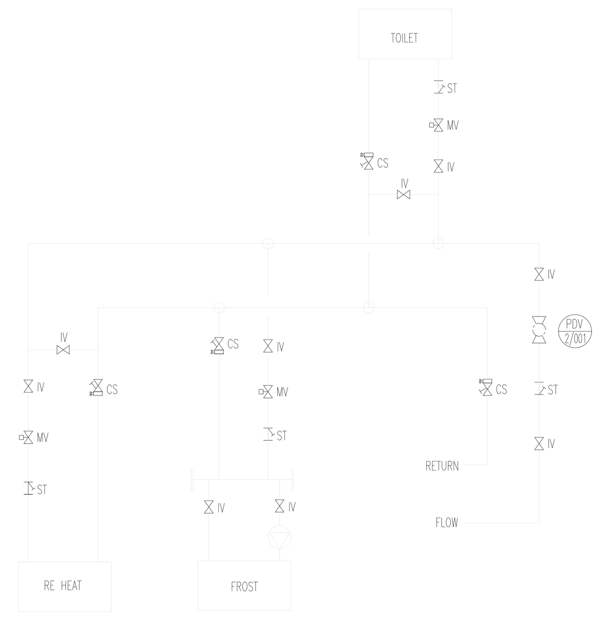

DETAIL 1

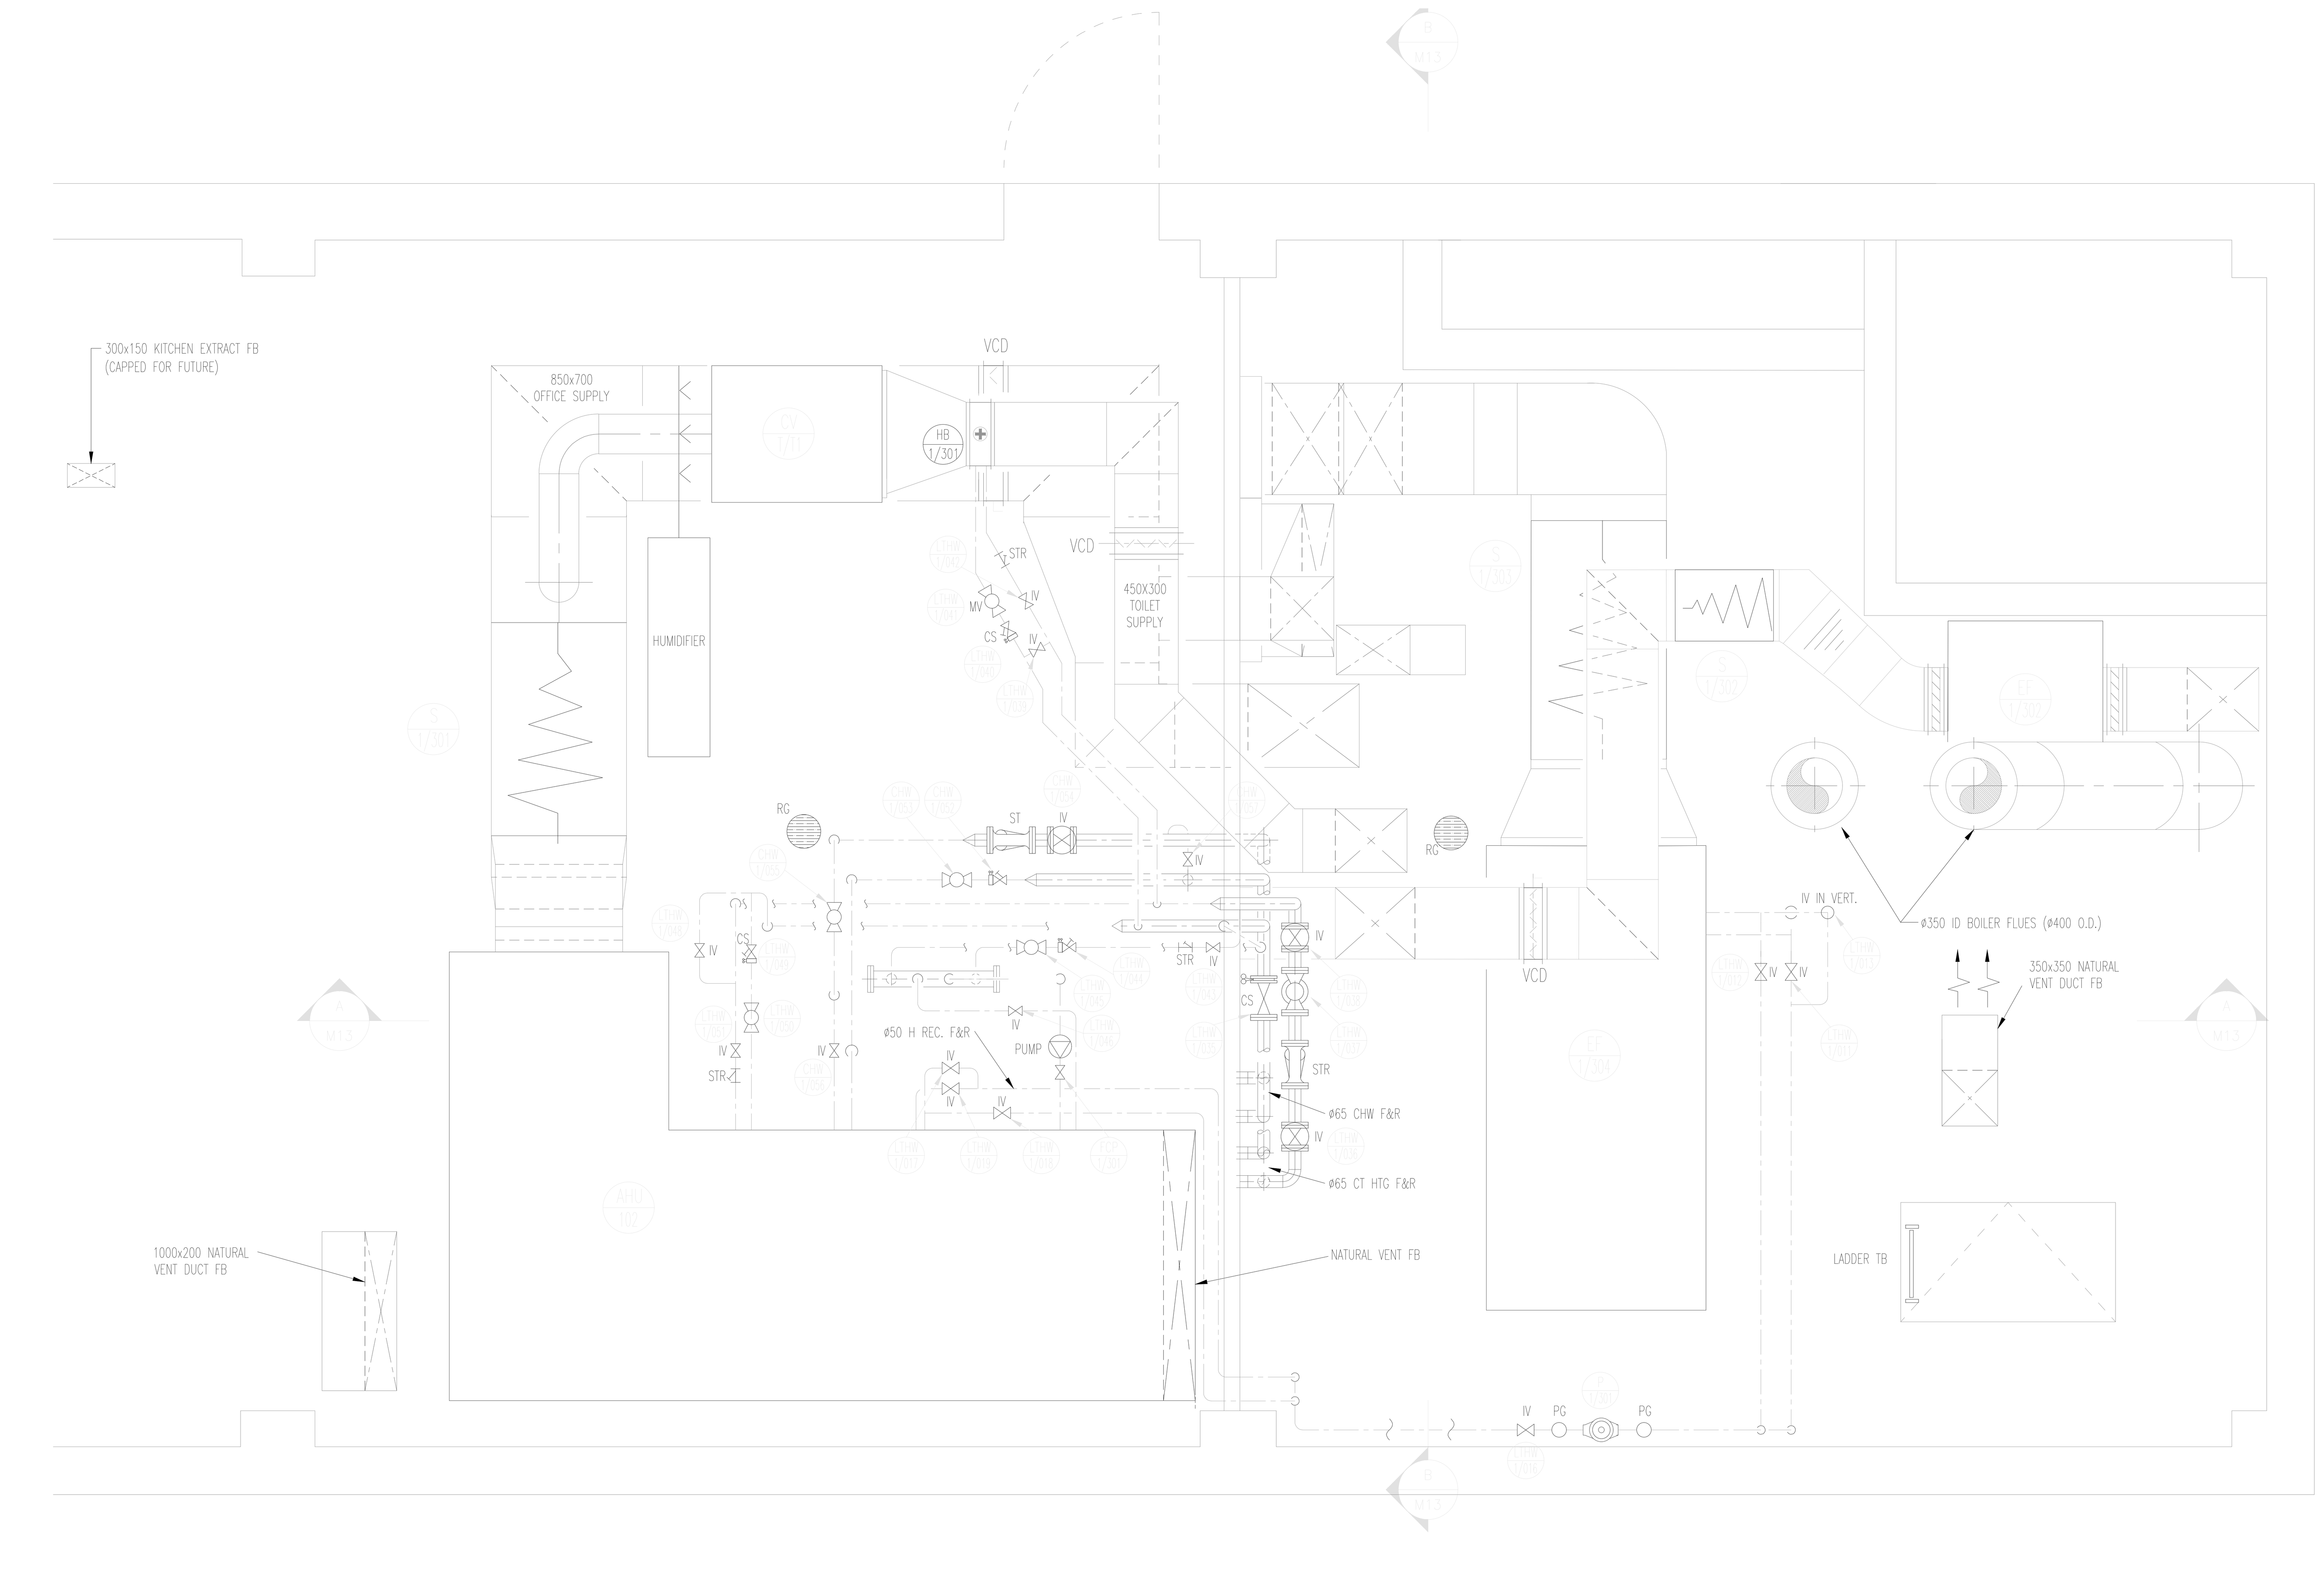

PLAN CORE 2

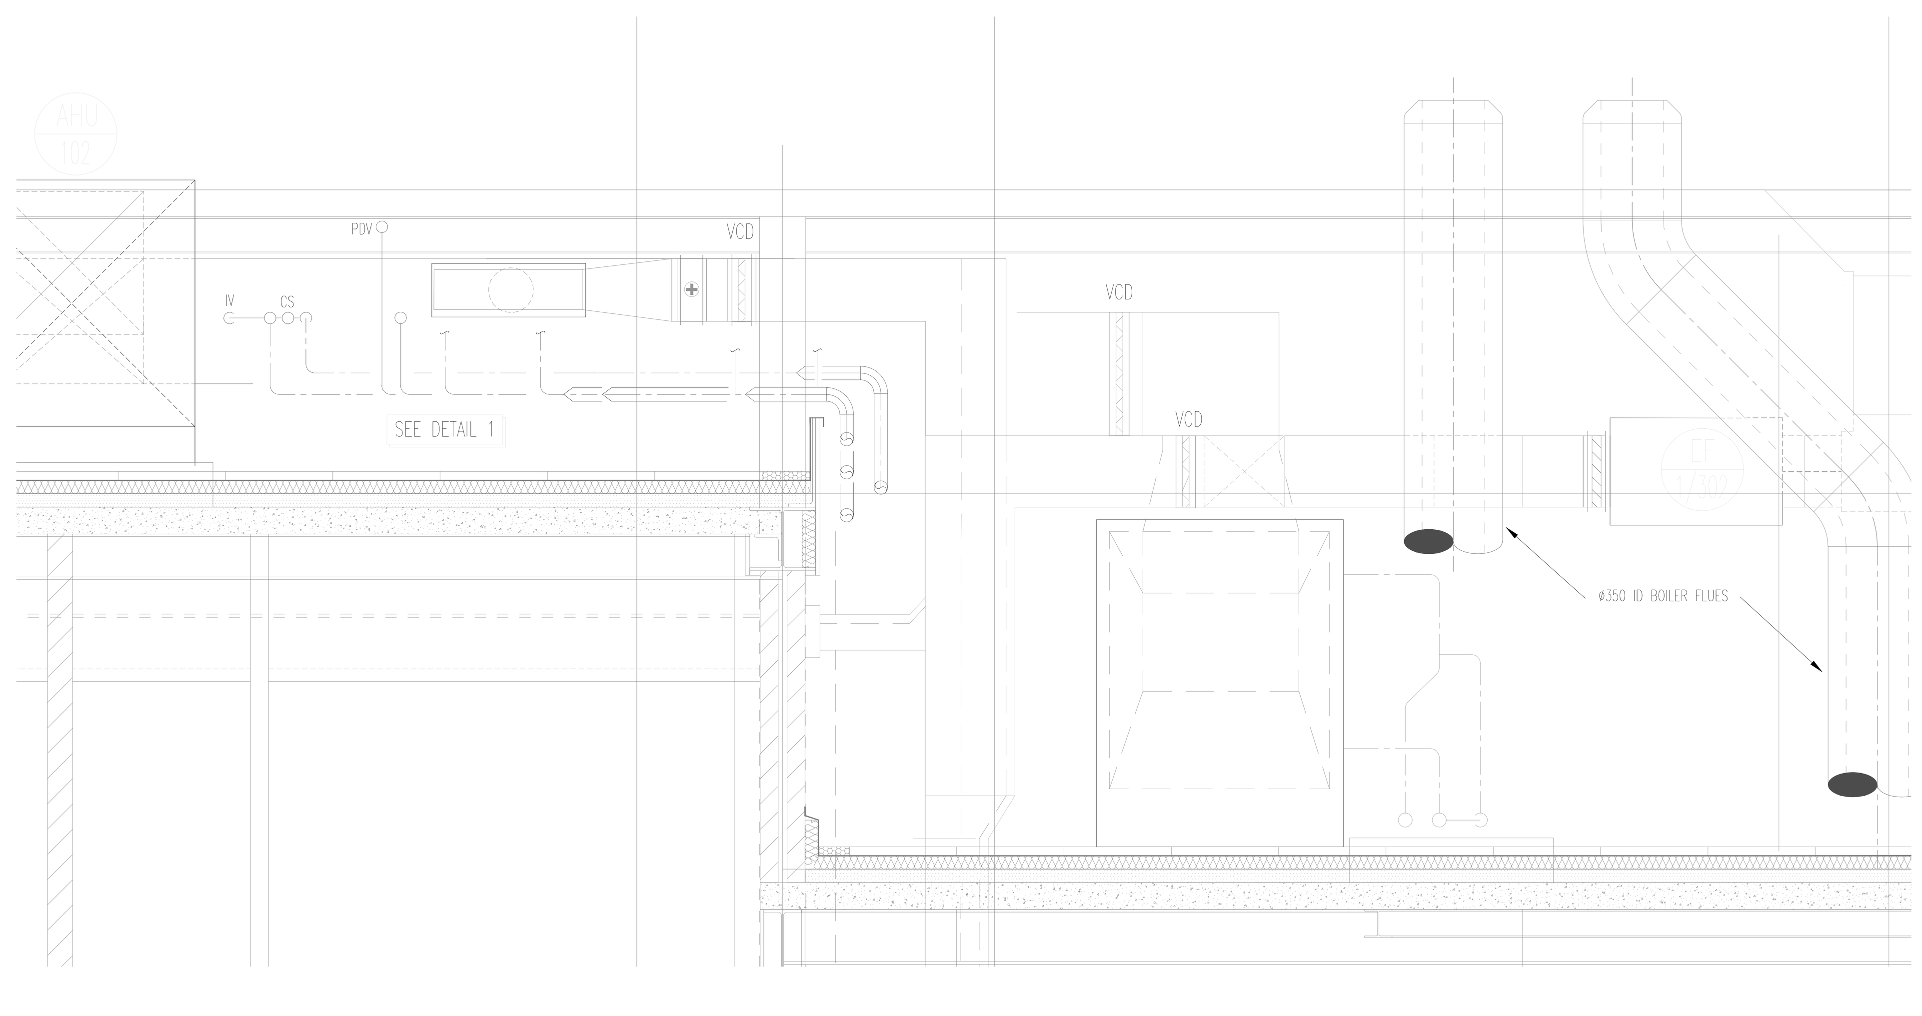

SECTION A–A

RECORD DRAWING

Copyright © Sulzer Infra (UK) Ltd
This drawing which is the property of Sulzer Infra (UK) Ltd
is the subject of Intellectual Property Rights including
copyright and design right and shall not be reproduced,
copied, loaned or submitted to any other party without the
written consent of Sulzer Infra (UK) Ltd.

NOTE
THIS DRG. IS TO BE READ IN CONJUNCTION WITH SCHEMATIC DRG.S M17–M20

Key Plan

REV	DESCRIPTION	DATE	DRN	CHKD
–	RECORD DRAWING	17/04/02	SB	LE

SULZER INFRA
Building Services

Sulzer Infra (UK) Ltd
FARNBOROUGH , MANCHESTER

ISSUING OFFICE
SOUTHERN REGION

PROJECT
Green Park Plot 6

NATIONAL ACCREDITATION OF CERTIFICATION BODIES

DRAWING TITLE
BUILDING 1
ROOF LEVEL CORES 1&2
MECHANICAL SERVICES PLANT AREAS

ARCHITECT / CLIENT / MANAGEMENT TEAM / CONSULTANT
Scott Brownrigg & Turner
Prudential Portfolio Managers Ltd
Heery
Rybka Battle

DRAWN	DATE	CHECKED	DATE
SL	17/04/02	LE	17/04/02

SCALE	DRAWING No	ISSUE
1:25	WP500/B1/R/C1&2/RD/M13	–