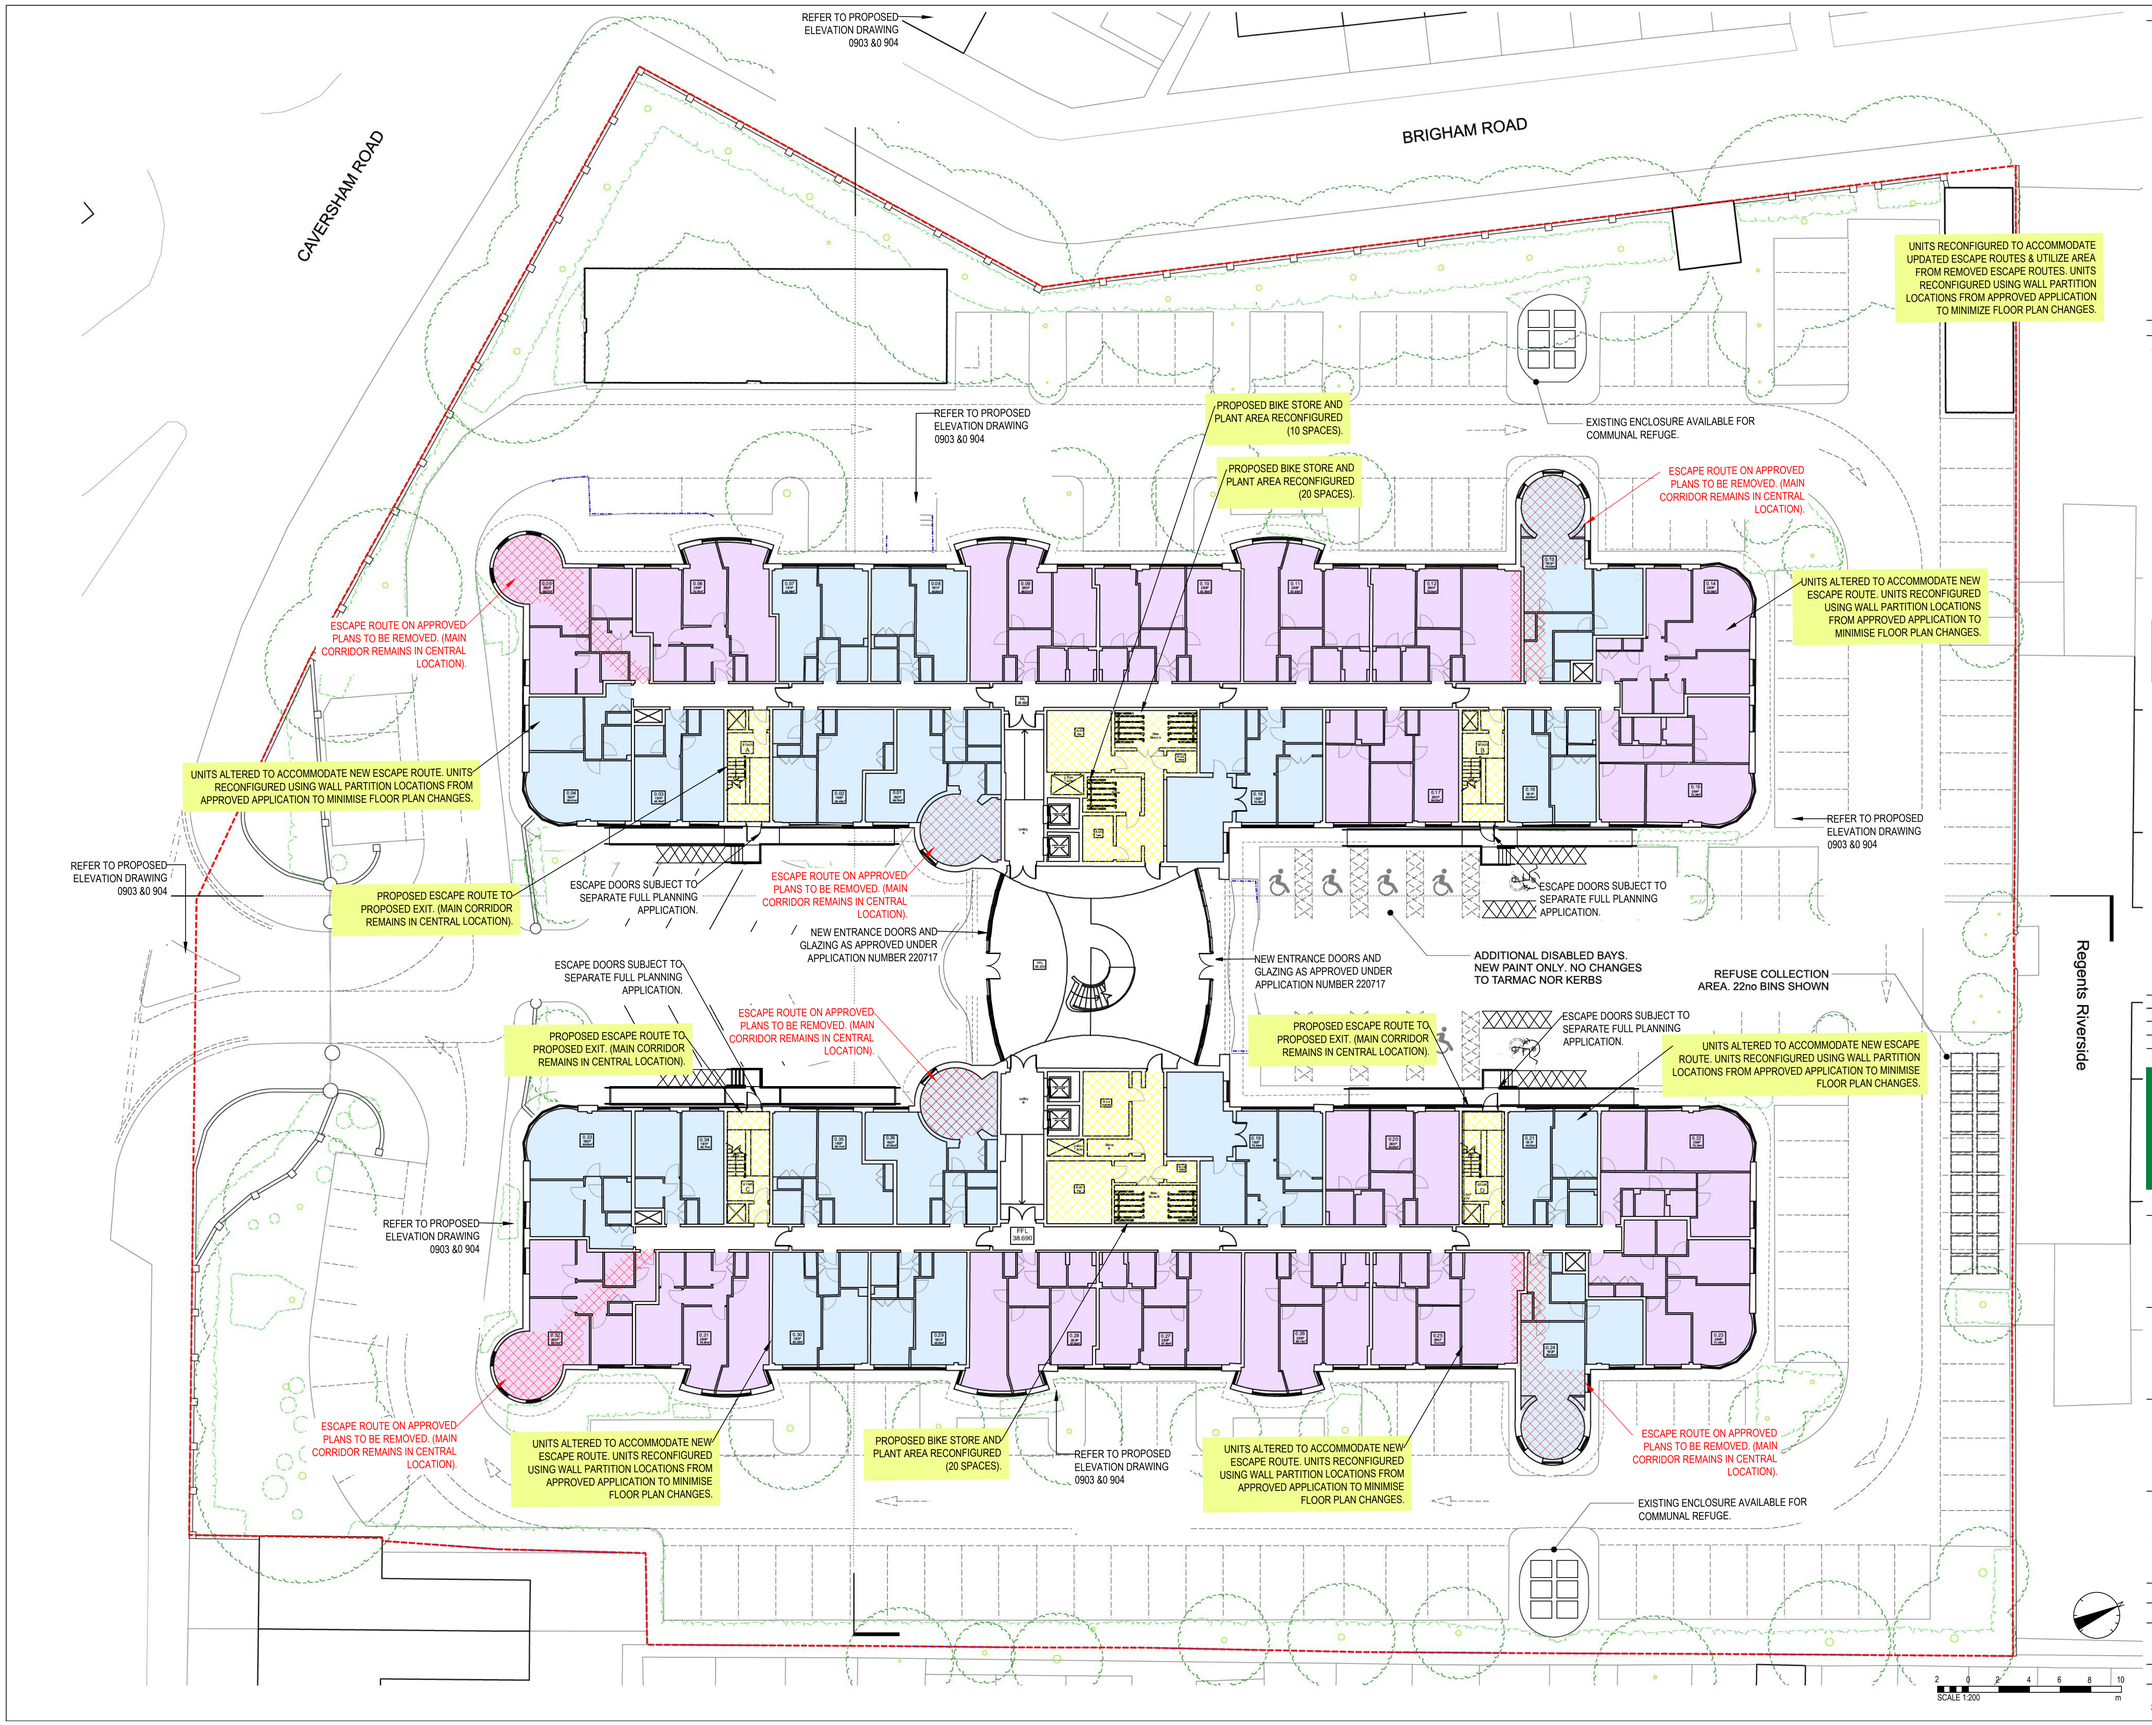

DISCLAIMER NOTES:

- THIS DOCUMENT IS COPYRIGHT OF THE ORIGINATOR AND MUST BE TREATED AS CONFIDENTIAL
- THIS DOCUMENT MUST NOT BE ALTERED, REPRODUCED OR DISTRIBUTED WITHOUT PRIOR WRITTEN CONSENT OF THE ORIGINATOR
- THIS DOCUMENT MUST NOT BE ALTERED - THE ORIGINATOR ACCEPTS NO RESPONSIBILITY FOR ANY DISCREPANCIES ARISING AS A RESULT OF THE ORIGINATORS INFORMATION BEING ALTERED BY OTHERS
- ANY DISCREPANCY MUST BE REPORTED TO THE ORIGINATOR
- DO NOT SCALE THIS DOCUMENT - USE FIGURED DIMENSIONS ONLY
- ALL DIMENSIONS MUST BE CHECKED ON SITE PRIOR TO COMMENCEMENT OF ANY RELATED WORKS
- THIS DOCUMENT MUST BE READ IN CONJUNCTION WITH ALL SUPPORTING DOCUMENTS PRODUCED BY THE ORIGINATOR AND OTHER PROJECT DISCIPLINES
- THE ORIGINATOR ACCEPTS NO RESPONSIBILITY FOR THE ACCURACY OF BACKGROUND INFORMATION PRODUCED BY THIRD PARTIES - THIS MUST BE TREATED AS INDICATIVE ONLY
- USERS OF THIS DOCUMENT ARE RESPONSIBLE FOR CHECKING WHICH REVISION IS CURRENT
- THE DOCUMENT STATUS "INFORMATION" OR "PRELIMINARY", INDICATES THAT THIS DRAWING IS FOR REFERENCE PURPOSES ONLY - THE ORIGINATOR WILL ACCEPT NO RESPONSIBILITY FOR THE COMPLETENESS OF INFORMATION UNDER THIS STATUS
- THE DOCUMENT STATUS "RECORD" OR "AS BUILT" HAS BEEN PREPARED, IN PART, BASED UPON INFORMATION FURNISHED BY OTHERS. WHILE THIS INFORMATION IS BELIEVED TO BE RELIABLE, THE ORIGINATOR ASSUMES NO RESPONSIBILITY FOR THE ACCURACY OF THIS "RECORD" OR "AS BUILT" DOCUMENT OR FOR ANY ERRORS OR OMISSIONS THAT MAY HAVE BEEN INCORPORATED INTO IT AS A RESULT OF INCORRECT INFORMATION PROVIDED TO THE ORIGINATOR. THOSE RELYING ON THE "RECORD" OR "AS BUILT" DOCUMENT ARE ADVISED TO OBTAIN INDEPENDENT VERIFICATION OF ITS ACCURACY

DRAWING NOTES:

CDM REGULATIONS 2015
SIGNIFICANT OR NON-OBVIOUS RISKS AND RISKS WHICH ARE DIFFICULT TO MANAGE ARE IDENTIFIED ON THIS DRAWING USING THE FOLLOWING SYMBOL IDENTIFIED TO THE RIGHT WITH BRIEF ACCOMPANYING TEXT. FOR FURTHER DETAILS OF THE RISKS IDENTIFIED BY DESIGNERS, REFERENCE SHOULD BE MADE TO CDM HAZARD REGISTER.

PROPOSED SPATIAL CONFIGURATION OVERLAID AGAINST ORIGINAL APPROVED PLANNING APPLICATION.

QUANTITY OF CYCLE AND BIN PROVISION AS PER ORIGINAL CONSENT.

AMENDMENTS TO EXTERNAL WINDOWS SUBJECT TO SEPARATE PLANNING APPLICATION.

DRAWING TO APPENDIX PLANNING APPLICATION TO ILLUSTRATE UPDATES.

UNIT KEY

- 1 Bedroom flat
- 2 Bedroom flat

HIGHLIGHTED CHANGES TO APPROVED PLANNING APPLICATION:
- ESCAPE ROUTES ON APPROVED APPLICATION REMOVED
- PROPOSED CHANGES TO APPROVED APPLICATION

REV	DESCRIPTION	DATE	BY	CHKD
C	CYCLE STORE UPDATE	13.02.2025	NG	MS
B	CYCLE STORE UPDATE	10.02.2025	NG	MS
A	HIGHLIGHTED CHANGES TO APPROVED PLANNING APP	24.01.2025	NG	MS

ORIGINATOR: www.ridge.co.uk

RIDGE

PROJECT NUMBER: 5025893

CLIENT:
KINGS OAK MIAMI LLP

IN ASSOCIATION WITH:

PROJECT:
GREAT BRIGHAMS MEAD
READING

TITLE:
PROPOSED GROUND FLOOR PLAN
HIGHLIGHTED CHANGES
SUITABLE FOR PLANNING

DRAWN BY: NG CHECKED BY: MS APPROVED BY: MS

SCALE: 1:200 @ A1 DATE: 24/01/2024

STATUS: S4 DESCRIPTION: SUITABLE FOR STAGE APPROVAL

DRAWING No:

PROJECT:	ORG:	FUNCTION:	SPATIAL:	FORM:	DISCIPLINE:	NUMBER:	REV:
5025893	RDG	00	PL	D	B	0309	C