


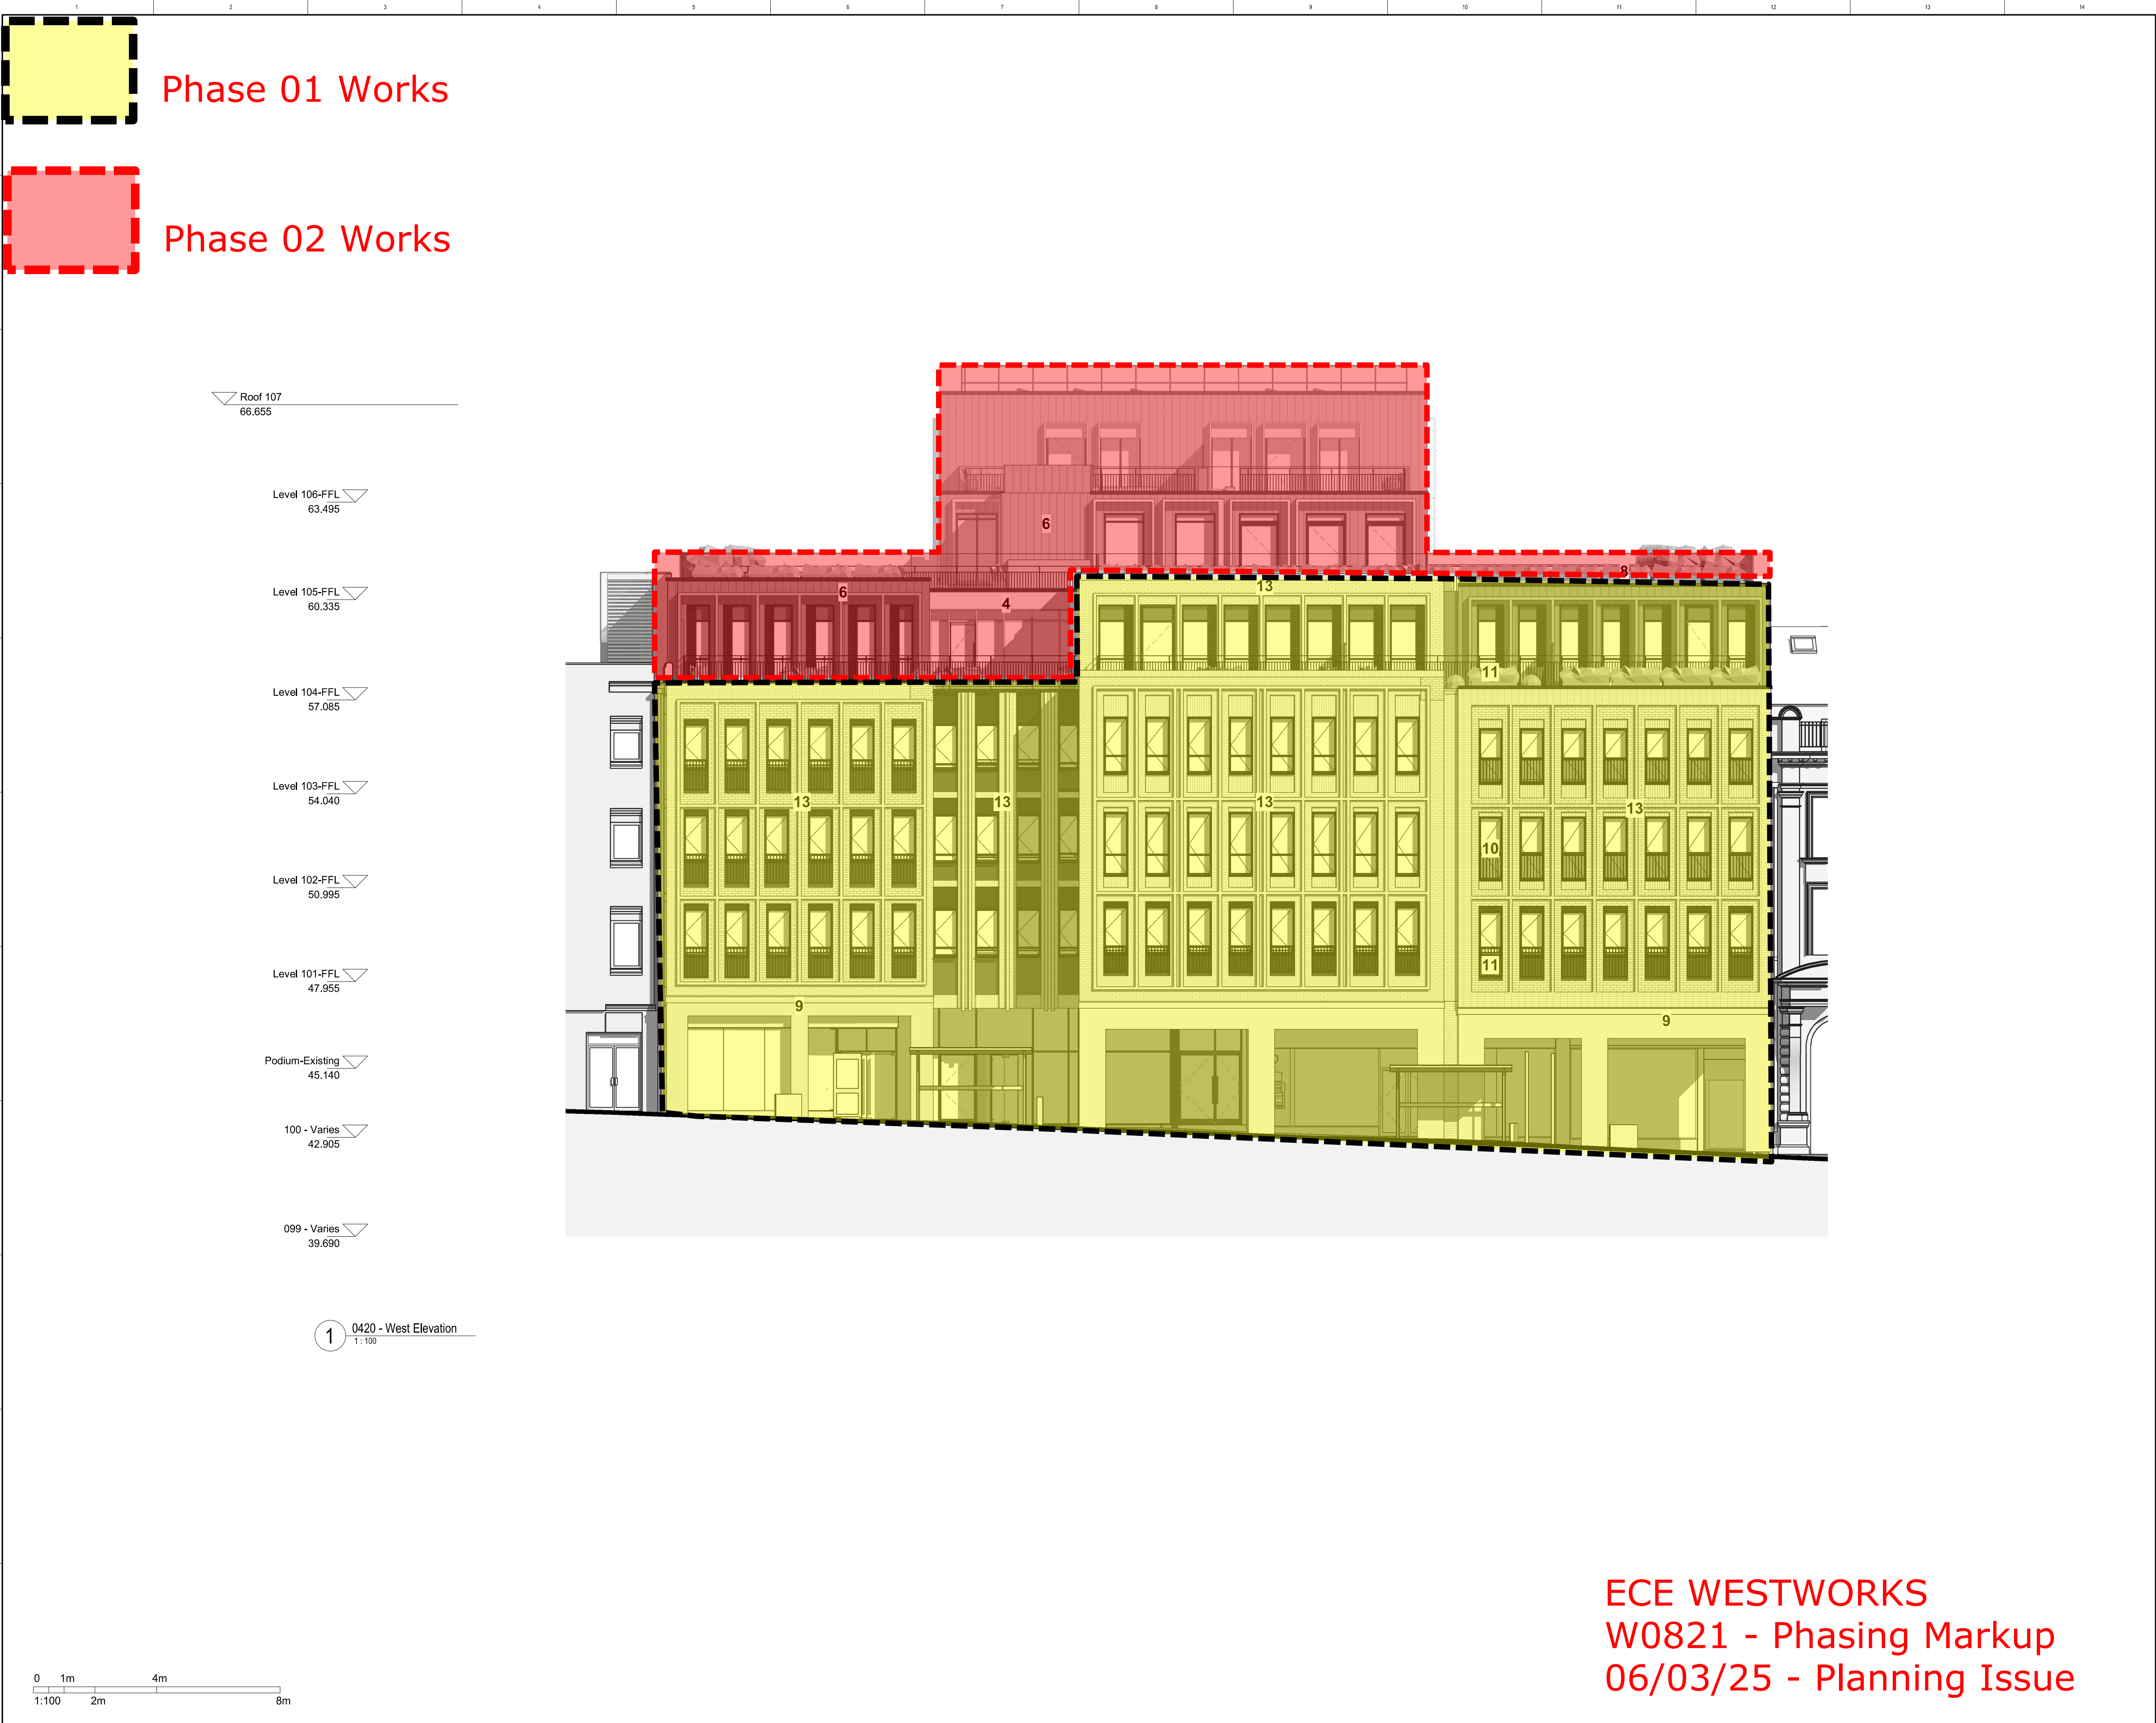

ECE WESTWORKS
W0821 - Phasing Markup
06/03/25 - Planning Issue

CLIENT


Tene Living

STRUCTURAL ENGINEER

SERVICES ENGINEER

CONSULTANT

KEY PLAN

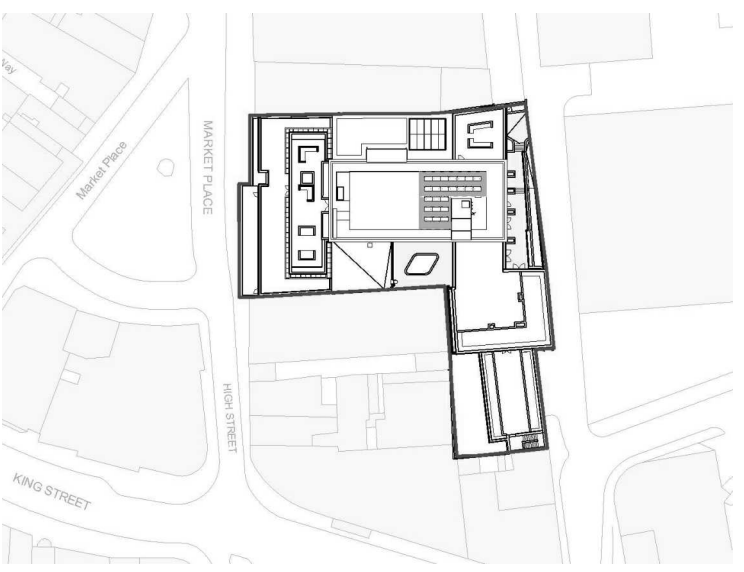

NOTES:

THIS DRAWING IS PROTECTED BY COPYRIGHT.

ALL AREAS HAVE BEEN MEASURED FROM CURRENT DRAWINGS. THEY MAY VARY BECAUSE OF (EG) SURVEY, DESIGN DEVELOPMENT, CONSTRUCTION TOLERANCES, STATUTORY REQUIREMENTS OR RE-DEFINITION OF THE AREAS TO BE MEASURED.

MATERIAL PALETTE

1. Georgian Red Brick

2. Grey Field Brick

3. Buff Brick

3a Buff brick Half tone darker

4. Green Bronze Metal cladding

5. Dark Grey Brick

6. Metal Standing Seam (Dark grey)

7. Black Frosted Glass

8. Glass Balustrade

9. Reconstituted Stone Wall / Plinth

10. Black window frames

11. Black Metal Balustrade

12. Aluminium Louvres

13. Brickwork - colours to be agreed

P7

23-01-2023

Amendments to feedback

RP

AC

P6

23-01-2023

Material Key Updated

RP

AC

P5

23-01-2023

Material selection updated

RP

AC

P4

22-11-2022

Type 3a brick added and Standing seam noted as dark grey

ZC

AC

P3

23-09-2022

Title Block Formatting

RP

AC

P2

21-08-2022

Design Update

RP

AC

P1

20-08-2022

First Issue

AK

AC

No.

Date

Comments

Drawn

Checked

Revisions

Issue Status

Preliminary

tp bennett

architecture
interiors
planning

One America Street | London SE1 0NE UK +44 (0) 20 7208 2000 www.tpbenett.com

Project

Market Place Residential
6-9 Sloane Point
Reading

Drawing Title

Proposed Elevations
PLANNING
Sheet 1 of 6

Drawn

Date

Scale @ A1

Alt. Ref.

AK

02/08/2022

As indicated

Project

Originator

Volume

Level

Type

Role Number

Suitability

Revision

A12113

TPB

ZZ

ZZ

DR A

0420

S1

P7

23/01/2023 17:00:41

8846 Model Ref: A12113-TPB-ZZ-ZZ-DR A-0420-S1-P7



CLIENT

Tene Living

STRUCTURAL ENGINEER

SERVICES ENGINEER

CONSULTANT

KEY PLAN

NOTES:

THIS DRAWING IS PROTECTED BY COPYRIGHT.

ALL AREAS HAVE BEEN MEASURED FROM CURRENT DRAWINGS. THEY MAY VARY BECAUSE OF (EG) SURVEY, DESIGN DEVELOPMENT, CONSTRUCTION TOLERANCES, STATUTORY REQUIREMENTS OR RE-DEFINITION OF THE AREAS TO BE MEASURED.

MATERIAL PALETTE

1. Georgian Red Brick

2. Grey Field Brick

3. Buff Brick

4. Green Bronze Frame

5. Dark Grey Brick

6. Metal Standing Seam

7. Black Frosted Glass

8. Glass Balustrade

9. Reconstituted Stone Wall / Plinth

10. Black window frames

11. Black Metal Balustrade

12. Aluminium Louvers

13. Existing facade re-rendered

P3	23-09-2022	Title Block Formatting	RP	AC
P2	23-09-2022	DT Feedback Amendments	RP	AC
P1	20-09-2022	First Issue	AK	AC

No.	Date	Comments	Drawn	Checked
Revisions				

Issue Status

Preliminary

tp bennett

architecture
interiors
planning

One America Street | London SE1 0NE UK +44 (0) 20 7208 2000 www.tpbenett.com

Project

Market Place Residential
6-9 Sloane Point
Reading


Drawing Title

Proposed Elevations
PLANNING
Sheet 2 of 6

Drawn	Date	Scale @ A1	Alt Ref.
AK	02/08/2022	As indicated	

Project	Originator	Volume	Level	Type	Role Number	Suitability	Revision
A12113 TPB	ZZ	ZZ	ZZ	DR	A 0421	S1	P3

ECE WESTWORKS
W0821 - Phasing Markup
06/03/25 - Planning Issue

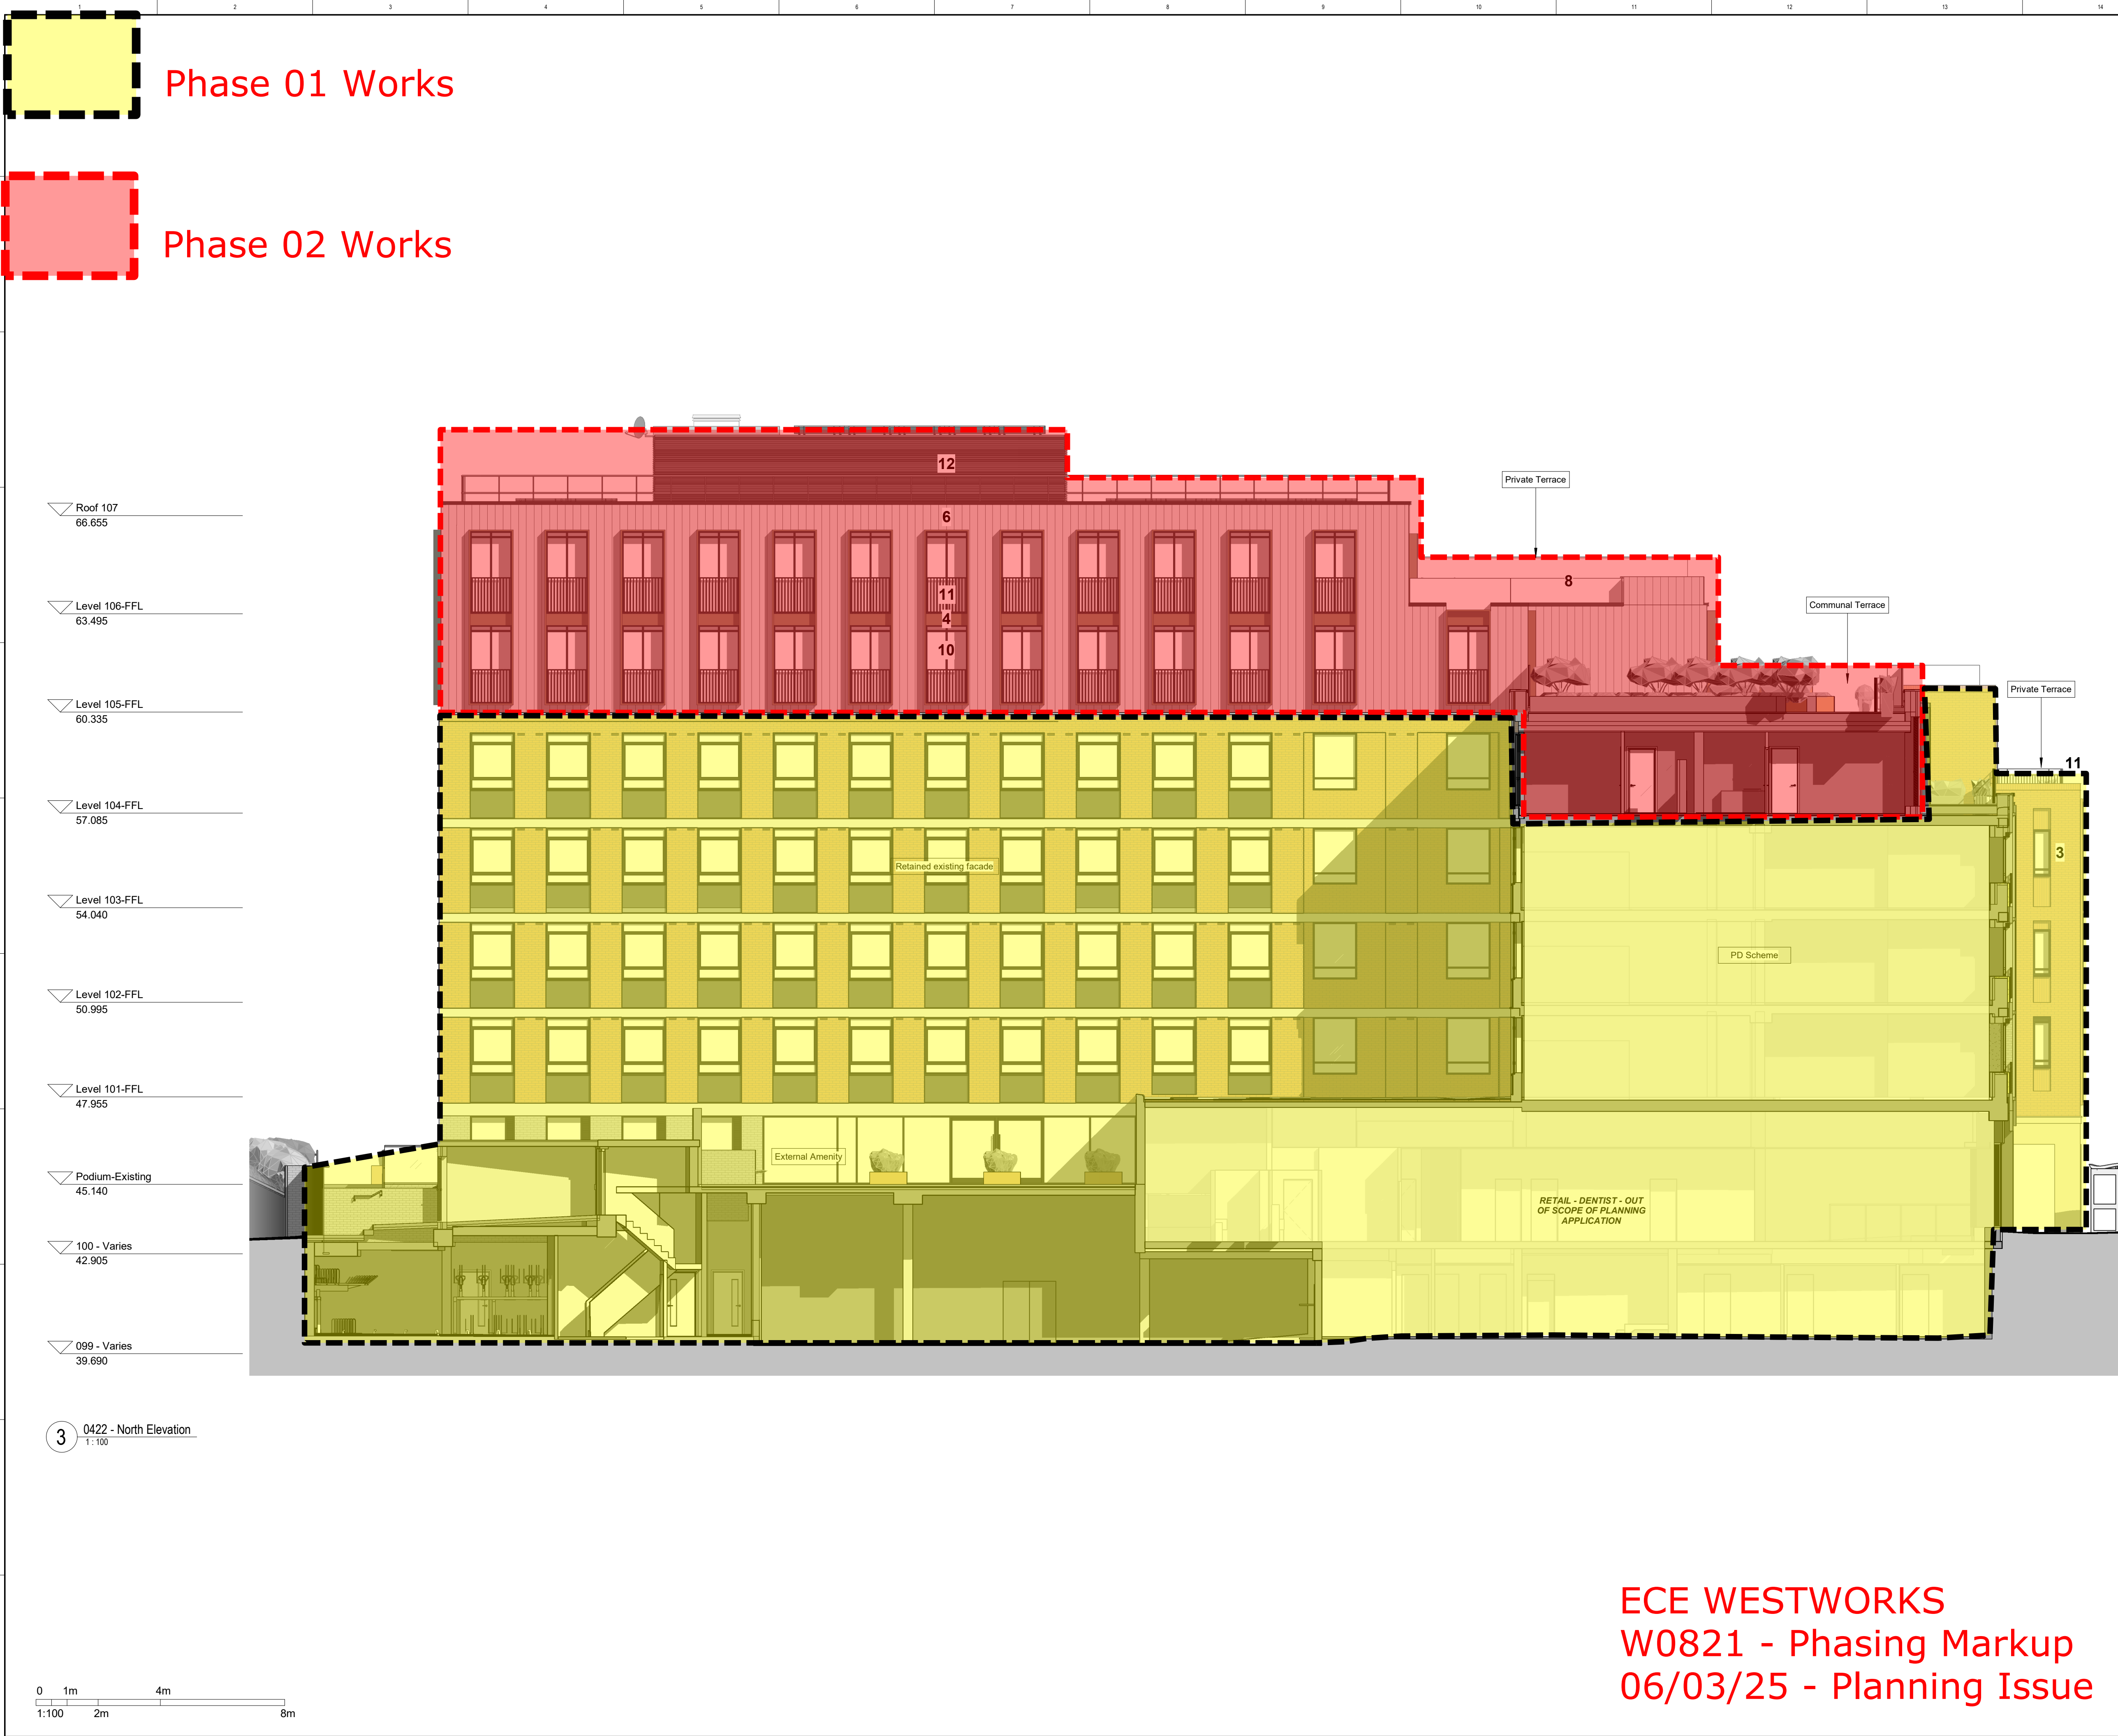

CLIENT
Tene Living

STRUCTURAL ENGINEER

SERVICES ENGINEER

CONSULTANT

KEY PLAN

NOTES:
THIS DRAWING IS PROTECTED BY COPYRIGHT.
ALL AREAS HAVE BEEN MEASURED FROM CURRENT DRAWINGS. THEY MAY VARY BECAUSE OF (EG) SURVEY, DESIGN DEVELOPMENT, CONSTRUCTION TOLERANCES, STATUTORY REQUIREMENTS OR RE-DEFINITION OF THE AREAS TO BE MEASURED.

MATERIAL PALETTE

1. Georgian Red Brick	8. Glass Balustrade
2. Grey Field Brick	9. Reconstituted Stone Wall / Plinth
3. Buff Brick	10. Black window frames
4. Green Bronze Frame	11. Black Metal Balustrade
5. Dark Grey Brick	12. Aluminium Louvres
6. Metal Standing Seam	13. Existing facade re-rendered
7. Black Frosted Glass	

P3	23-09-2022	Title Block Formatting	RP	AC
P2	23-09-2022	DT Feedback Amendments	RP	AC
P1	20-09-2022	First Issue	AK	AC

No	Date	Comments	Drawn	Checked
Revisions				

Issue Status

Preliminary

tp bennett
architecture
interiors
planning

One America Street | London SE1 0NE UK +44 (0) 20 7208 2000 www.tpbenett.com

Project
Market Place Residential
6-9 Sloane Point
Reading

Drawing Title
Proposed Elevations
PLANNING
Sheet 3 of 6

Drawn	Date	Scale @ A1	Alt Ref.
AK	02/08/2022	As indicated	

Project	Originator	Volume	Level	Type	Role Number	Suitability	Revision
A12113 TPB	ZZ	ZZ	ZZ	DR	A 0422	S1	P3


23/09/2022 15:53:33

80m Model Ref: A12113-TPB-ZZ-DR-A0422-S0-P03-1


ECE WESTWORKS
W0821 - Phasing Markup
06/03/25 - Planning Issue



4 0423 - East Elevation
1:100

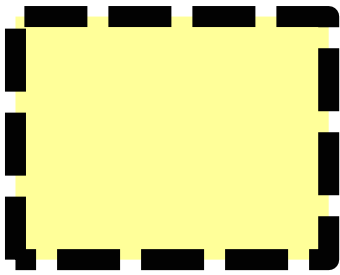


Phase 01 Works

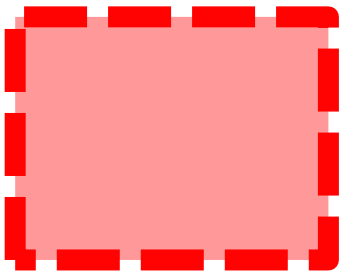

Phase 02 Works

ECE WESTWORKS
W0821 - Phasing Markup
06/03/25 - Planning Issue

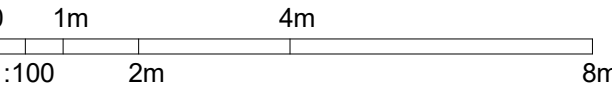

MATERIAL PALETTE											
	1. Georgian Red Brick		8. Glass Balustrade		2. Grey Field Brick		9. Reconstituted Stone Wall / Plinth		3. Buff Brick		10. Black window frames
	3a Buff brick Half tone darker		11. Black Metal Balustrade		4. Green Bronze Frame		12. Aluminium Louvres		5. Dark Grey Brick		6. Metal Standing Seam (Dark grey)
	7. Black Frosted Glass										

CLIENT
Tene Living

STRUCTURAL ENGINEER

SERVICES ENGINEER


CONSULTANT

KEY PLAN


NOTES:
THIS DRAWING IS PROTECTED BY COPYRIGHT.
ALL AREAS HAVE BEEN MEASURED FROM CURRENT DRAWINGS. THEY MAY VARY BECAUSE OF (EG) SURVEY, DESIGN DEVELOPMENT, CONSTRUCTION TOLERANCES, STATUTORY REQUIREMENTS OR RE-DEFINITION OF THE AREAS TO BE MEASURED.

P5	10-01-2023	Material clarification	RP	AC
P4	07-10-2022	Amendment to Core C	RP	AC
P3	23-08-2022	Title Block Formatting	RP	AC
P2	23-08-2022	DT Feedback Amendments	RP	AC
P1	20-08-2022	First Issue	AK	AC


No.	Date	Comments	Drawn	Checked
Revisions				
Issue Status				
Preliminary				
tp bennett				
architecture interiors planning				
One America Street London SE1 0NE UK +44 (0) 20 7208 2000 www.tpbenett.com				
Project				
Market Place Residential 6-9 Sloane Point Reading				
Drawing Title				
Proposed Elecations PLANNING Sheet 4 of 6				
Drawn	Date	Scale @ A1	Alt Ref.	
AK	16/08/2022	As indicated		
Project	Originator	Volume	Level	File Number
A12113 TPB	ZZ	ZZ	DR A	0423 S1 P5

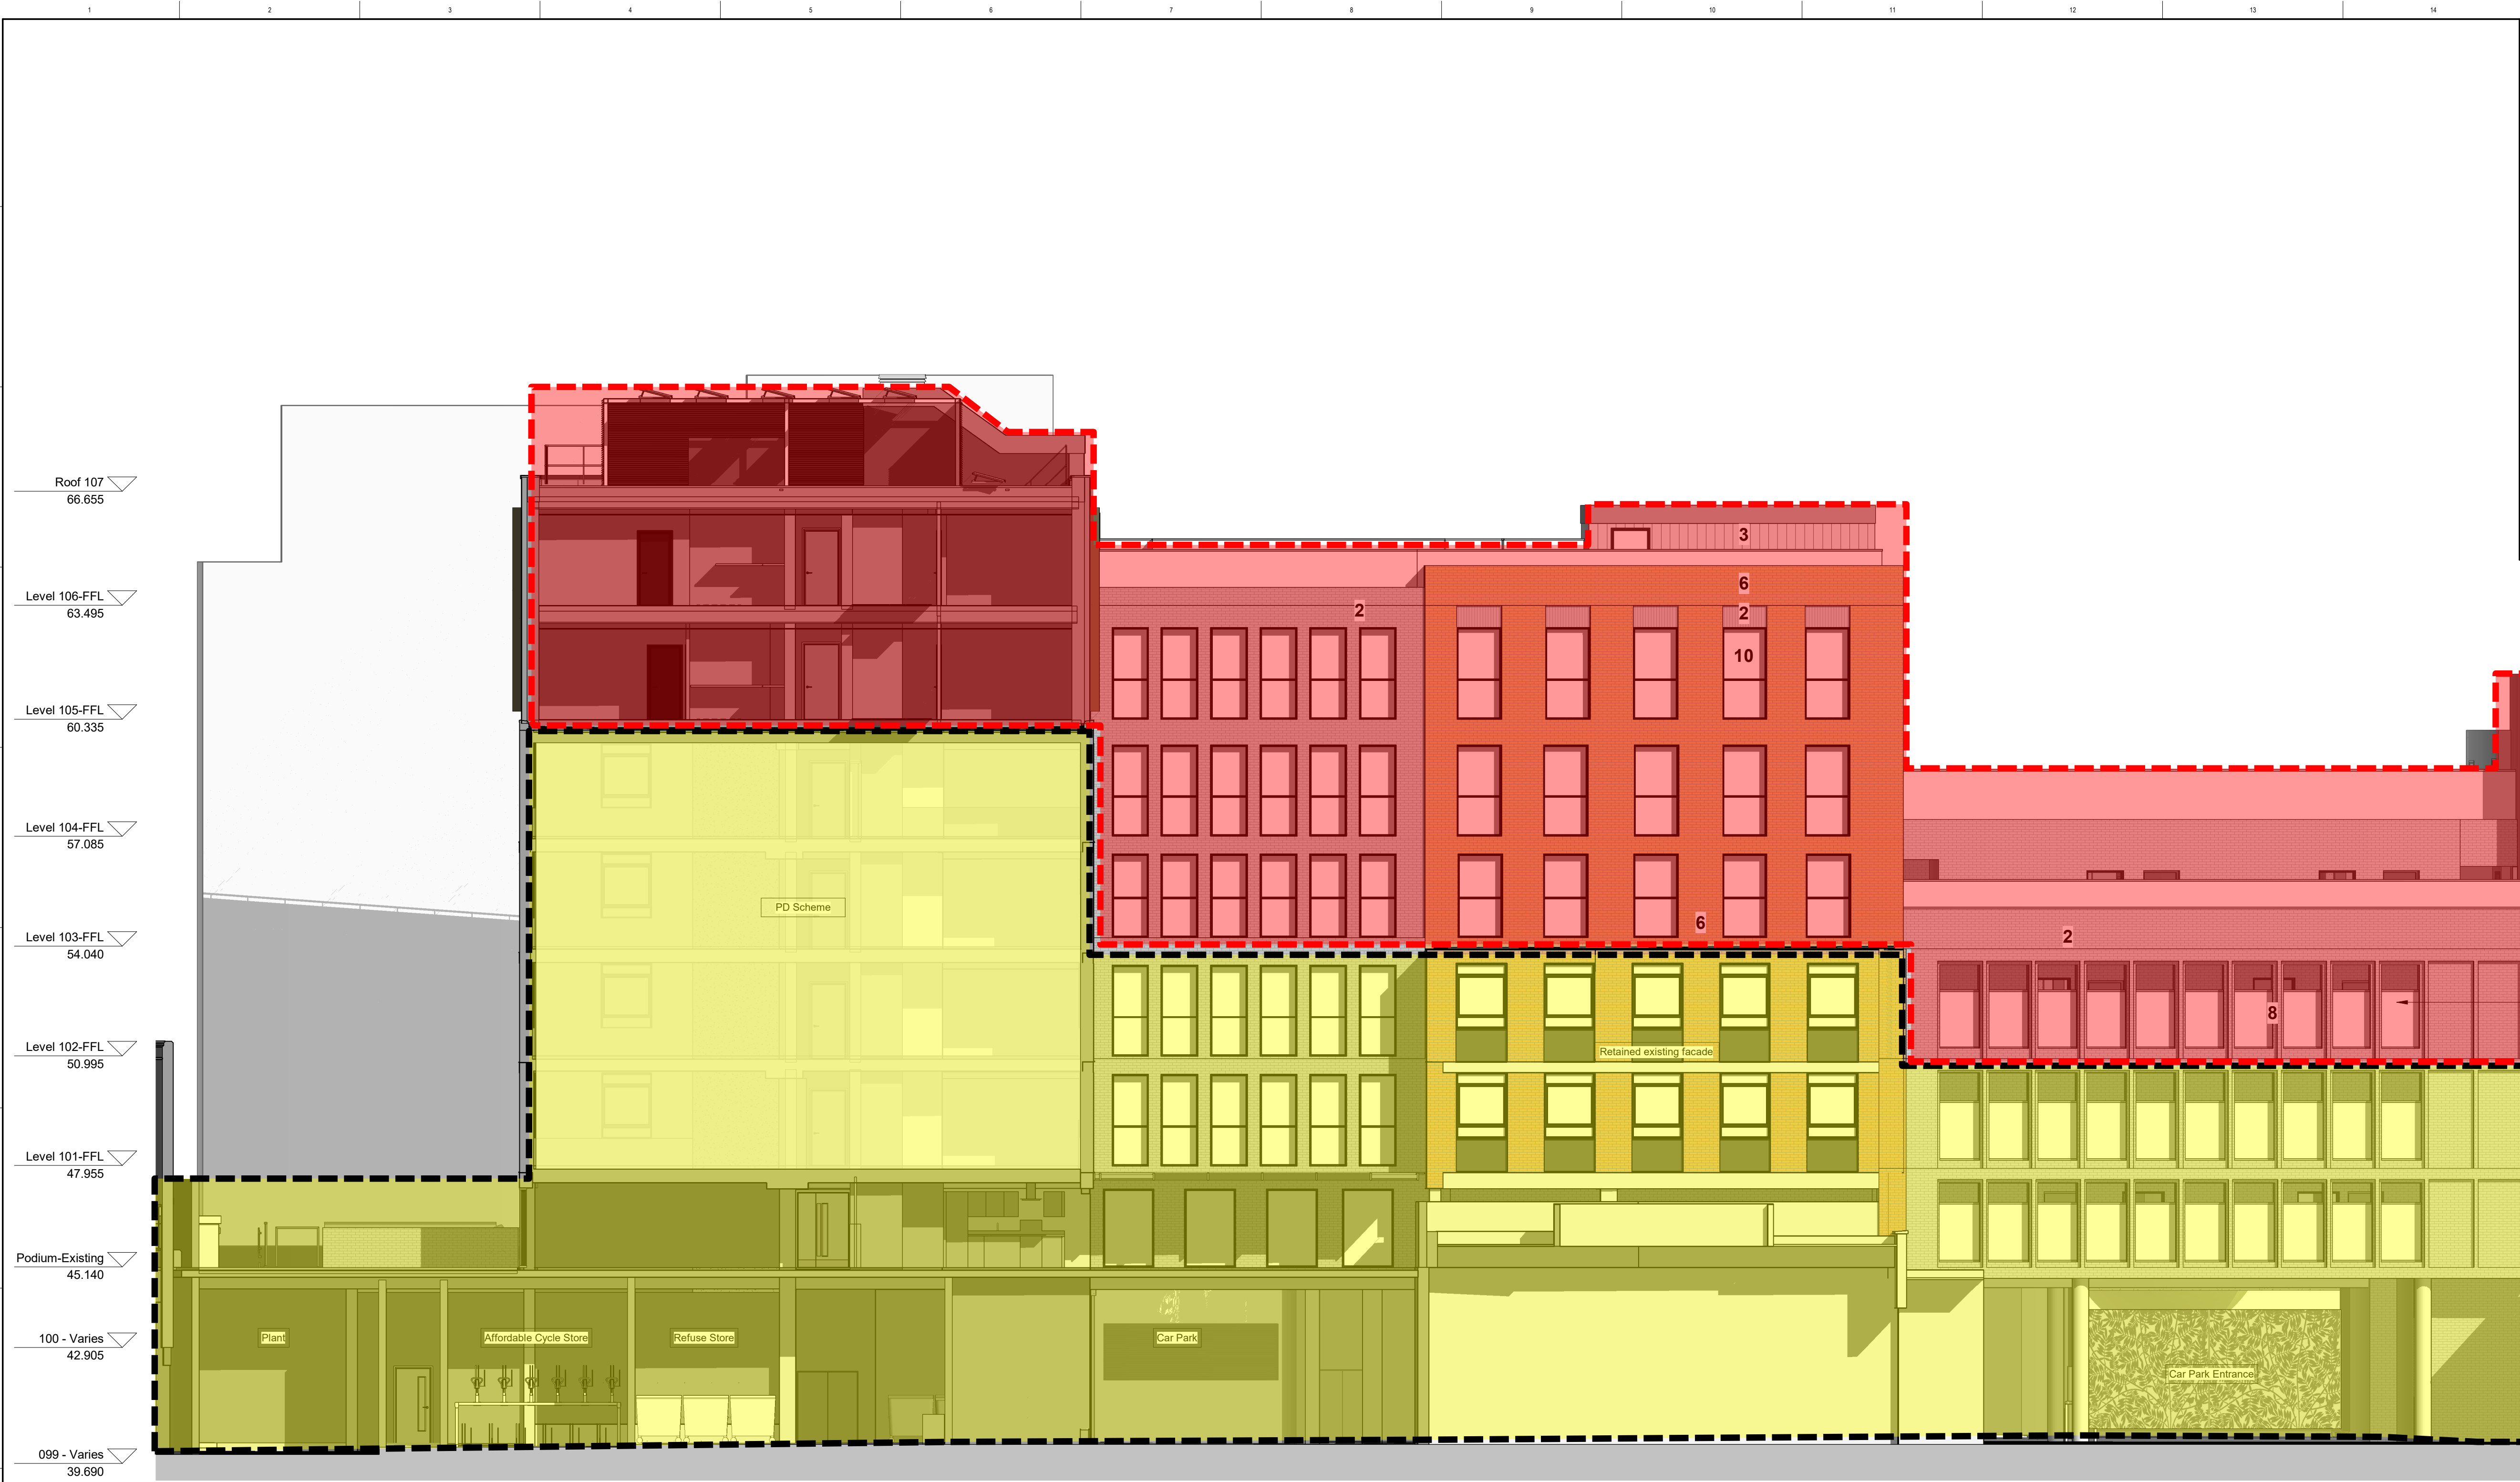

6 0425 - Interior - West Elevation
1:100

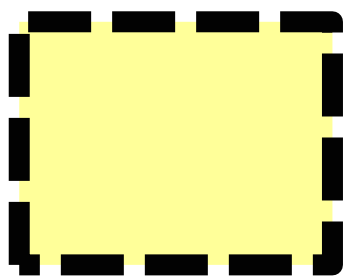

Phase 01 Works

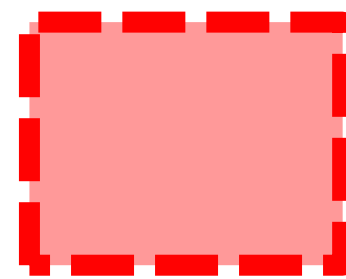

Phase 02 Works

ECE WESTWORKS
W0821 - Phasing Markup
06/03/25 - Planning Issue

MATERIAL PALETTE				
	1. Georgian Red Brick		8. Glass Balustrade	
	2. Grey Field Brick		9. Reconstituted Stone Wall / Plinth	
	3. Buff Brick		10. Black window frames	
	4. Green Bronze Frame		11. Black Metal Balustrade	
	5. Dark Grey Brick		12. Aluminium Louvres	
	6. Metal Standing Seam		13. Existing facade re-rendered	
	7. Black Frosted Glass			

CLIENT
Tene Living

STRUCTURAL ENGINEER

SERVICES ENGINEER

CONSULTANT

KEY PLAN

NOTES:
THIS DRAWING IS PROTECTED BY COPYRIGHT.
ALL AREAS HAVE BEEN MEASURED FROM CURRENT DRAWINGS. THEY MAY VARY BECAUSE OF (EG) SURVEY, DESIGN DEVELOPMENT, CONSTRUCTION TOLERANCES, STATUTORY REQUIREMENTS OR RE-DEFINITION OF THE AREAS TO BE MEASURED.

No.	Date	Comments	Drawn	Checked
P3	23-08-2022	Title Block Formatting	RP	AC
P2	23-08-2022	DT Feedback Amendments	RP	AC
P1	20-08-2022	First Issue	AK	AC

Revisions

Issue Status

Preliminary

tp bennett
architecture
interiors
planning

One America Street | London SE1 0NE UK +44 (0) 20 7208 2000 www.tpbenett.com

Project
Market Place Residential
6-9 Sloane Point
Reading

Drawing Title
Proposed Elevations
PLANNING
Sheet 6 of 6

Drawn
AK

Date
16/08/2022

Scale @ A1
As indicated

Alt Ref.

Project
A12113 TPB ZZ ZZ DR A 0425 S1 P3

Originator
ZZ

Volume
ZZ

Level
ZZ

Type
DR

Roll Number
A 0425

Stability
S1

Revision
P3