



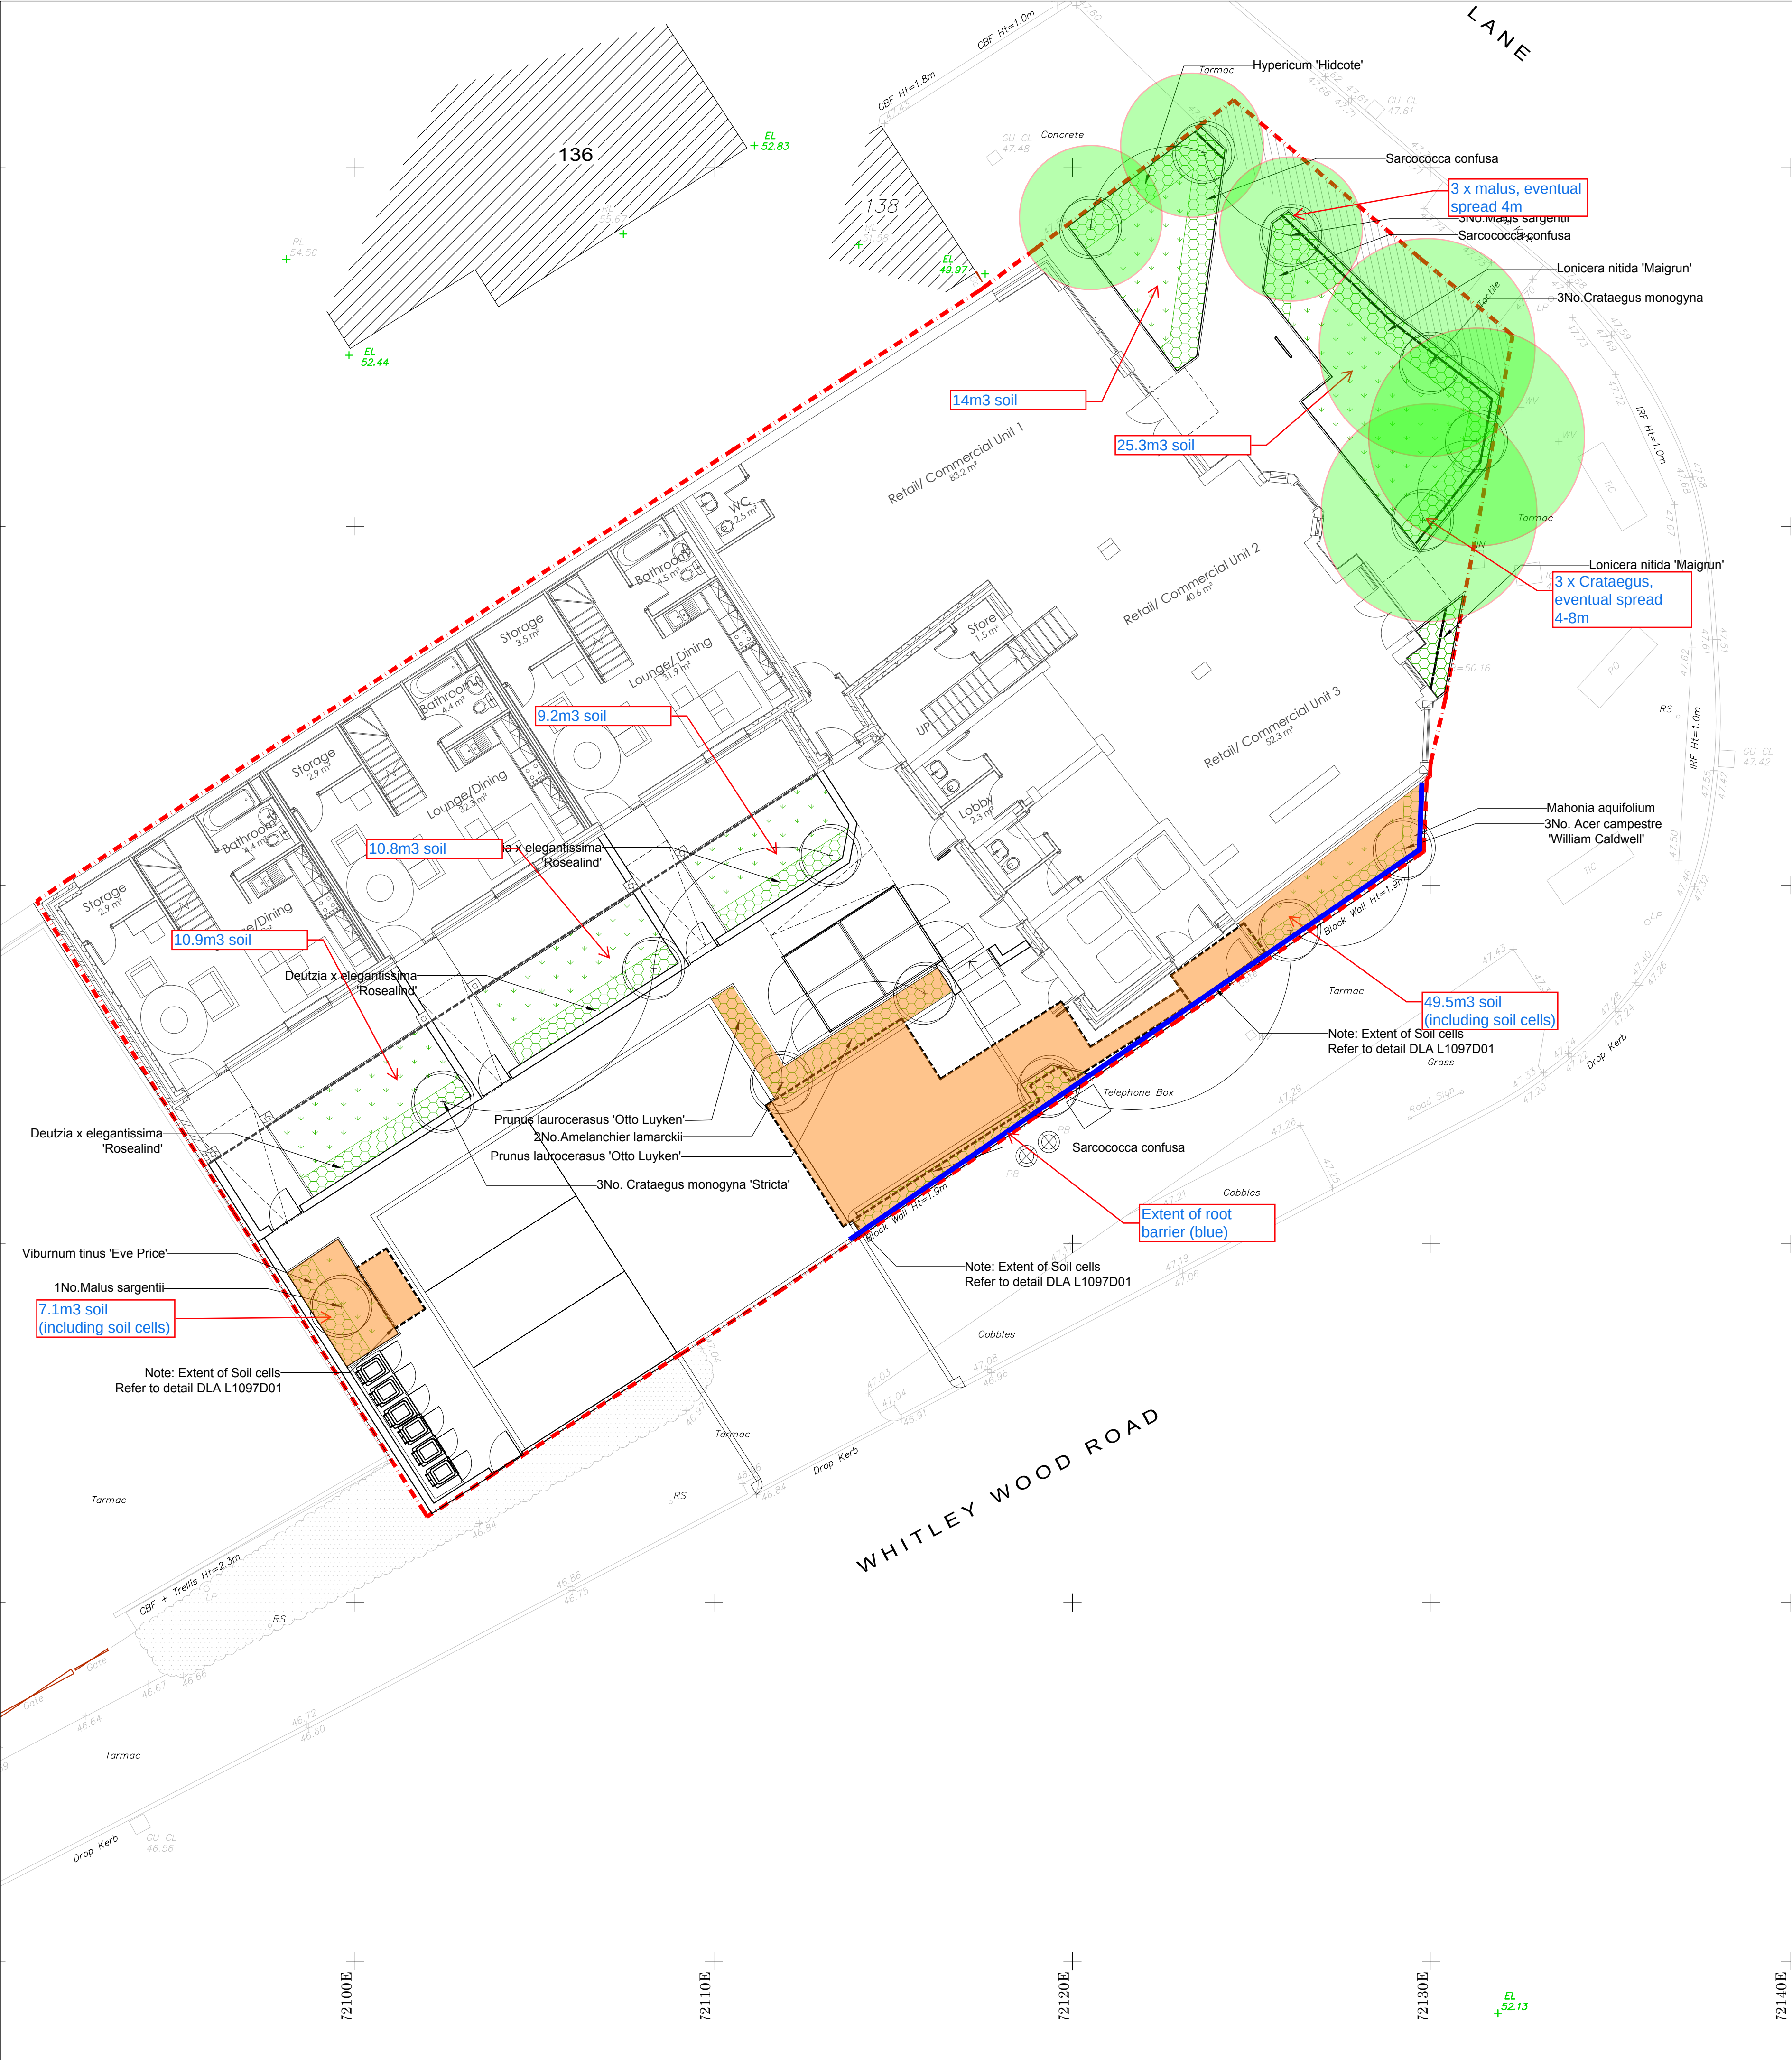


Key:
--- Site Boundary


Proposed Planting:

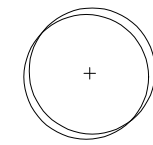

Proposed trees

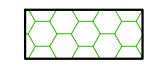

Proposed shrub planting
Refer planting schedule for species and density.

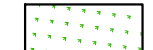

Proposed lawn

General Notes

- Refer to General Arrangement Plan (L1097L01) for proposed levels and materials.


Trees

To be planted in groups of 3-5 number.

Name	Form	Age	Girth (cm)	Height (cm)	Clear stem (cm)	Root cdn.	Habit	Spacing	No.
Acer campestre 'William Caldwell'	Standard (extra heavy)	3x	14-16	400-450	min200	RB	-	as shown	3
Amelanchier lamarckii	Standard (extra heavy)	3x	14-16	400-450	min200	RB	-	as shown	2
Crataegus monogyna	Standard (extra heavy)	3x	14-16	400-450	min200	RB	-	as shown	3
Crataegus monogyna 'Stricta'	Standard (extra heavy)	3x	14-16	400-450	min200	RB	-	as shown	3
Malus sargentii	Standard (heavy)	3x	14-16	350-425	175-200	RB	-	as shown	4

Shrubs

To be planted in groups of 3-5 number.

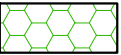

Name	Height (cm)	Root cdn.	Cont. size	Habit	Breaks	Spacing
Deutzia x elegantissima 'Rosealind'	40-60	C	3 L	Branched	4	5/m2
Hypericum 'Hidcote'	30-40	C	3 L	Bushy	5	5/m2
Lonicera nitida 'Maigrun'	30-40D	C	3 L	Bushy	6	5/m2
Mahonia aquifolium	30-40	C	3 L	Branched	3	5/m2
Prunus laurocerasus 'Otto Luyken'	30-40D	C	3 L	Bushy	3	5/m2
Sarcococca confusa	20-30	C	3 L	Bushy	6	5/m2

All planting to be carried out at appropriate time within the first planting season post completion and maintained for a period of up to 5 years to ensure successful establishment.

Recommended planting times.

Wildflower / Lawn seed mix - First sow (April to June) / Secondary (August - September)

- Container Grown Planting - All year round (except during periods of frosts)

- Bareroot / Rootball Stock - November (After first frost) - March

It is the contractor's responsibility to check for services in this area before groundworks commence.

NOTES:

1. This drawing is to be read in conjunction with all relevant contract documentation from the design team, with any conflicting information to be brought to the attention of Davis Landscape Ltd in writing before commencing on site.

2. The contractor is to check and verify all levels and dimensions before construction. Any discrepancies are to be brought to the attention of Davis Landscape Ltd in writing before commencing on site.

3. All dimensions in mm, unless otherwise stated.

4. Do not scale from this drawing.

5. All sub base and concrete specification, fixings, brackets & the like to Engineers' details & specification.

6. We are not liable for the detailed design of above ground drainage, ground drainage, sub-bases, foundations, retaining structures, fall from height barriers and building waterproofing details.

7. All proprietary products shall be installed in accordance with manufacturers written instructions.

8. Submit Shop drawings for Davis Landscape Ltd approval before constructing any bespoke landscape item.

FOR CONDITIONS

Rev	Description	Date	By
A	Updated to team comments	12/06/25	BA

Davis Landscape Architecture
15 Iliffe Yard, London, SE17 3QA
020 7277 1035
mail@davisla.com | www.davisla.com

Client
Whitley Wood Properties Ltd

Job Title
Whitley Wood Lane, Reading

Drawing Title
Planting Plan **Markup**

Scale : 1:100@A1 Drawn : BA

Date : 18/01/25 Checked : JD

Drawing No. : **L1097SK03** Rev. : A

Scale

