




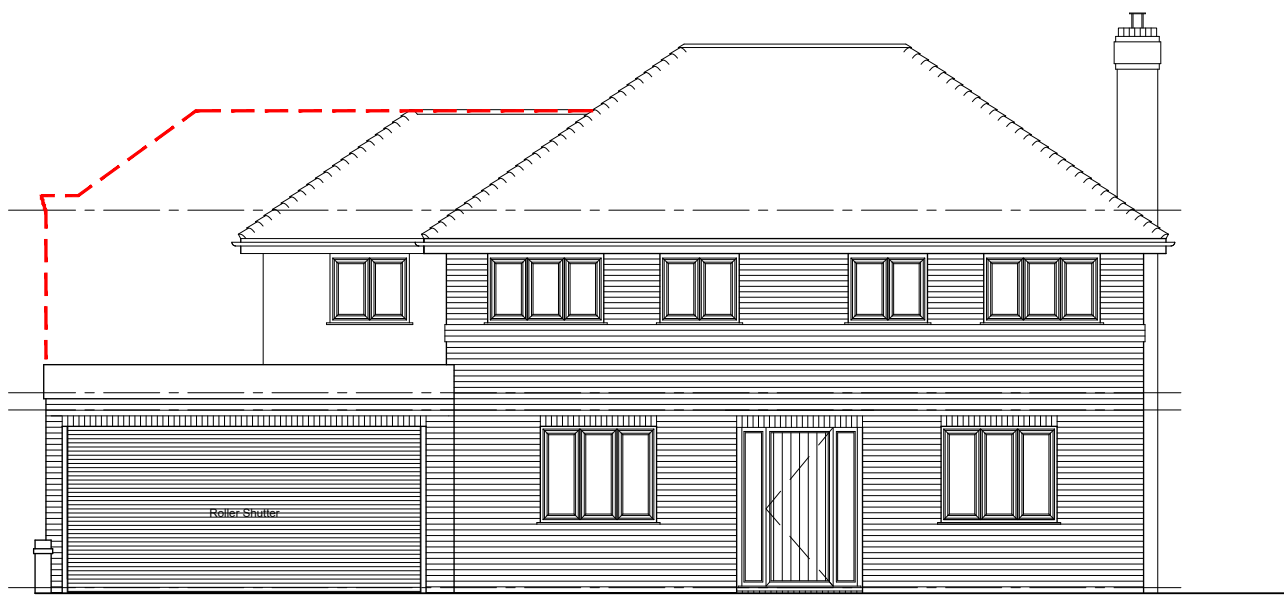


FRONT ELEVATION
EXTERNAL ELEVATIONS As Proposed (outline of previous approved scheme: PL/25/0244 in dashed red line)
Scale 1:100

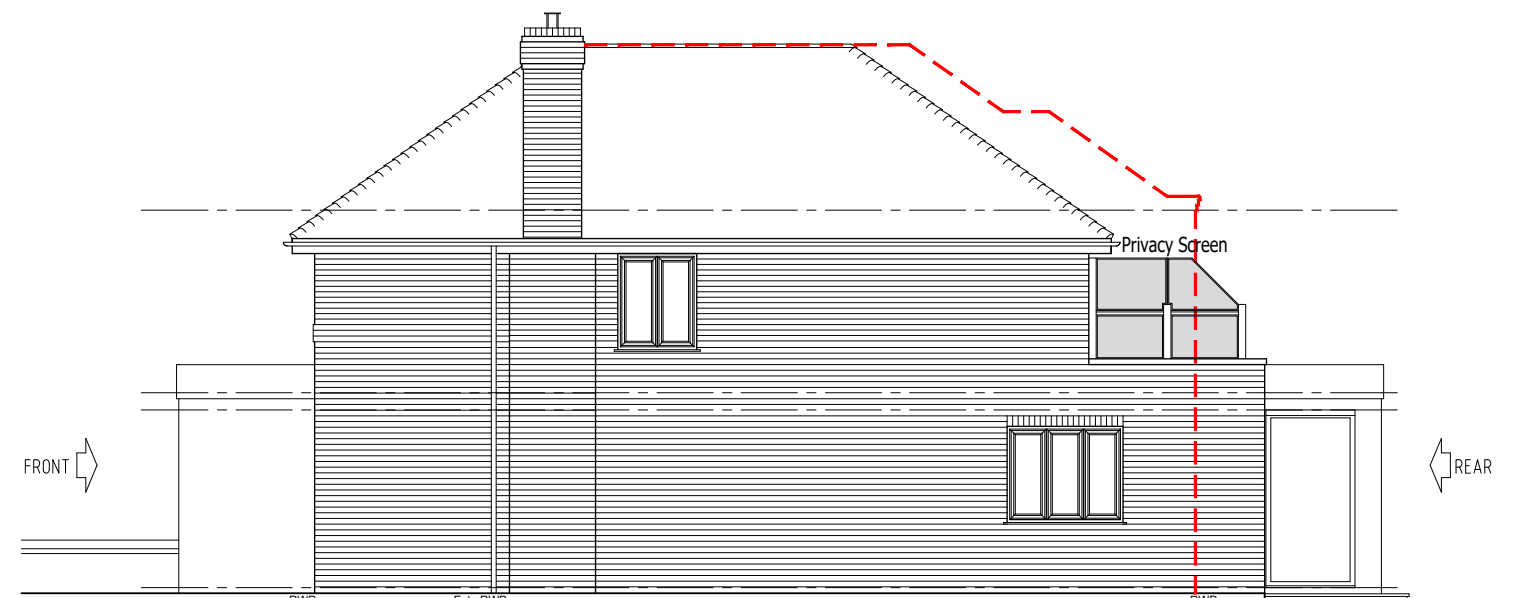

SIDE ELEVATION

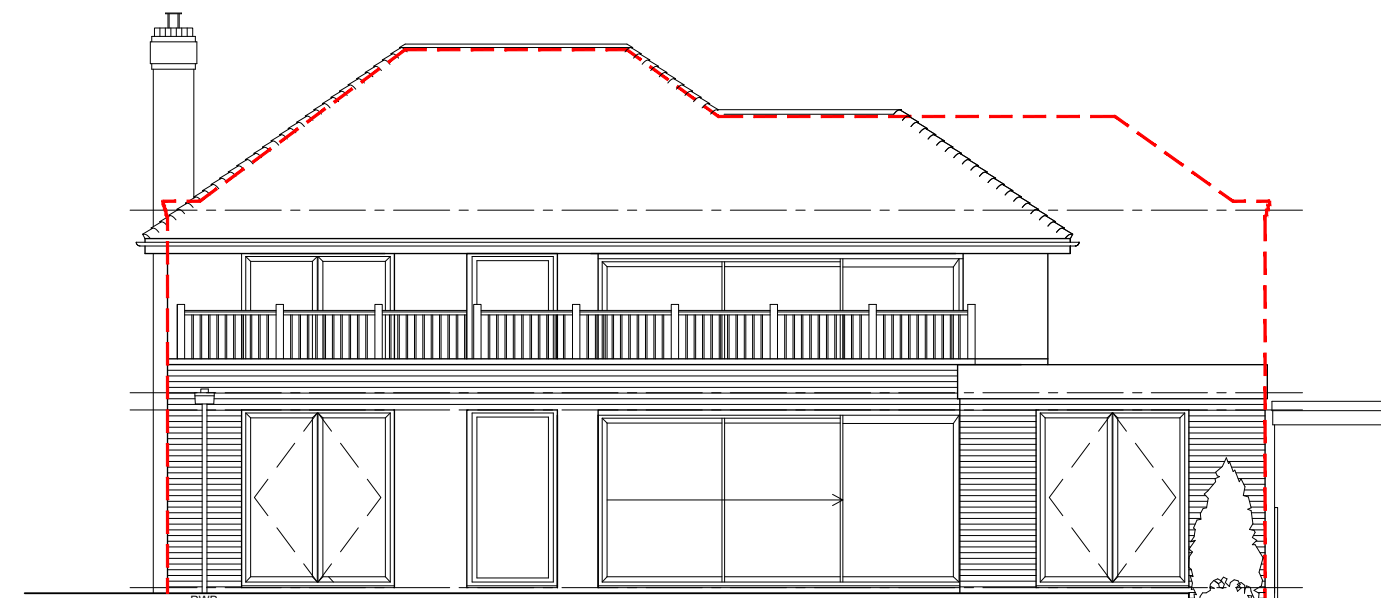

REAR ELEVATION

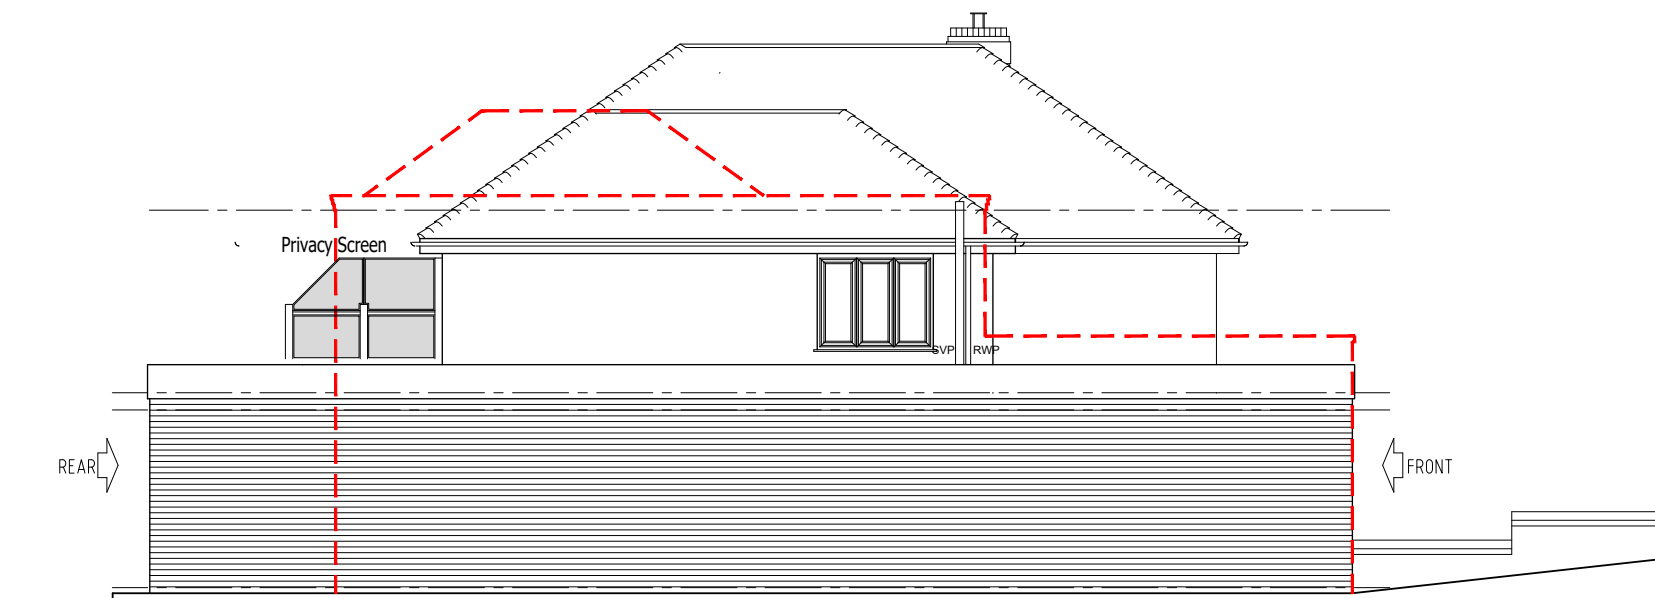


SIDE ELEVATION




FRONT ELEVATION
EXTERNAL ELEVATIONS As Approved
Scale 1:100




SIDE ELEVATION

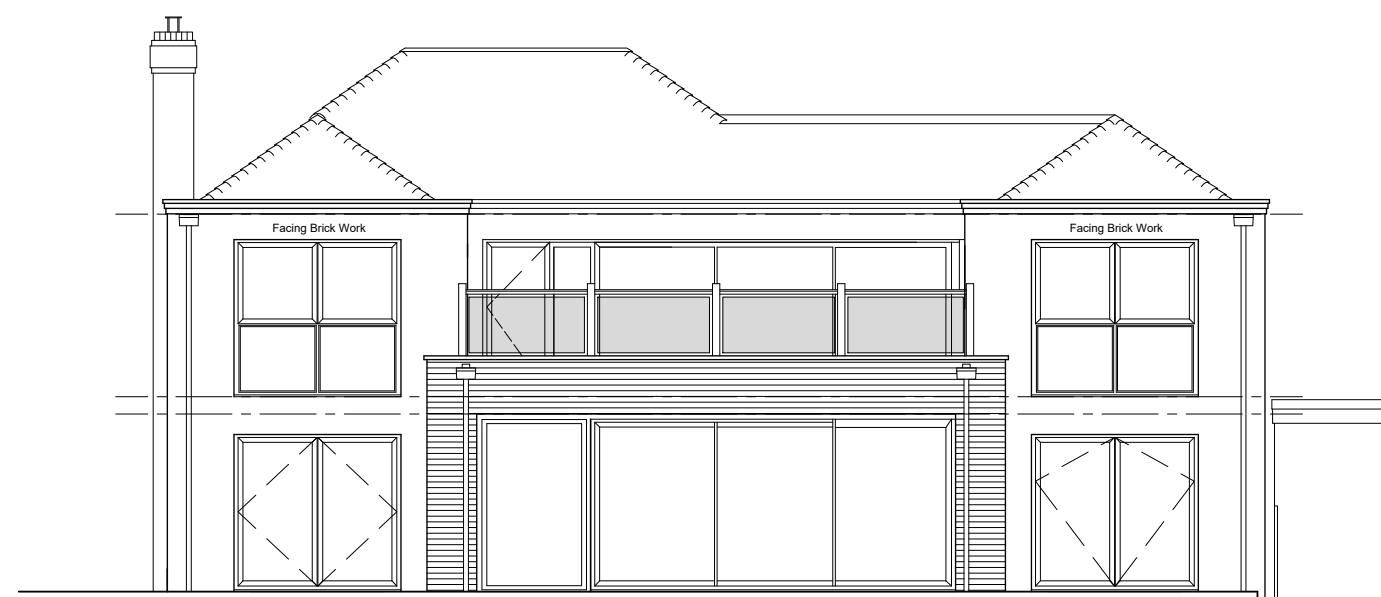


REAR ELEVATION

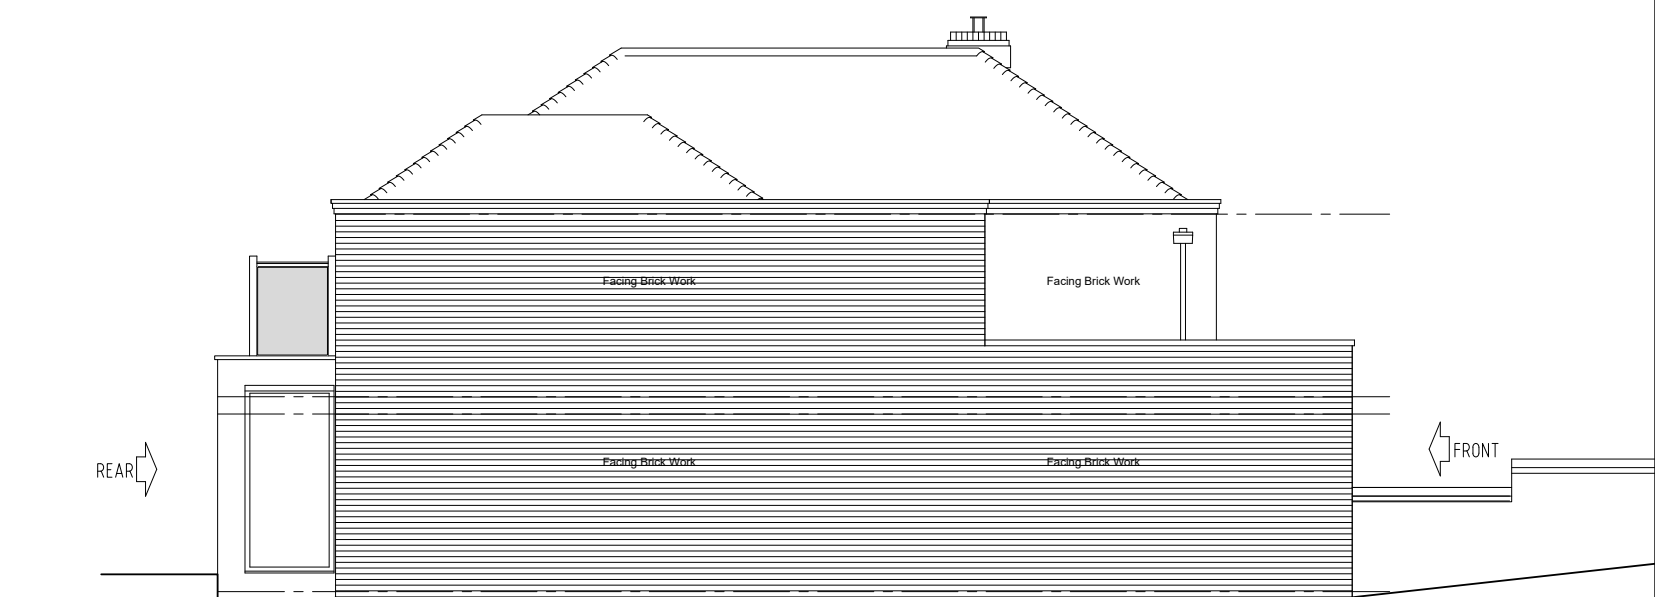

SIDE ELEVATION

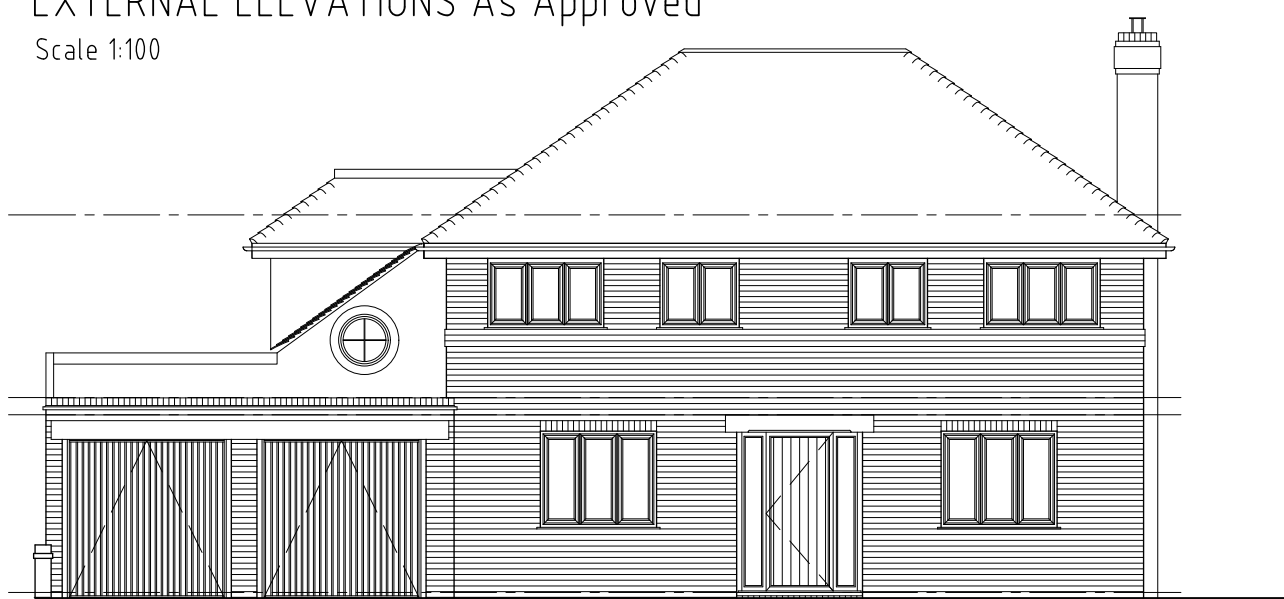


FRONT ELEVATION
EXTERNAL ELEVATIONS As Existing
Scale 1:100

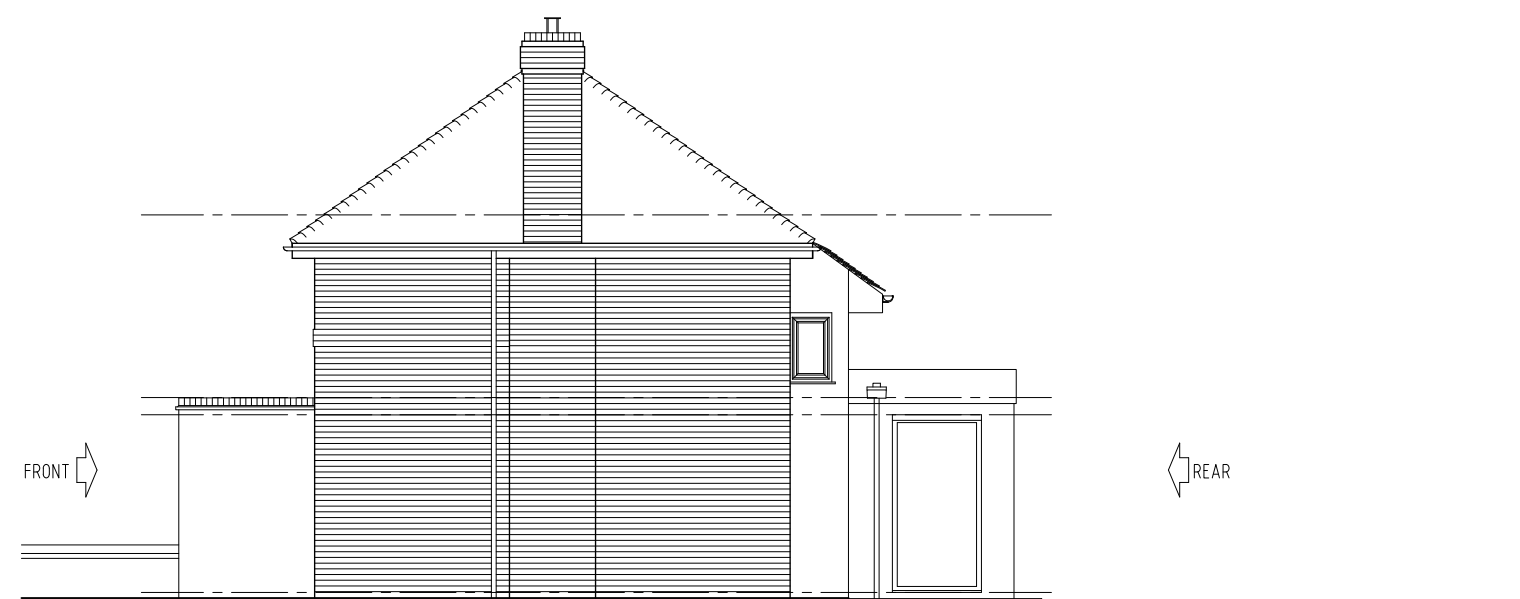


SIDE ELEVATION



REAR ELEVATION

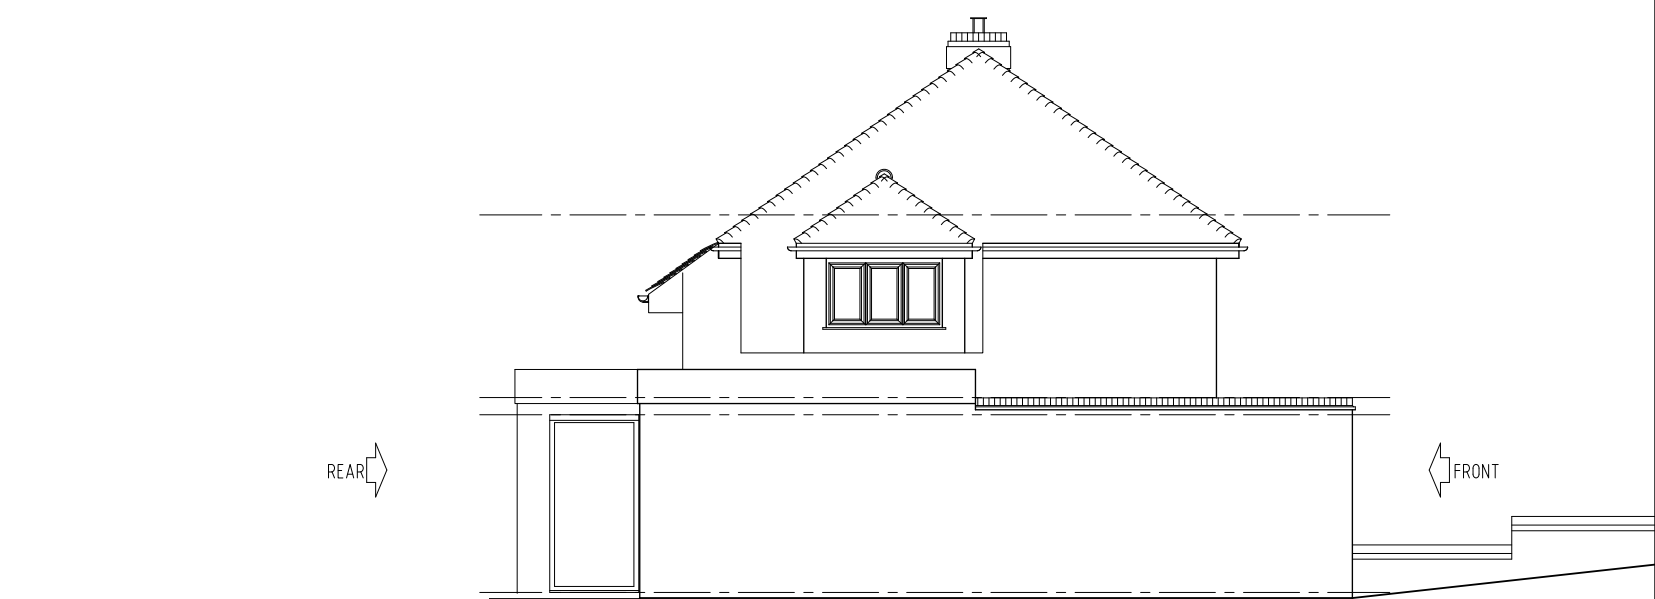

SIDE ELEVATION

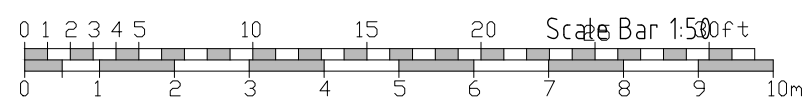

Scale Bar 1:100

All dimensions are to be checked on site before work commences.
Figured dimensions to be taken in preference to scaled dimensions.
If in doubt please ask.
© Copyright reserved.

A	Roof reconfigured/reduced. Terrace revised.	13-04-2026	Initials
Rev	Description	Date	Initials
FOR PLANNING SUBMISSION			
HOLTHAM+NEWMAN ARCHITECTS			
'The Old Dairy' 282a Hyde End Road, Spencer's Wood, Reading, Berkshire, RG7 1DN			
Project: 7, Kelmscott Close Caversham Reading RG4 7DG			
Client Mr. T. Harris			
Drawing Title: External Elevations Front, Rear and Sides			
As Existing and Proposed			
Scale:	1:100 @ A1	Dwg. No.:	2437-P123
Drawn by:	DH	Date:	Jan 2026
			Rev.: A