TRAFFIC MANAGEMENT PLAN - 16.50M ARTICULATED VEHICLE (DRIVE IN AND OUT)

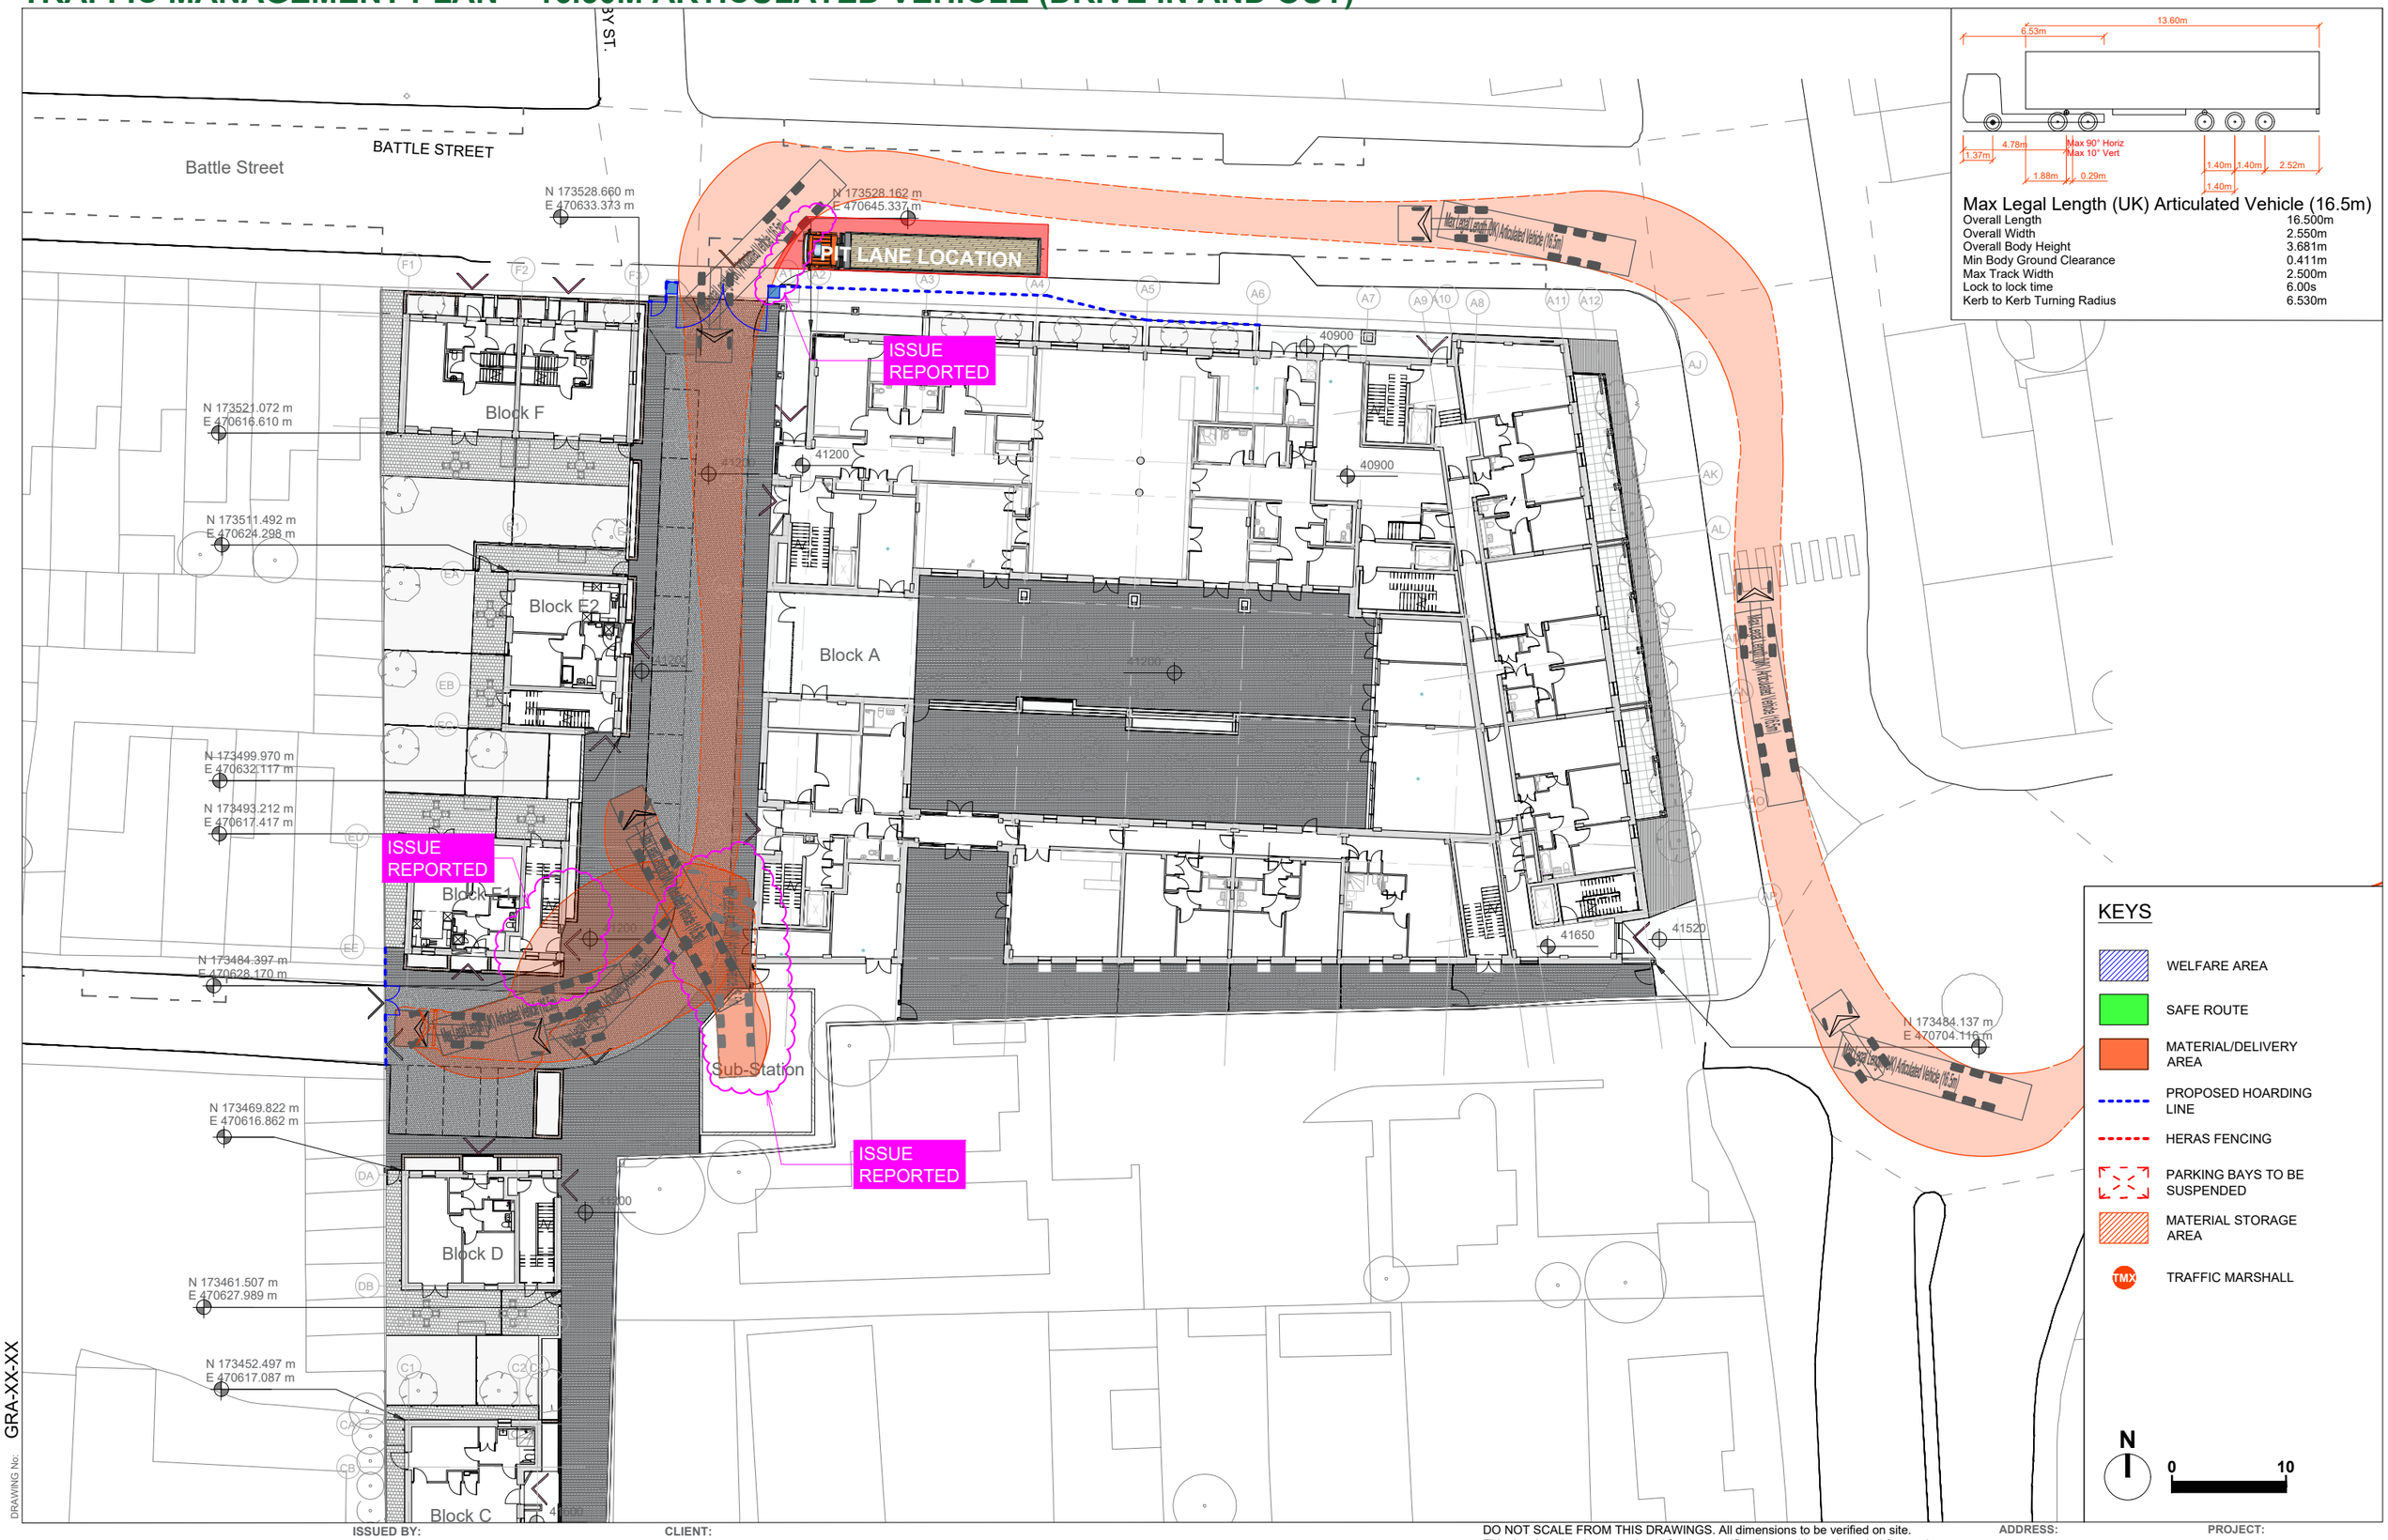

DRAWING No: GRA-XX-XX

A3 29.7 x 42 cm

ISSUED BY:

LLS LOGISTICS
1 New St,
London EC2M 4TP
020 3146 0350
llslogistics.co.uk

CLIENT:

GRAHAM
2nd Floor, South
11 Old Jewry, London
EC2R 8DU
02076008500
www.graham.co.uk

DO NOT SCALE FROM THIS DRAWINGS. All dimensions to be verified on site.
This drawings has been produced for the specific client and is not intended for use by any other person or for any other purpose.
Copyrights of this drawing used to mark up reside with the architects who created them.

NOTE: PDF drawings used for LLS to be marked up only.

ADDRESS:
GRAHAM GROUP
BATTLE STREET, READING

PROJECT:
LOGISTICS PLAN
TRAFFIC PLAN - 16.50M ARTICULATED VEHICLE DRIVE IN/OUT

REVISION: XX/XX

DATE: 10/07/2026