

All dimensions are to be checked on site before work commences.
Figured dimensions to be taken in preference to scaled dimensions.
If in doubt please ask.
© Copyright reserved.



FRONT ELEVATION As Constructed
Scale 1:100



SIDE ELEVATION As Constructed
Scale 1:100



FRONT ELEVATION As Approved
Scale 1:100




SIDE ELEVATION As Approved
Scale 1:100



FRONT ELEVATION As Existing
Scale 1:100



SIDE ELEVATION As Existing
Scale 1:100

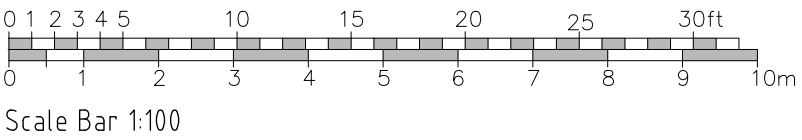

Extent of planning approved scheme design is denoted in a blue dashed line to assist comparison measures.

A	Parapet Wall to Extension raised. Site Dims. added	25-08-2026	DH
Rev	Description	Date	Initials
FOR PLANNING SUBMISSION			
HOLTHAM+NEWMAN ARCHITECTS			
The Old Dairy 282a Hyde End Road, Spencer's Wood, Reading, Berkshire RG7 1DN			
T: 07971 316499 E: hello@hnarchitects.co.uk			
Project: 29, St Annes Road Caversham Reading RG4 7PA			
Client Farhan Ahmad			
Drawing Title: External Elevations Front and Side Views Elevation Sheet 2 of 2 As Existing, Approved and Constructed			
Scale:	1:100 @ A1	Dwg. No.:	Rev.:
	-	2407-P114	A
Drawn by:	DH		
Date:	Aug 2026		